

COUNTY SURVEYORS FILE DATA  
DO NOT REMOVE FROM OFFICE

SURVEY LOCATED IN  
N.E. 1/4, S.E. 1/4, SEC 14, T 22S, R 12W, W.M.  
DOUGLAS COUNTY, OREGON

SURVEY FOR:

JACK WALKER  
70 DAVID R. ANDERSON  
P.O. Box 238  
REEDS PORT, OR 97467

SURVEY BY:


STUNTZNER ENGINEERING & FORESTRY  
P.O. Box 118  
COOS BAY, OR 97420

FILED ✓  
RECEIVED ✓

MAY 30 1979

COUNTY SURVEYOR  
DOUGLAS COUNTY, ORE  
W

MAP FILE M 77-41

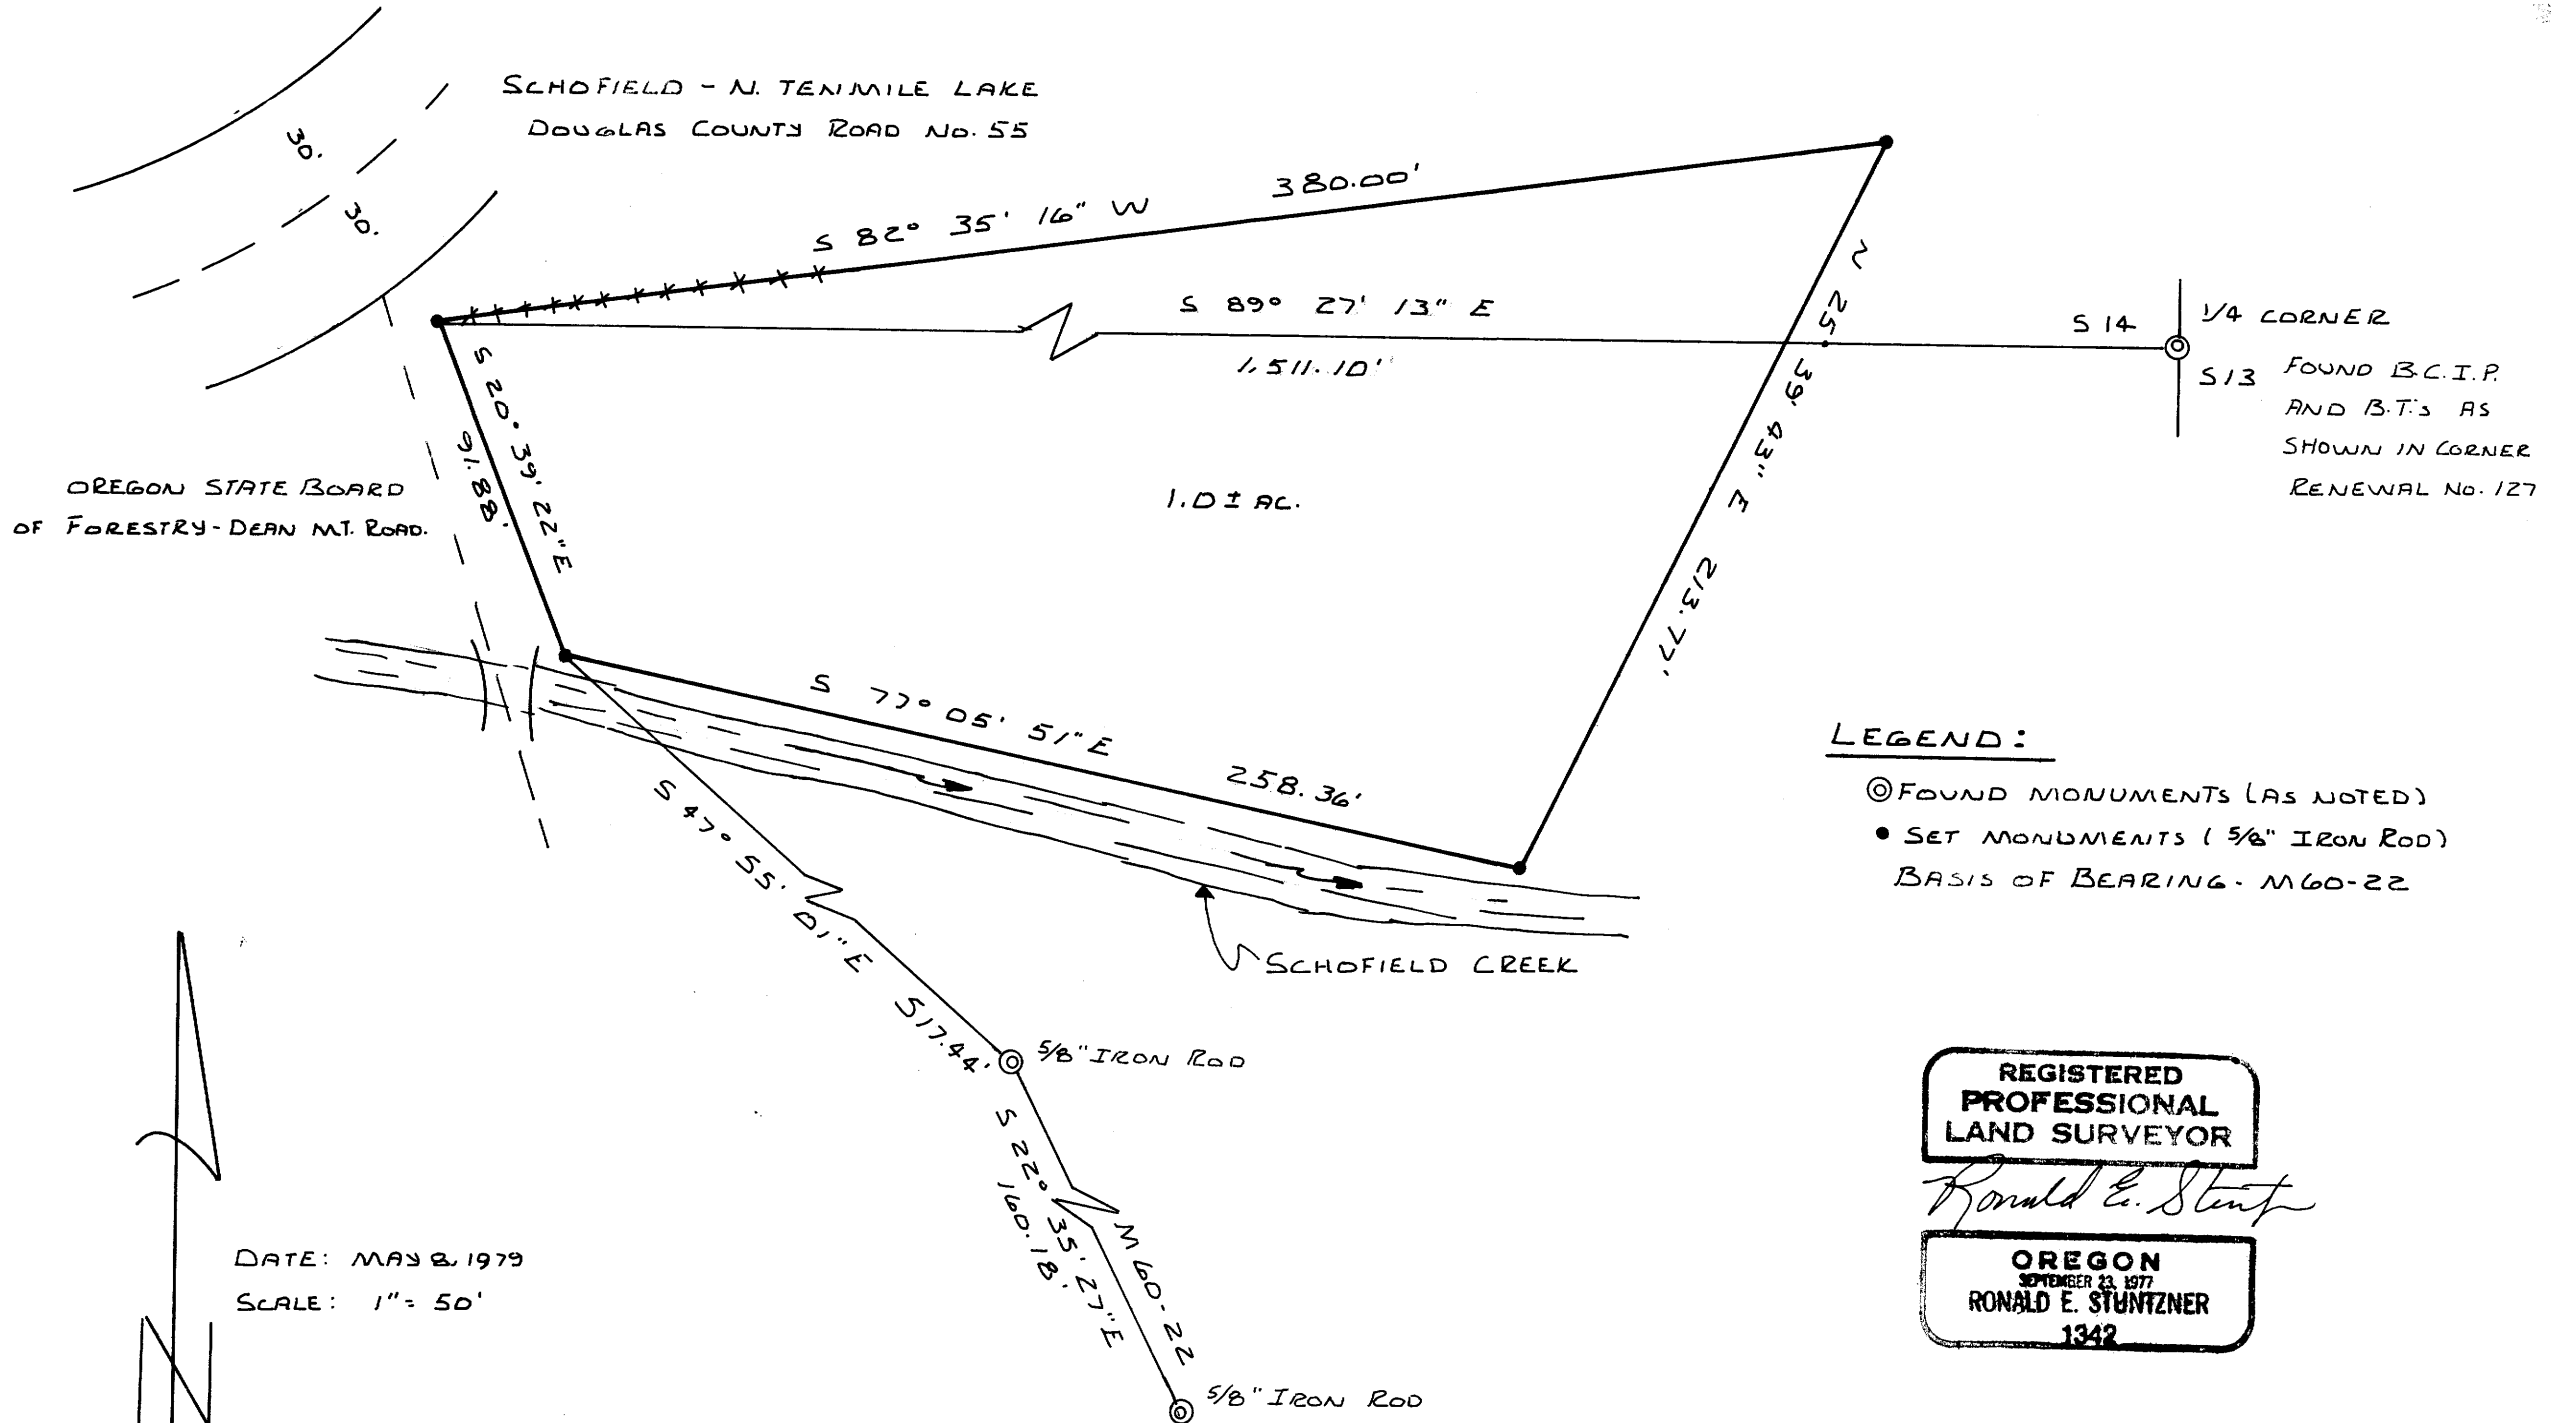

LEGEND:

- ⊙ FOUND MONUMENTS (AS NOTED)
- SET MONUMENTS ( $5/8"$  IRON ROD)
- BASIS OF BEARING - M60-22

REGISTERED  
PROFESSIONAL  
LAND SURVEYOR

*Ronald E. Stuntzner*

OREGON  
SEPTEMBER 23, 1977  
RONALD E. STUNTZNER  
1342

MAP FILE M 77-41