

PROPERTY SURVEYORS FILE DATA
DO NOT REMOVE FROM OFFICE

SURVEY FOR PROPERTY CORNERS

IN SECTION 19, T.27S.R.5W.W.M. - LOTS 25 & 26 BLOCK 1
BOGARD ADDITION TO CITY OF ROSEBURG

FOR: PRICE
BY: HERMAN A. PIESKE


JUNE 1979 --- SCALE: 1"=40'

FILED *J*
RECEIVED *uw*

JUN 8 1979

COUNTY SURVEYOR
TUGGLAS COUNTY, ORE.

TB

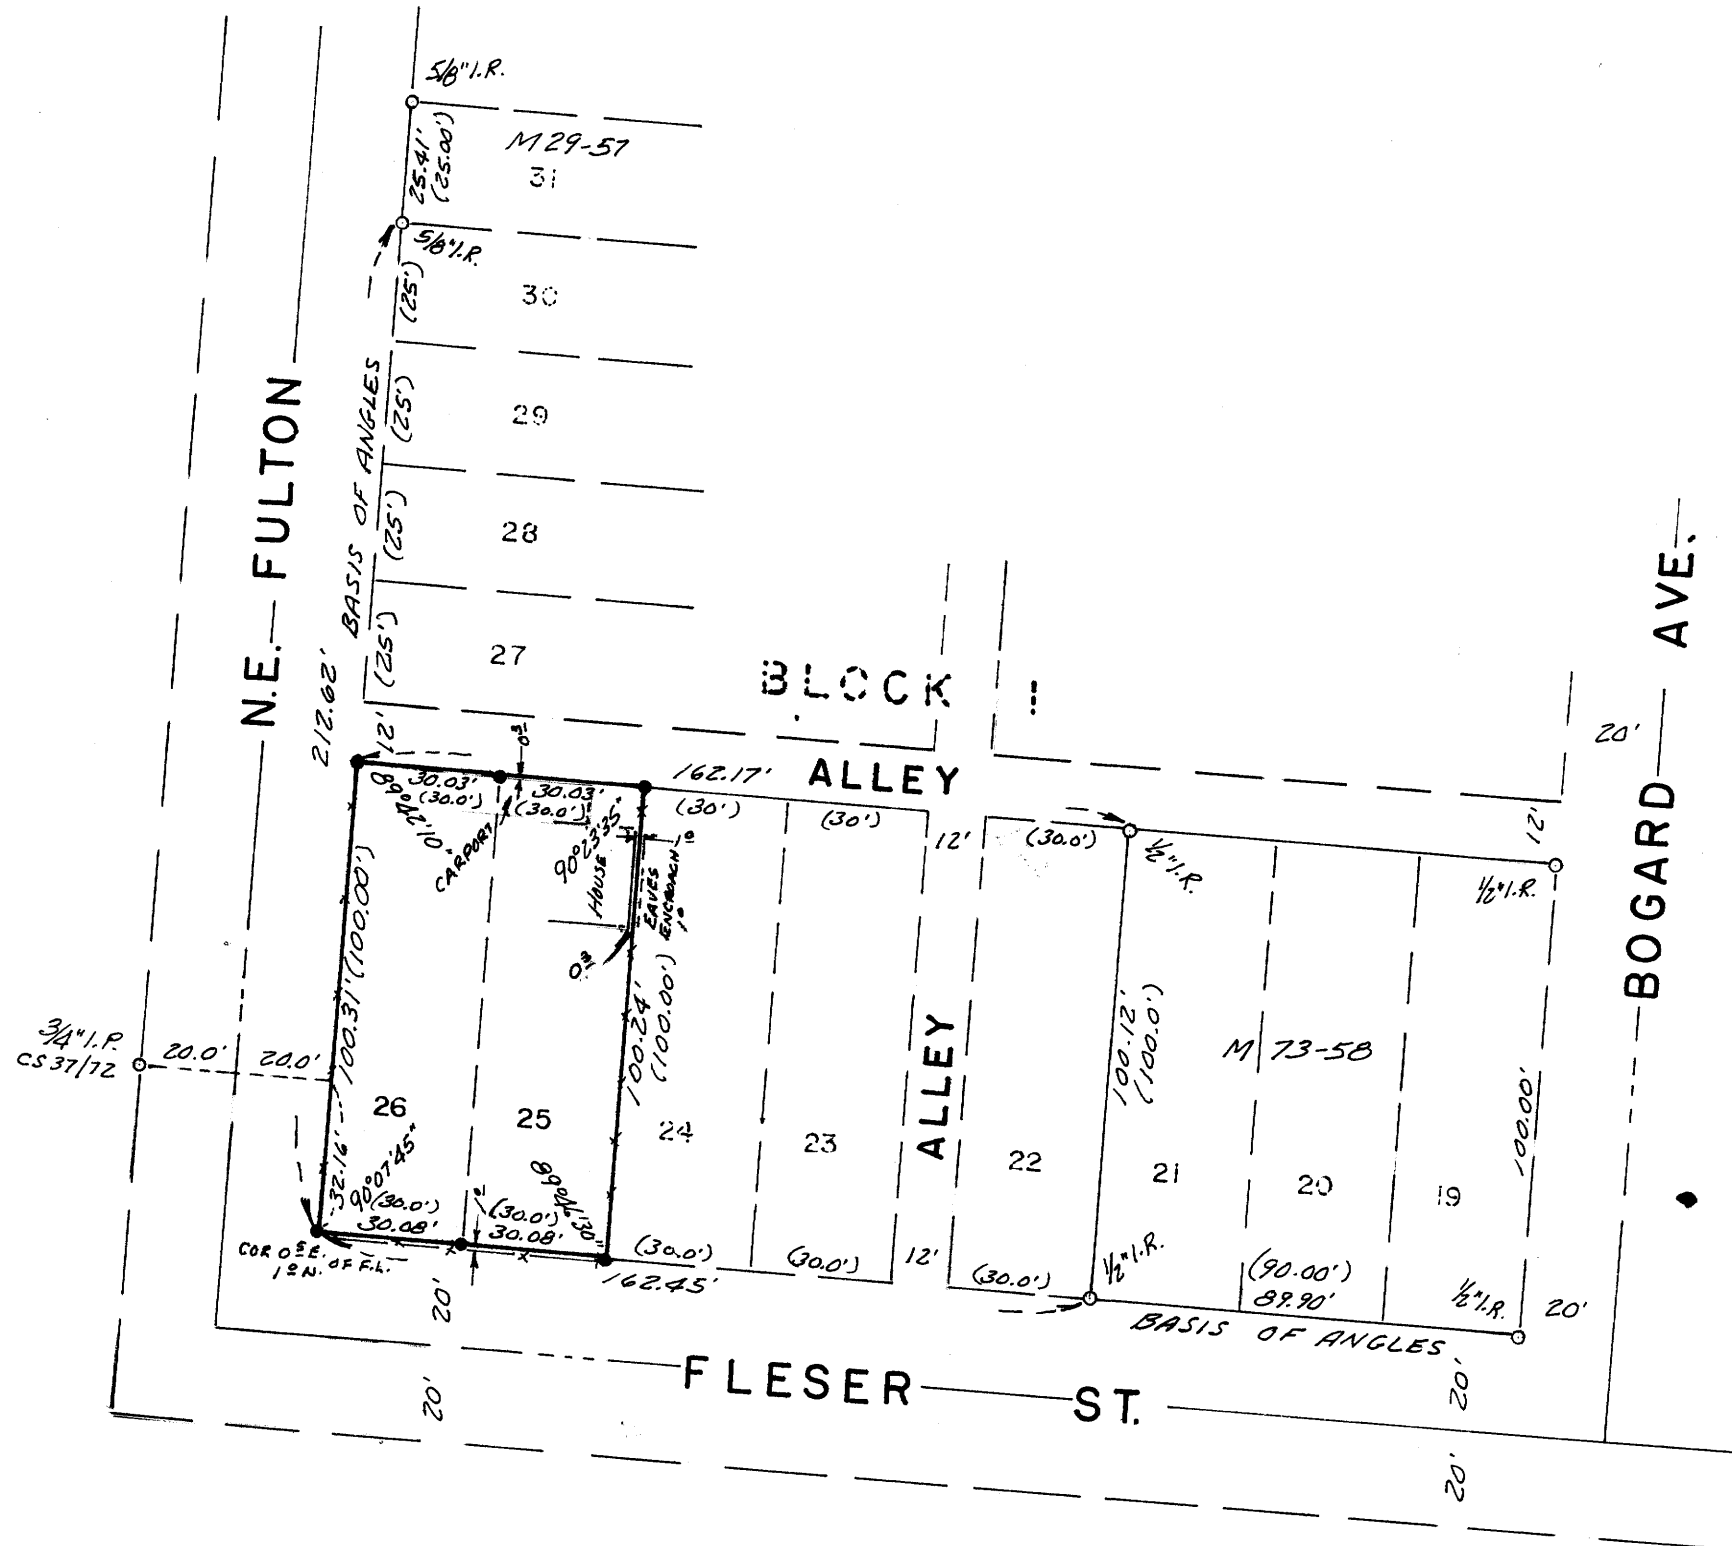

REGISTERED
PROFESSIONAL
LAND SURVEYOR

Herman A. Pieske

OREGON
JULY 14, 1978
HERMAN A. PIESKE
1651

● — Set 5/8" iron rod

○ — Point found, as noted hereon

MAP FILE M 11-51

MAP FILE M 11-51