

SECT 4, T.23 S., R.5 W. W. M.

John D. + Paulina A. Cousing      youcalla.ore.

Scale = 1" = 20'

MAY 21, 1979

BL. 2 PT. LOT 6 - DEVORE'S ADDN. - YONCALLA

FILED  
RECEIVED


JUN 26 1979

COUNTY SURVEYOR  
DOUGLAS COUNTY, ORE.

JB

Mathis Mill Road

Williams

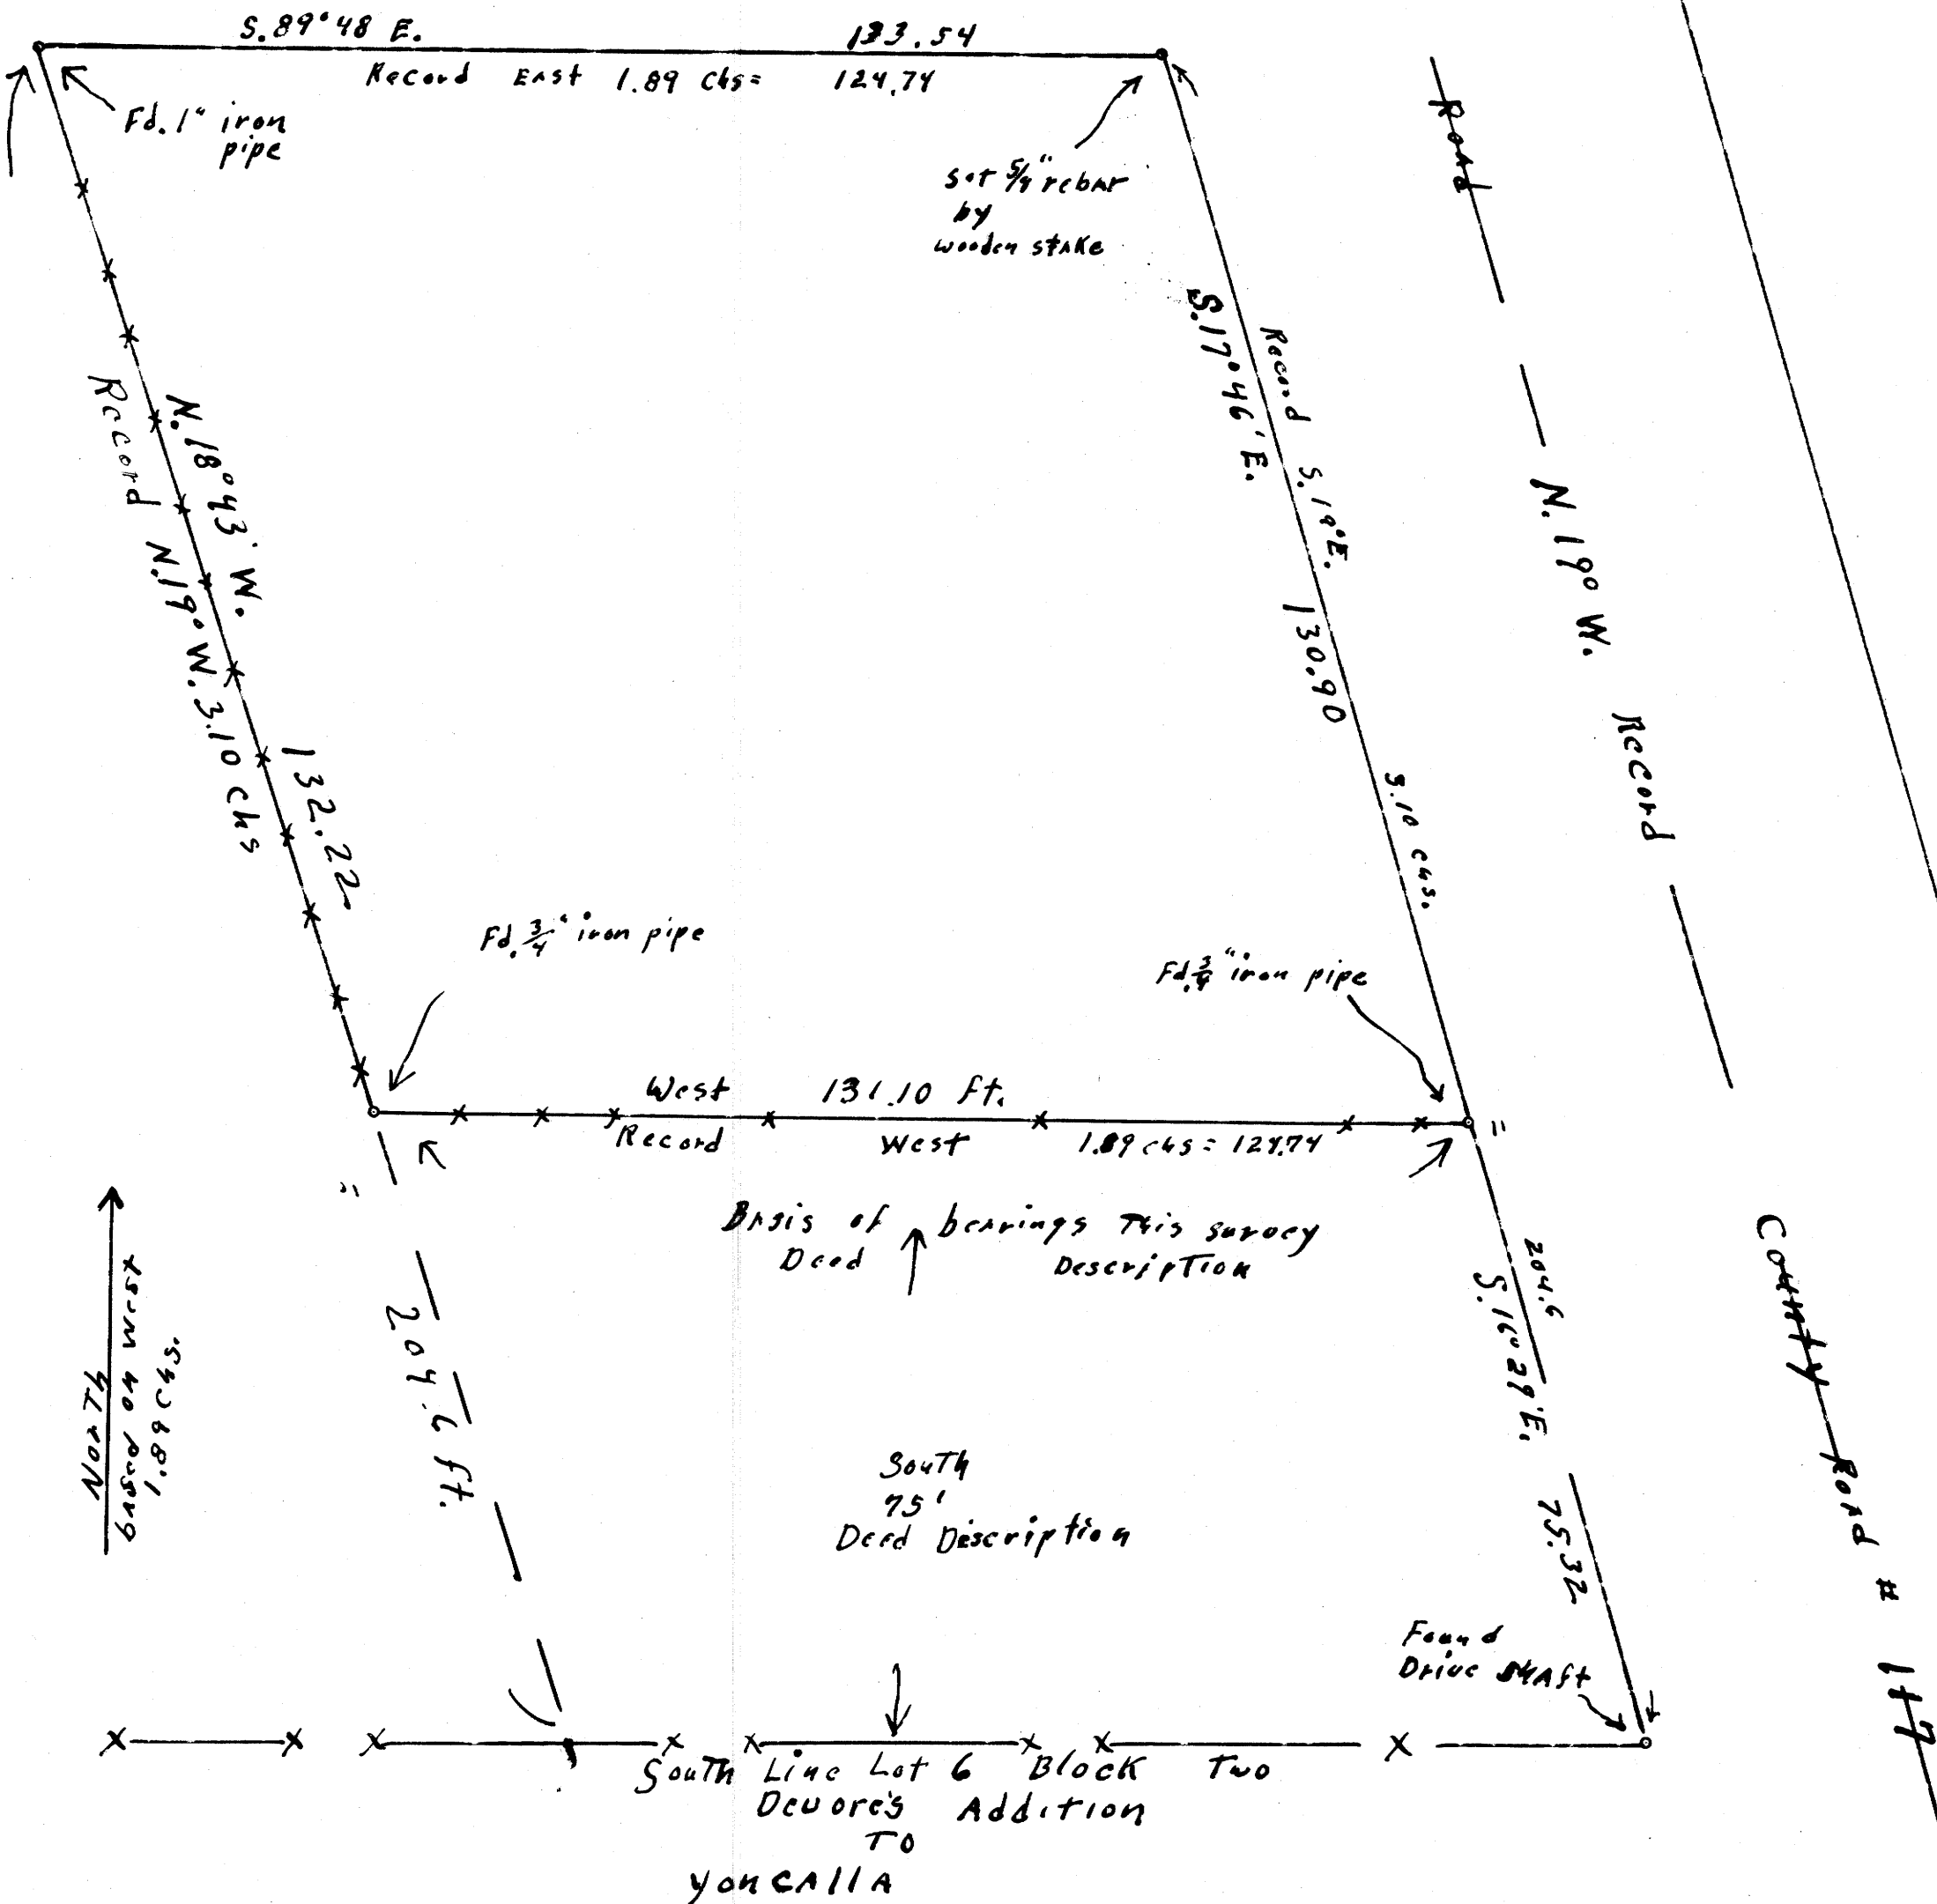

REGISTERED  
OREGON  
LAND SURVEYOR

*Wilford N. Haines*  
MAY 7, 1948  
WILFORD N. HAINES  
239