

COUNTY SURVEYORS FILE DATA  
DO NOT REMOVE FROM OFFICE

# SURVEY TO ADJUST LOT LINE


Between lots 1 & 2, Block 8 Town of Julia. Sec. 5, T. 33S, R. 6W, 12M.  
for Jay Taylor

FILED ✓  
RECEIVED B.S.

JUL 18 1979

COUNTY SURVEYOR  
DELLAS COUNTY, ORE.

DK

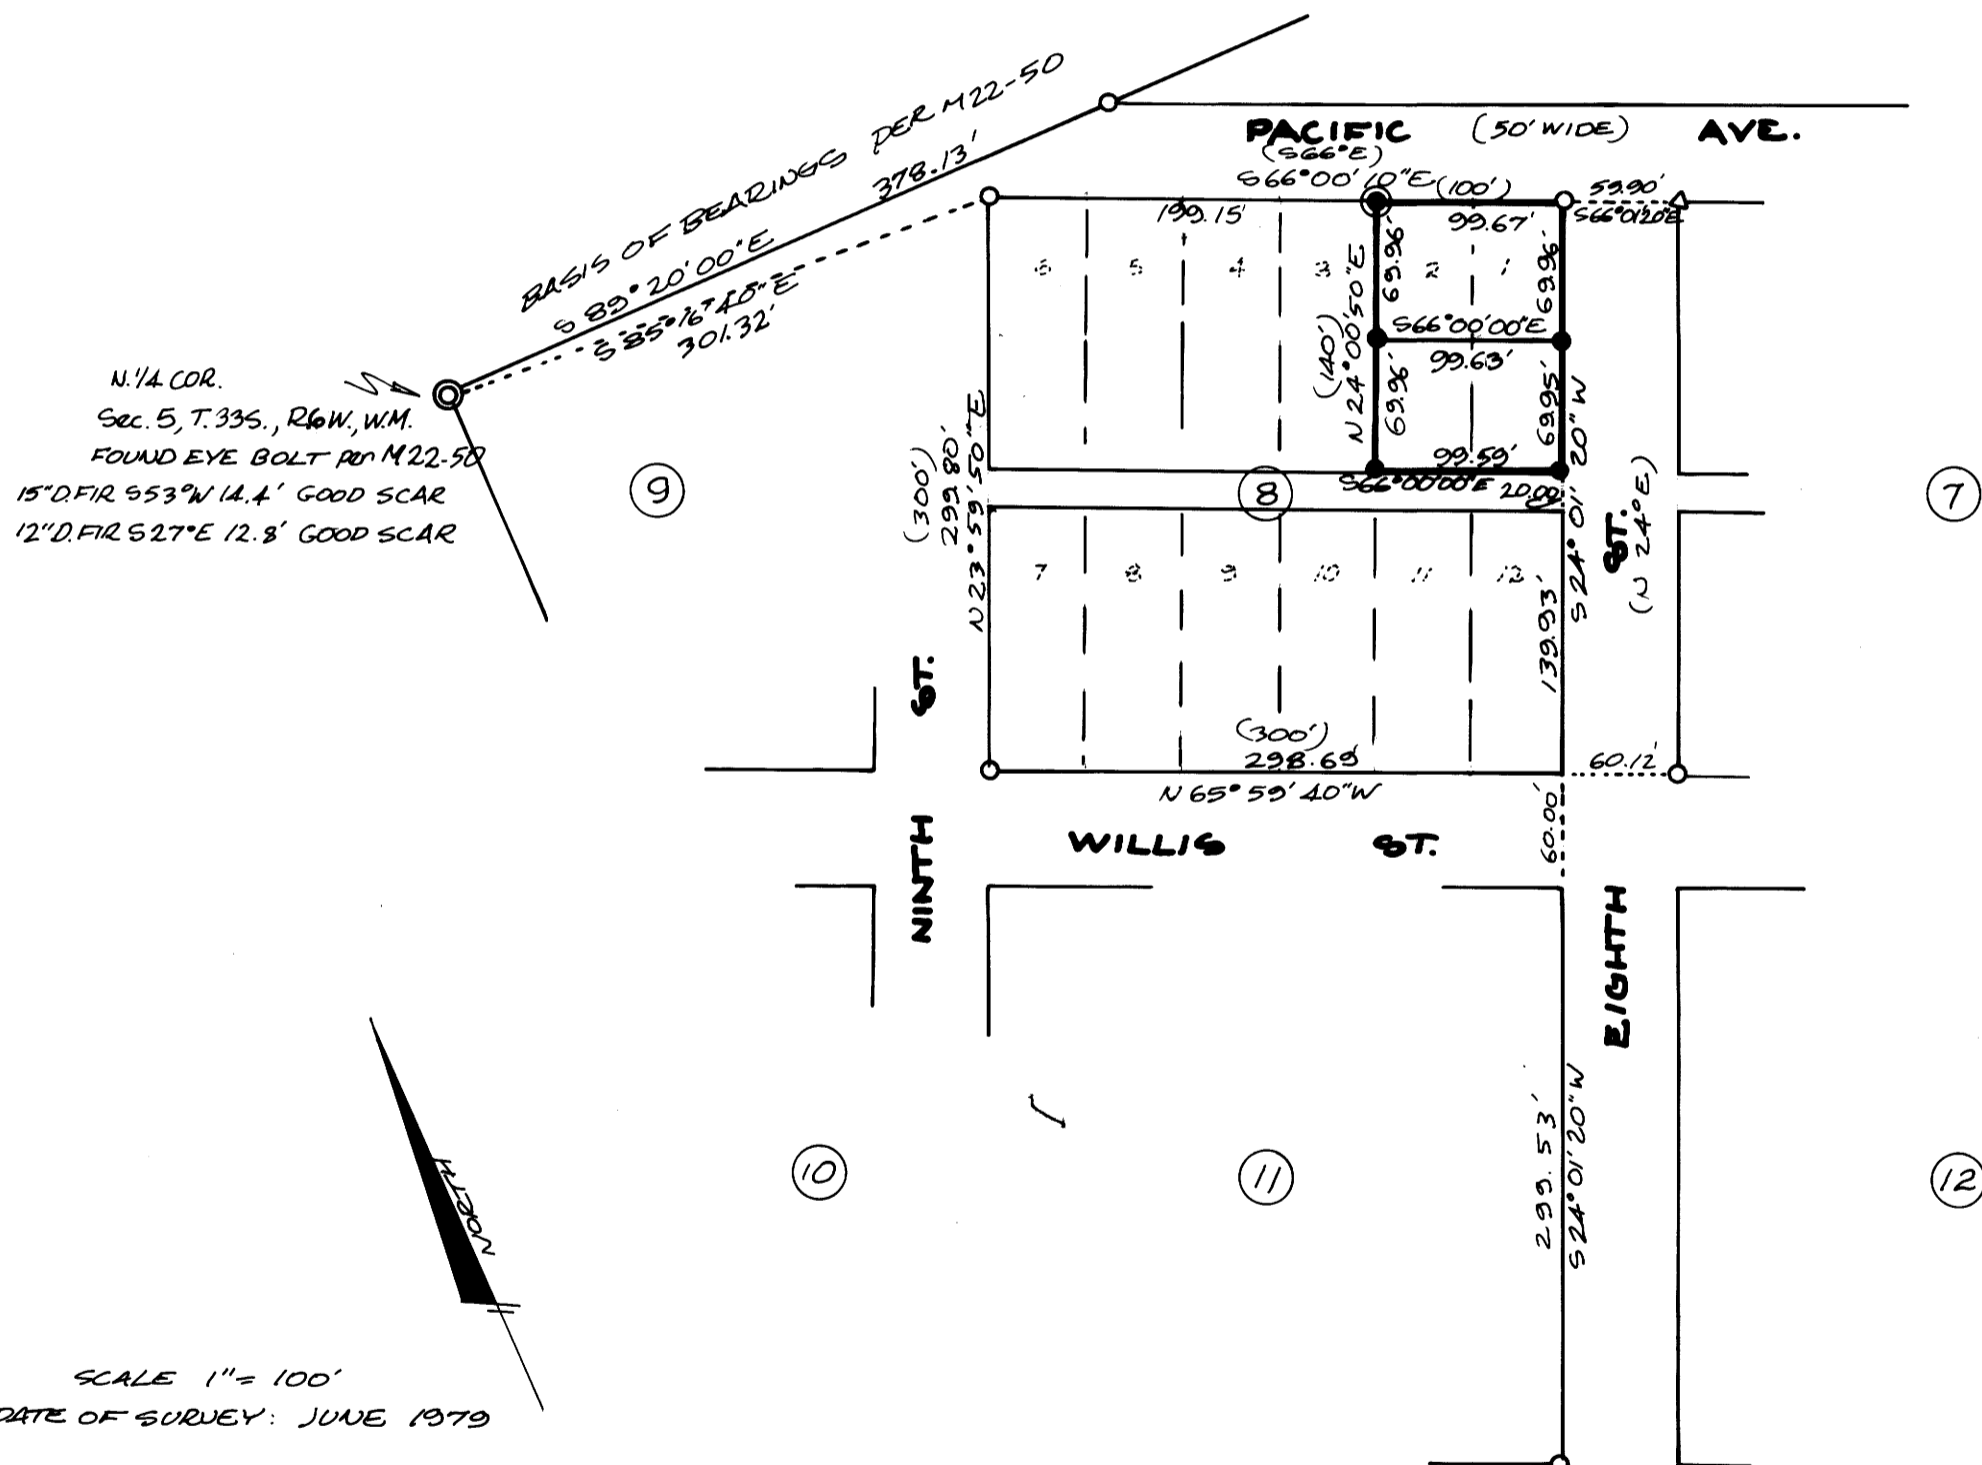

REGISTERED  
OFFICIAL  
LAND SURVEYOR  
*[Signature]*  
JUL 18 1979  
DELLAS COUNTY, ORE.

SCALE 1" = 100'  
DATE OF SURVEY: JUNE 1979

- Legend.
- set 1/2" iron rod
  - found 1/2" iron pipe
  - △ found 3/8" iron eye bolt. } per M22-50
  - ( ) record course per Town of Julia
  - ⊙ set 1/2" iron rod from which a 3/4" iron pipe found (no record) bears N 45° E 1.17'

**UNPQUA SURVEYING CO.**  
626 Division Myrtle Creek, Oregon.  
863-5201

MAP FILE M 22-50

MAP FILE M 22-50