

Fd. 1" iron pipe
Set brass cap alongside mkd.
T30S, R3W, W. M.
S5, S8, S9, CC
PLS 430 1979
From which a:
24" Douglas fir original BT
Blowdown, scribes vis.
Bears N23°E, 18.5 ft.
30" Douglas fir original BT
Stump, old face
Bears S34 1/2°W, 22.1 ft.
18" Douglas fir BT by Markham
Snag, scribes vis.
Bears S70°E, 9.9 ft.
(Record, 9.0 ft.)
8" Douglas fir, 1 scribe
"T30S R3W S8 CC BT"
Bears S87°W, 13.8 ft.
8" Douglas fir, 1 scribe
"T30S R3W S9 CC BT"
Bears S32°E, 33.1 ft.

Set brass cap mkd.
T30S, R3W, W. M.
1/4 S8, S9
PLS 430 1979
From which a:
12" Douglas fir, 1 scribe
"1/4 S9 BT"
Bears S52°E, 19.2 ft.
10" Douglas fir, 1 scribe
"1/4 S8 BT"
Bears S72°W, 25.6 ft.
No original evidence found.

Set brass cap mkd.
T30S, R3W, W. M.
S 1/16 S8, S9
PLS 430 1979
From which a:
14" Douglas fir, 1 scribe
"S 1/16 S9 BT"
Bears S18°E, 15.0 ft.
8" Douglas fir, 1 scribe
"S 1/16 S8 BT"
Bears N49 1/2°W, 12.6 ft.

Fd. brass cap mkd.
County Surveyor's Office
T30S, R3W
S8, S9, S17, S16 1966
From which a:
28" Douglas fir original BT
With face
Bears N15 1/2°E, 35.0 ft.
14" cedar BT
Scribes vis.
Bears N32°W, 8.5 ft.
32" Douglas fir original BT
Old face & bark scribes
Bears S56 1/4°W, 19.0 ft.
(Record, 19.8 ft.)
13" Douglas fir BT
Rotten blowdown
Bears S66°E, 53.2 ft.
8" Douglas fir, 1 scribe
"T30S R3W S16 BT"
Bears S66 1/2°E, 32.0 ft.
1" iron pipe adjacent to brass cap.




Bearings by solar observation.
Line double chained.

REGISTERED
PROFESSIONAL
LAND SURVEYOR
B.A. Shaner
OREGON
OCT. 4, 1987
BRUCE A SHANER
430

LEGEND

- Corner found
- Corner set
- Line marked with blazes and red paint
- Line traversed, not marked
- Line not traversed

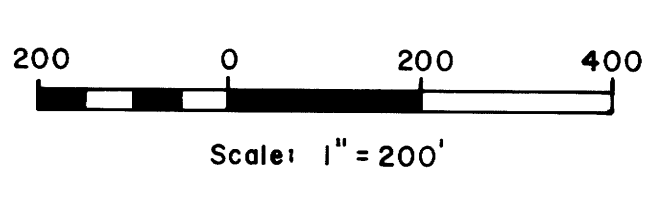

PROPERTY LINE SURVEY BETWEEN
SECS. 8 & 9, T 30 S, R 3 W, W. M.

For: Longview Fibre Co.
Longview, Washington
C & D Lumber Co.
Riddle, Oregon 97469

By: Shaner Engineering, Inc.
P. O. Box 1430
Roseburg, Oregon 97470

August 23, 1979

COUNTY SURVEYORS FILE DATA
DO NOT REMOVE FROM OFFICE