


COUNTY SURVEYORS FILE DATA
DO NOT REMOVE FROM OFFICE

FILED
RECEIVED *LR*
MAR 4 1980
COUNTY SURVEYOR
DOUGLAS COUNTY, ORE

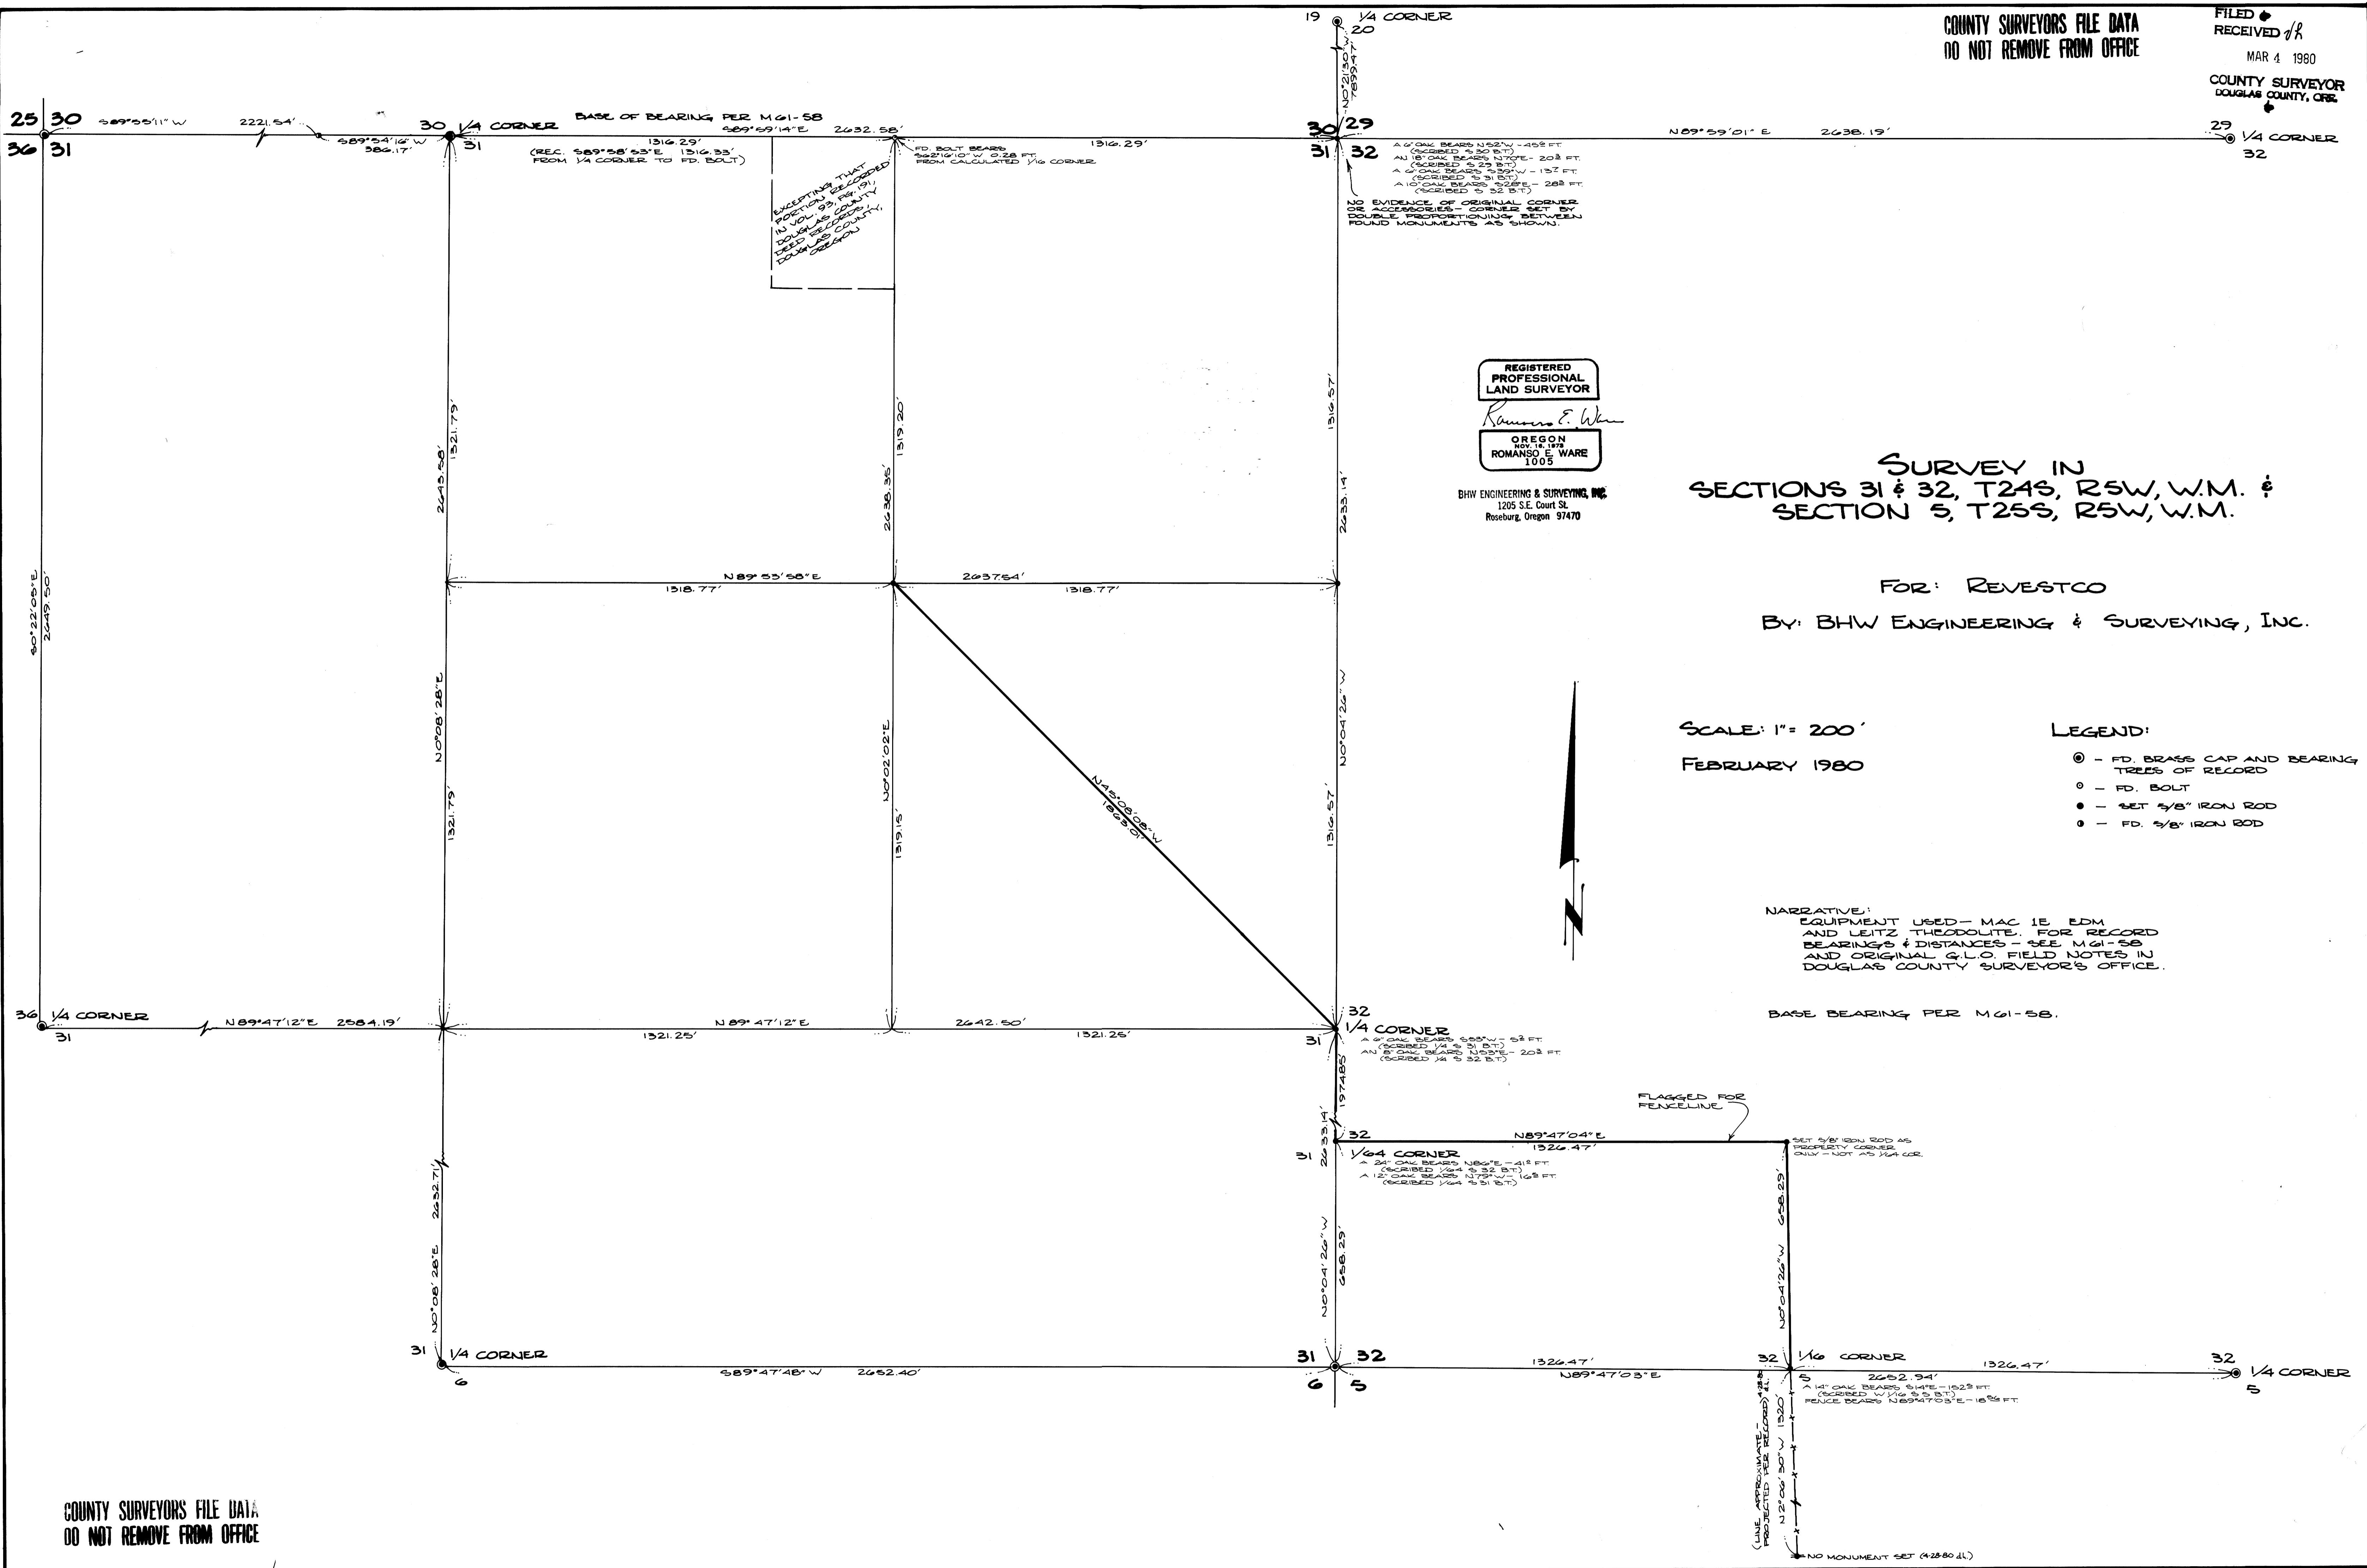

COUNTY SURVEYORS FILE DATA
DO NOT REMOVE FROM OFFICE