

19 20
30 29
30 29
31 32

SURVEY FOR WILLIAM SIMMONS

Section 32, T22S, R7W, W.M.

By: BHW Engineering & Surveying

August 1979


Scale: 1" = 200'

COUNTY SURVEYORS FILE DATA
DO NOT REMOVE FROM OFFICE

FILED *d*
RECEIVED *W*
AUG 29 1979
COUNTY SURVEYOR
DOUGLAS COUNTY, ORE.

REGISTERED
PROFESSIONAL
LAND SURVEYOR
Romano E. Ware
OREGON
NOV 14 1978
ROMANSO E. WARE
1005

NOTE: QUITCLAIM DEEDS SHOULD BE WRITTEN WITH
NEIGHBORS TO CLEAR ANY TITLE PROBLEMS.

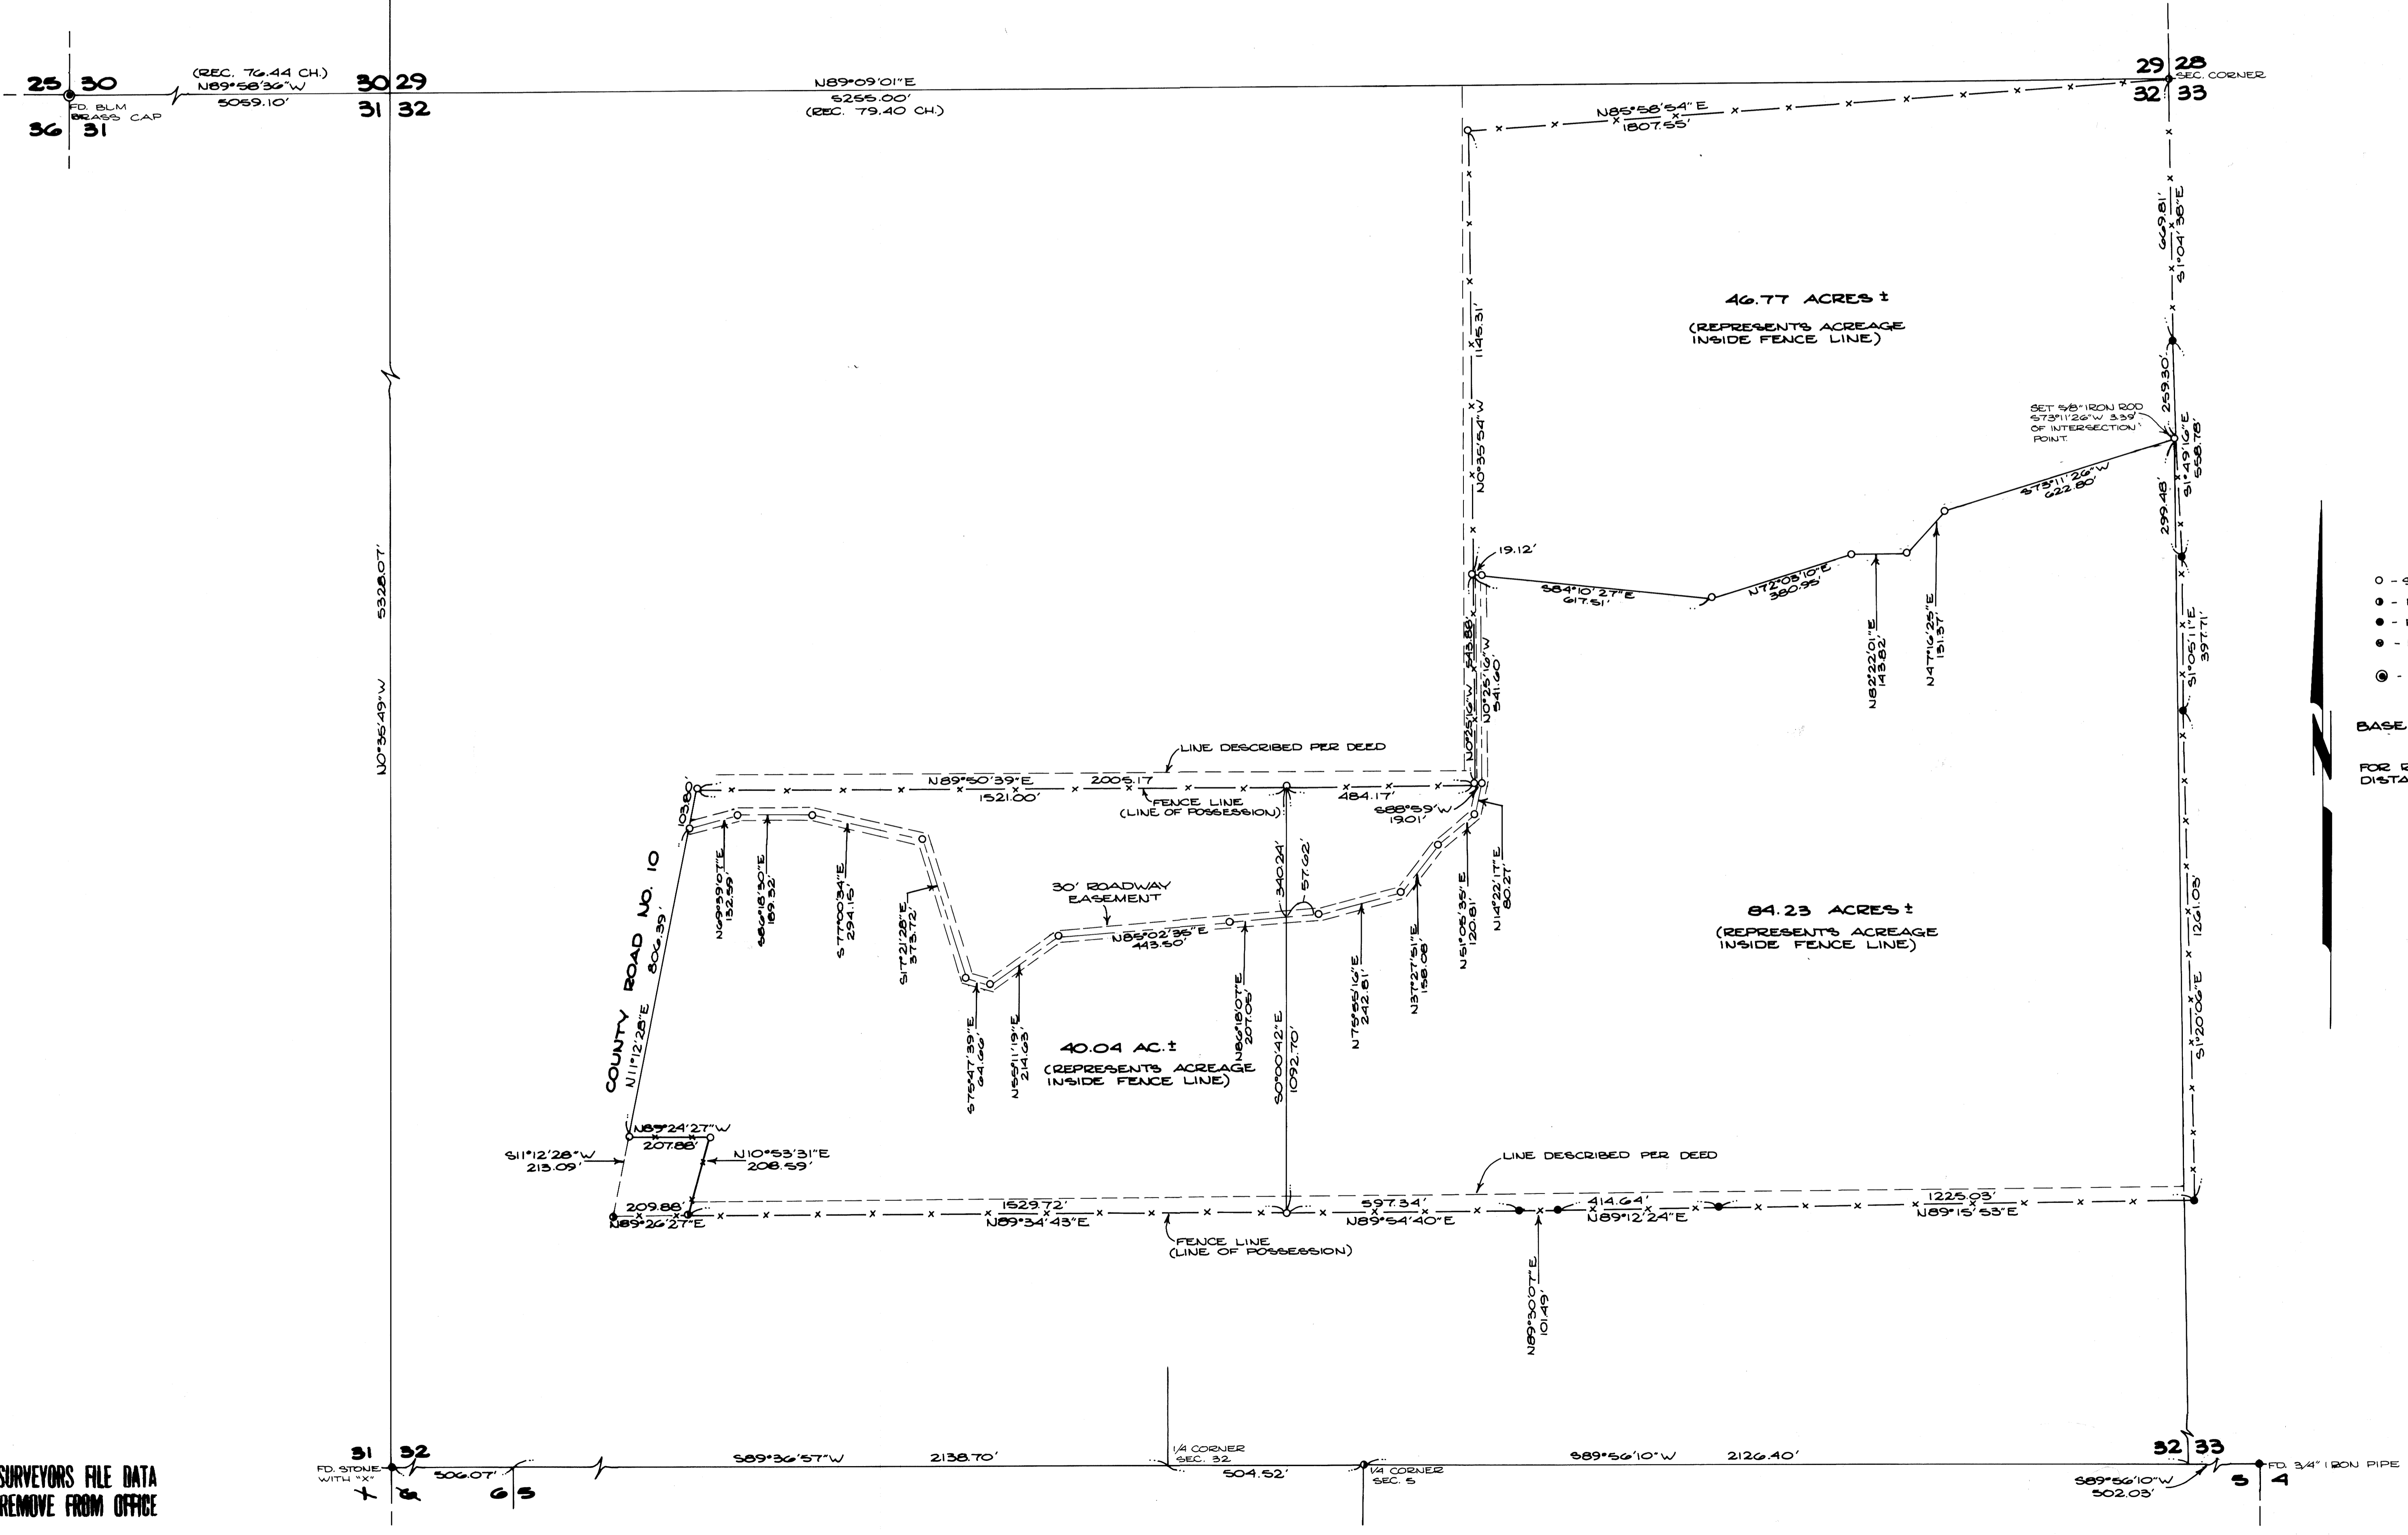

LEGEND

- - SET 5/8" IRON ROD
 - - FD. "I" IRON
 - - FD. 5/8" IRON ROD
 - - FD. MONUMENT AS NOTED
 - - FD. BRASS CAP
- BASE BEARING PER RM 2-36
FOR RECORD BEARINGS AND DISTANCES SEE RM 2-36

COUNTY SURVEYORS FILE DATA
DO NOT REMOVE FROM OFFICE