

SURVEY FOR U.S. FOREST SERVICE


SECTION 7, TOWNSHIP 27 SOUTH, RANGE 1 WEST,
WILLAMETTE MERIDIAN

COUNTY SURVEYORS FILE DATA
NOT REMOVE FROM OFFICE

FILED
RECEIVED

JUL 29 1980

COUNTY SURVEYOR
DOUGLAS COUNTY, ORE.

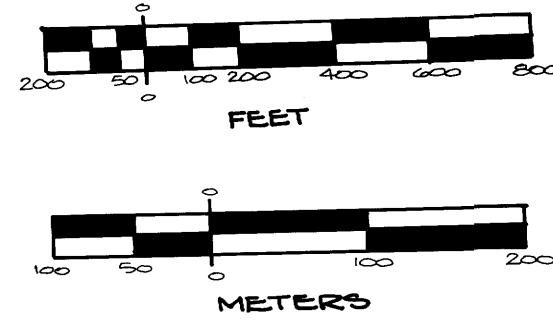

SCALE: 1" = 400'

JULY 1980

LEGEND:

- - SET CORNER MONUMENT - 2 1/2" X 30" IRON PIPE WITH 3" BRASS CAP
- - FOUND CORNER MONUMENT AS NOTED
- [] - COURSE PER G.L.O. RECORD, 1902
- < > - COURSE PER B.L.M. RECORD, 1971
- LINE POSTED WITH FIBERGLASS POSTS AND GOVERNMENT PROPERTY SIGNS AND BLAZED TREES

- ① FOUND 1/2" IRON PIPE WITH BRASS CAP (MARKED AS SHOWN) FROM WHICH BEARS:
22" D. FIR N55°E 117' GOOD SCAR
42" CEDAR S25°E 107' GOOD SCAR
SET POST & SIGN 5.0' NORTH
- ② FOUND 1/2" IRON PIPE WITH BRASS CAP (MARKED AS SHOWN) FROM WHICH BEARS:
12" FIR N52°E 16.8' SCAR
16" FIR S24°E 12.0' SCAR
24" FIR S10°E 42.9' VIS SCRIBES
SET POST & SIGN 5.0' NORTH
- ③ SET 2 1/2" IRON PIPE WITH BRASS CAP (MARKED AS SHOWN) FROM WHICH BEARS:
SCRIBED NEW B.T.'S:
6" D. FIR S42°W 5.2' "C1/4-57 B.T."
6" D. FIR N52°W 20.0' "C1/4-57 B.T."
BRASS WASHER MARKED RLS 1654
SET IN B.T. FACES
SET POST & SIGN 3.0' NORTH
- ④ FOUND 2 1/2" IRON PIPE WITH BRASS CAP (MARKED AS SHOWN) FROM WHICH BEARS:
SCRIBED NEW B.T.'S:
6" PINE N74°W 18.6' "57/58"
6" D. FIR S24°E 14.8' "57/58"
BRASS WASHER MARKED RLS 1005 SET IN B.T. FACES
SET POST & SIGN 2.0' EAST
ORIG. STUMP
19" FIR S1°W 7.3' NO VIS. MARKS
- ⑤ SET 2 1/2" IRON PIPE WITH BRASS CAP (MARKED AS SHOWN) FROM WHICH BEARS:
SCRIBED NEW B.T.'S:
24" FIR S34°W 28.5' "57/58"
20" FIR N87°W 29.4' "57/58"
BRASS WASHER MARKED RLS 1005 SET IN B.T. FACES
SET POST & SIGN 3.0' EAST
SCRIBED NEW B.T.'S:
14" D. FIR N82°W 10.7' GOOD SCAR
12" D. FIR S25°E 22.9' GOOD SCAR
SET POST & SIGN 2.0' EAST
- ⑥ FOUND 2 1/2" IRON PIPE WITH BRASS CAP (MARKED AS SHOWN) FROM WHICH BEARS:
14" D. FIR N82°W 10.7' GOOD SCAR
12" D. FIR S25°E 22.9' GOOD SCAR
SET POST & SIGN 2.0' EAST
- ⑦ FOUND 1/2" IRON PIPE WITH BRASS CAP (MARKED AS SHOWN) FROM WHICH BEARS:
42" FIR S14°W 9.6' VIS SCRIBES
24" FIR N52°E 9.8' SHOWS SCAR
SET POST & SIGN 5.0' SOUTH
- ⑧ FOUND 2 1/2" IRON PIPE WITH 3" BRASS CAP (MARKED AS SHOWN) FROM WHICH BEARS:
14" D. FIR S41°W 60.0' VIS SCRIBES
48" D. FIR S61°E 63.0' VIS SCRIBES
FOUND POST & SIGN 4.0' EAST
- ⑨ FOUND 1/2" IRON PIPE WITH BRASS CAP (MARKED AS SHOWN) FROM WHICH BEARS:
FOUND METAL POST & SIGN
8" D. FIR WEST 11.0' GOOD SCAR
18" HEMLOCK N10°W 20.2' GOOD SCAR
12" HEMLOCK N2°E 21.9' GOOD SCAR
48" D. FIR N 23°E 81.0' OLD FACE WITH CUT
8" CEDAR S50°E 93.5' VIS SCRIBE
SET POST & SIGN 5.0' WEST

NOTE: ALL NEW BEARING TREES SCRIBED IN THIS SURVEY ARE MARKED WITH BRASS WASHERS STAMPED "RLS 1654" OR "RLS 1005" NAILED TO THE LOWER BLAZE OF EACH TREE.

"I, RONALD A. QUIMBY, A REGISTERED PROFESSIONAL LAND SURVEYOR IN THE STATE OF OREGON, HEREBY CERTIFY THAT THIS PLAT AND THE NOTES HEREON, OR ATTACHED, ARE A CORRECT REPRESENTATION OF A SURVEY I PERFORMED DURING MAY 1980 THROUGH JULY 1980, FOR THE U.S. FOREST SERVICE, IN ACCORDANCE WITH THE STATUTES OF THE STATE OF OREGON AND WITH THE ARTICLES OF MY CONTRACT."

Ronald A. Quimby
RONALD A. QUIMBY
REGISTERED PROFESSIONAL LAND SURVEYOR
OREGON LICENSE NO. 1654

REGISTERED PROFESSIONAL LAND SURVEYOR
Romanso E. Ware
OREGON NOV. 18, 1973
ROMANSO E. WARE
1005

REGISTERED PROFESSIONAL LAND SURVEYOR
Ronald A. Quimby
OREGON NOV. 18, 1973
RONALD A. QUIMBY
1654

NARRATIVE: PREVIOUSLY SURVEYED BY G.L.O. AND B.L.M. PURPOSE OF SURVEY TO LOCATE GOVERNMENT PROPERTY LINES.
FIELD SUPERVISOR: R. QUIMBY. PARTY CHIEF: M. RADCLIFFE. OFFICE COMPUTATIONS: R. WARE AND R. QUIMBY. DRAFTING: D. HOPKINS. EQUIPMENT USED: WILD T-1 THEODOLITE AND RED-1 E.D.M.
BASE BEARING PER E 1/2 OF SOUTH LINE, SECTION 8, T27S, R1W, W.M. S89°23'33"E FROM MONUMENT FOUND ON C.S. M79-48.
REFERENCE SURVEYS: G.L.O. NOTES, 1902 AND B.L.M. NOTES, 1971. REFERENCE DEEDS: INSTRUMENT NO. 78-8738.
LINES POSTED WERE TO THE CALCULATED POSITION OF THE S 1/4 AND E 1/4. THE FOUND MONUMENTS WERE REJECTED AS BEING TOO FAR OUT OF POSITION.

BHW ENGINEERING & SURVEYING, INC.
1205 S.E. COURT - ROSEBURG, OREGON - 673-0165

COUNTY SURVEYORS FILE DATA
DO NOT REMOVE FROM OFFICE

CONTRACT NO. 53-04H1-9-7490N GLIDE SURVEY NO. 10