

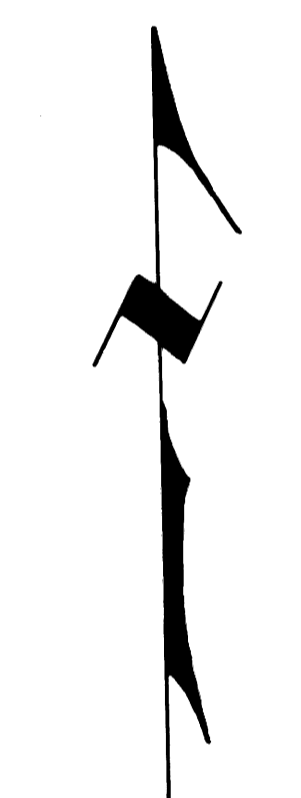


MAP FILE M.79-63

FILED *BS*
RECEIVED *BS*
DEC 2 1980
COUNTY SURVEYOR
DOUGLAS COUNTY, ORE.
BS

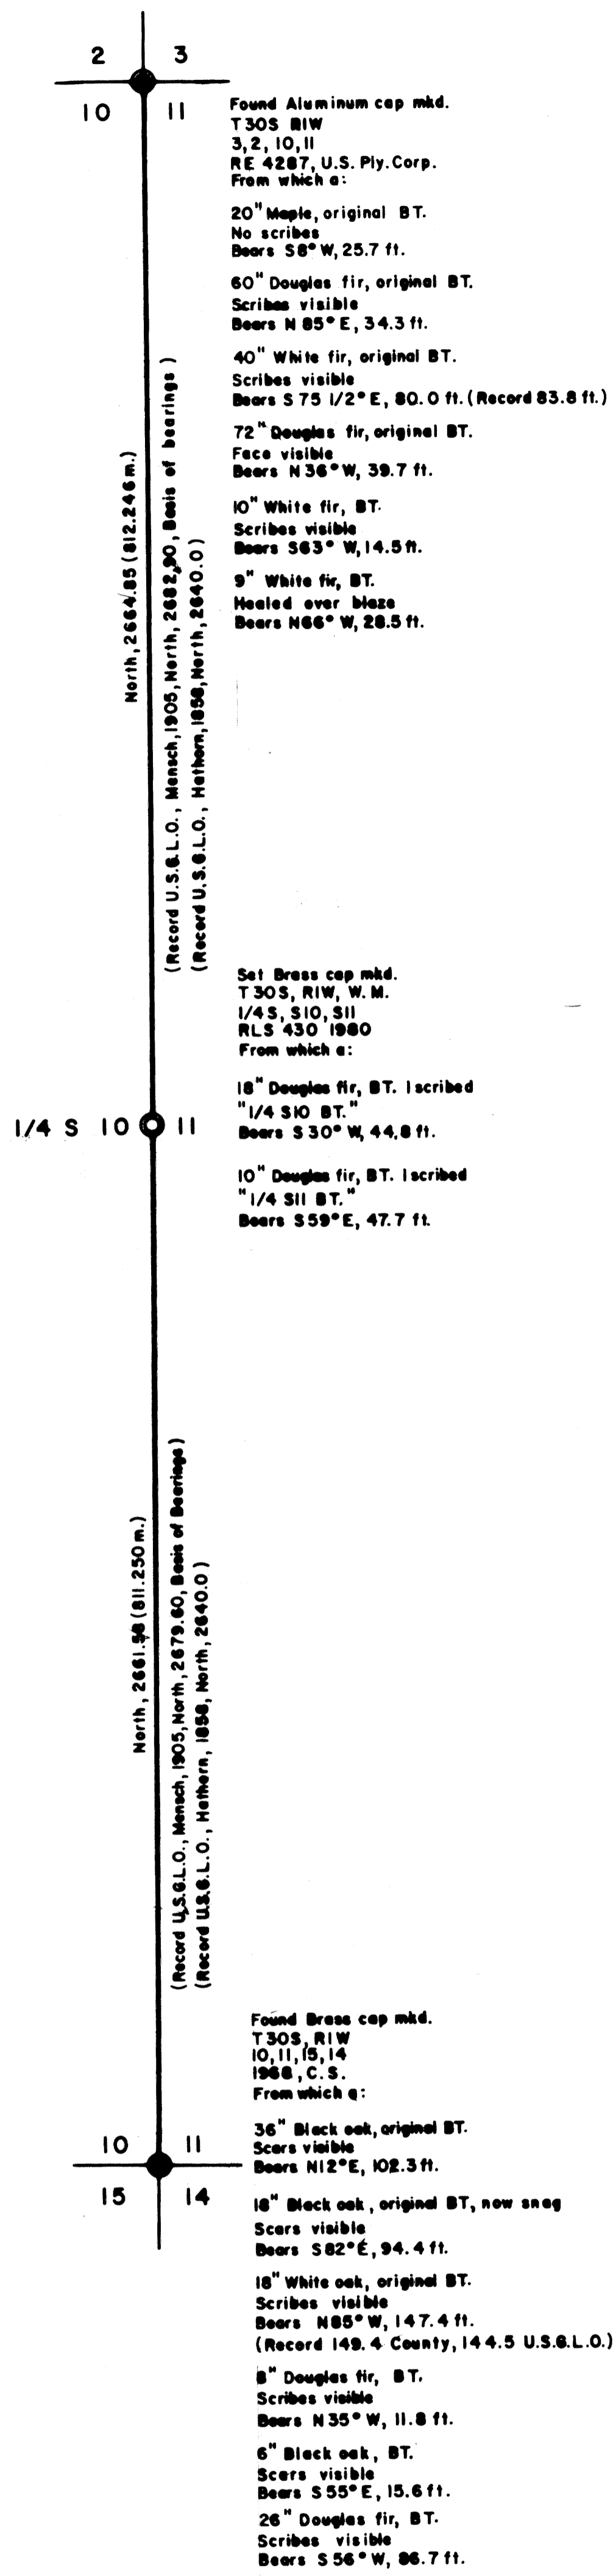

Basis of Bearings
U.S.G.L.O. Survey by
Mensch, 1905.

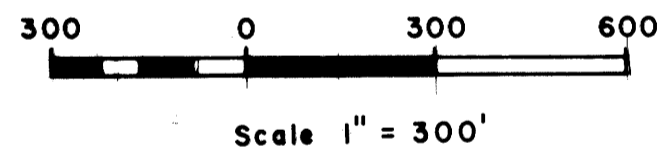

REGISTERED
PROFESSIONAL
LAND SURVEYOR

BA Shaner

OREGON
OCT. 4, 1967
BRUCE A SHANER
420

NARRATIVE

The line between Sections 10 & 11 was surveyed with a Franke 20" Theodolite and a "Mac 1" EDM during April thru July, 1980, to replace the quarter section corner and mark the property line. The line was originally surveyed by Hethorn, U.S.G.L.O., 1856 and later surveyed by Mensch, U.S.G.L.O., 1905.

LEGEND

- Corner found
- Corner set
- Line traversed, posted, blazed, and painted.

TILLER LAND SURVEY NO. 36 OF
SEC. 11, T30S, RIW, W.M.,
DOUGLAS COUNTY, OREGON
(Contract No. 53-04HI-9-7462 N)

For: Tiller Ranger District
Umpqua National Forest

By: Shaner Engineering, Inc.
P.O. Box 1430
Roseburg, Oregon 97470

August, 1980

MAP FILE M.79-63