


FILED *BS*
 RECEIVED *BS*
 FEB 13 1981
 COUNTY SURVEYOR
 DOUGLAS COUNTY, ORE.
BS

NARRATIVE

The survey was performed as per map for the purpose of setting property corners and marking property lines. A Franke 20" Theodolite and a "Mac" E.D.M. was used. The corners were found to be as set by the U.S.B.L.M. and other surveyors as shown on map. On all BT's I scribed, I placed a brass disk marked "R.L.S. 430."

LEGEND

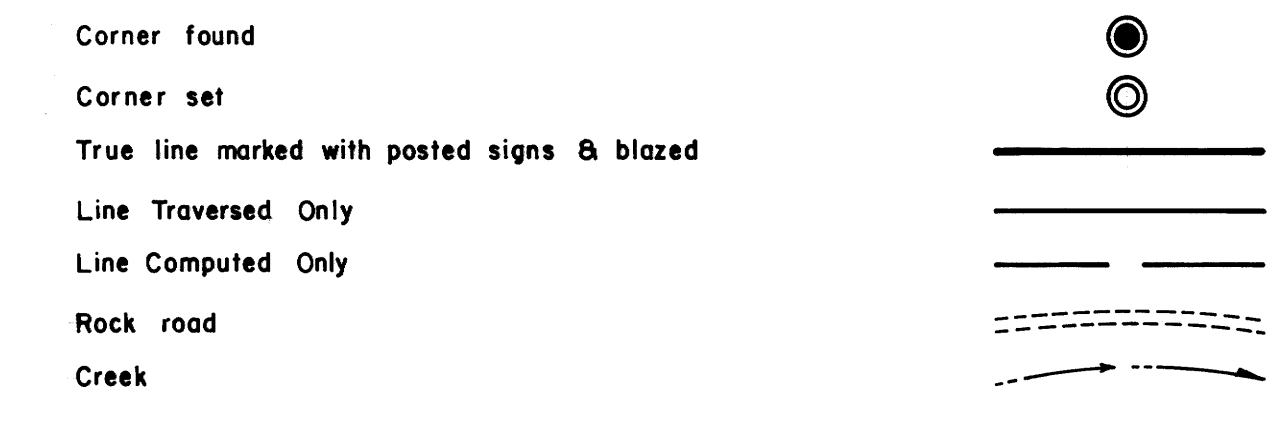

CERTIFICATE OF SURVEYOR

I, Bruce A. Shaner, registered land surveyor in the State of Oregon, hereby certify that this and the notes hereon are a correct representation of a survey we performed during April, 1980, thru January, 1981, for the U.S. Forest Service in accordance with statutes of the State of Oregon and with the articles of the contract.

BA Shaner
 Bruce A. Shaner
 Registered Land Surveyor
 Oregon License 430



TILLER LAND SURVEY NO. 36 OF
 PROPERTY LINES IN THE NW 1/4
 OF SECTION 5, T30S, RIW, W.M.
 DOUGLAS COUNTY, OREGON
 (Contract No. 53-04H1-9-7462 N)

For: Tiller Ranger District,
 Umpqua National Forest

By: Shaner Engineering, Inc.
 P.O. Box 1430
 Roseburg, Oregon

January, 1981

