


Survey in Section 26, T26S, R6W, W.M.

For: Jim Spackman
By: BHW Engineering & Surveying

Scale: 1" = 100'

October 1979

COUNTY SURVEYORS FILE DATA
DO NOT REMOVE FROM OFFICE

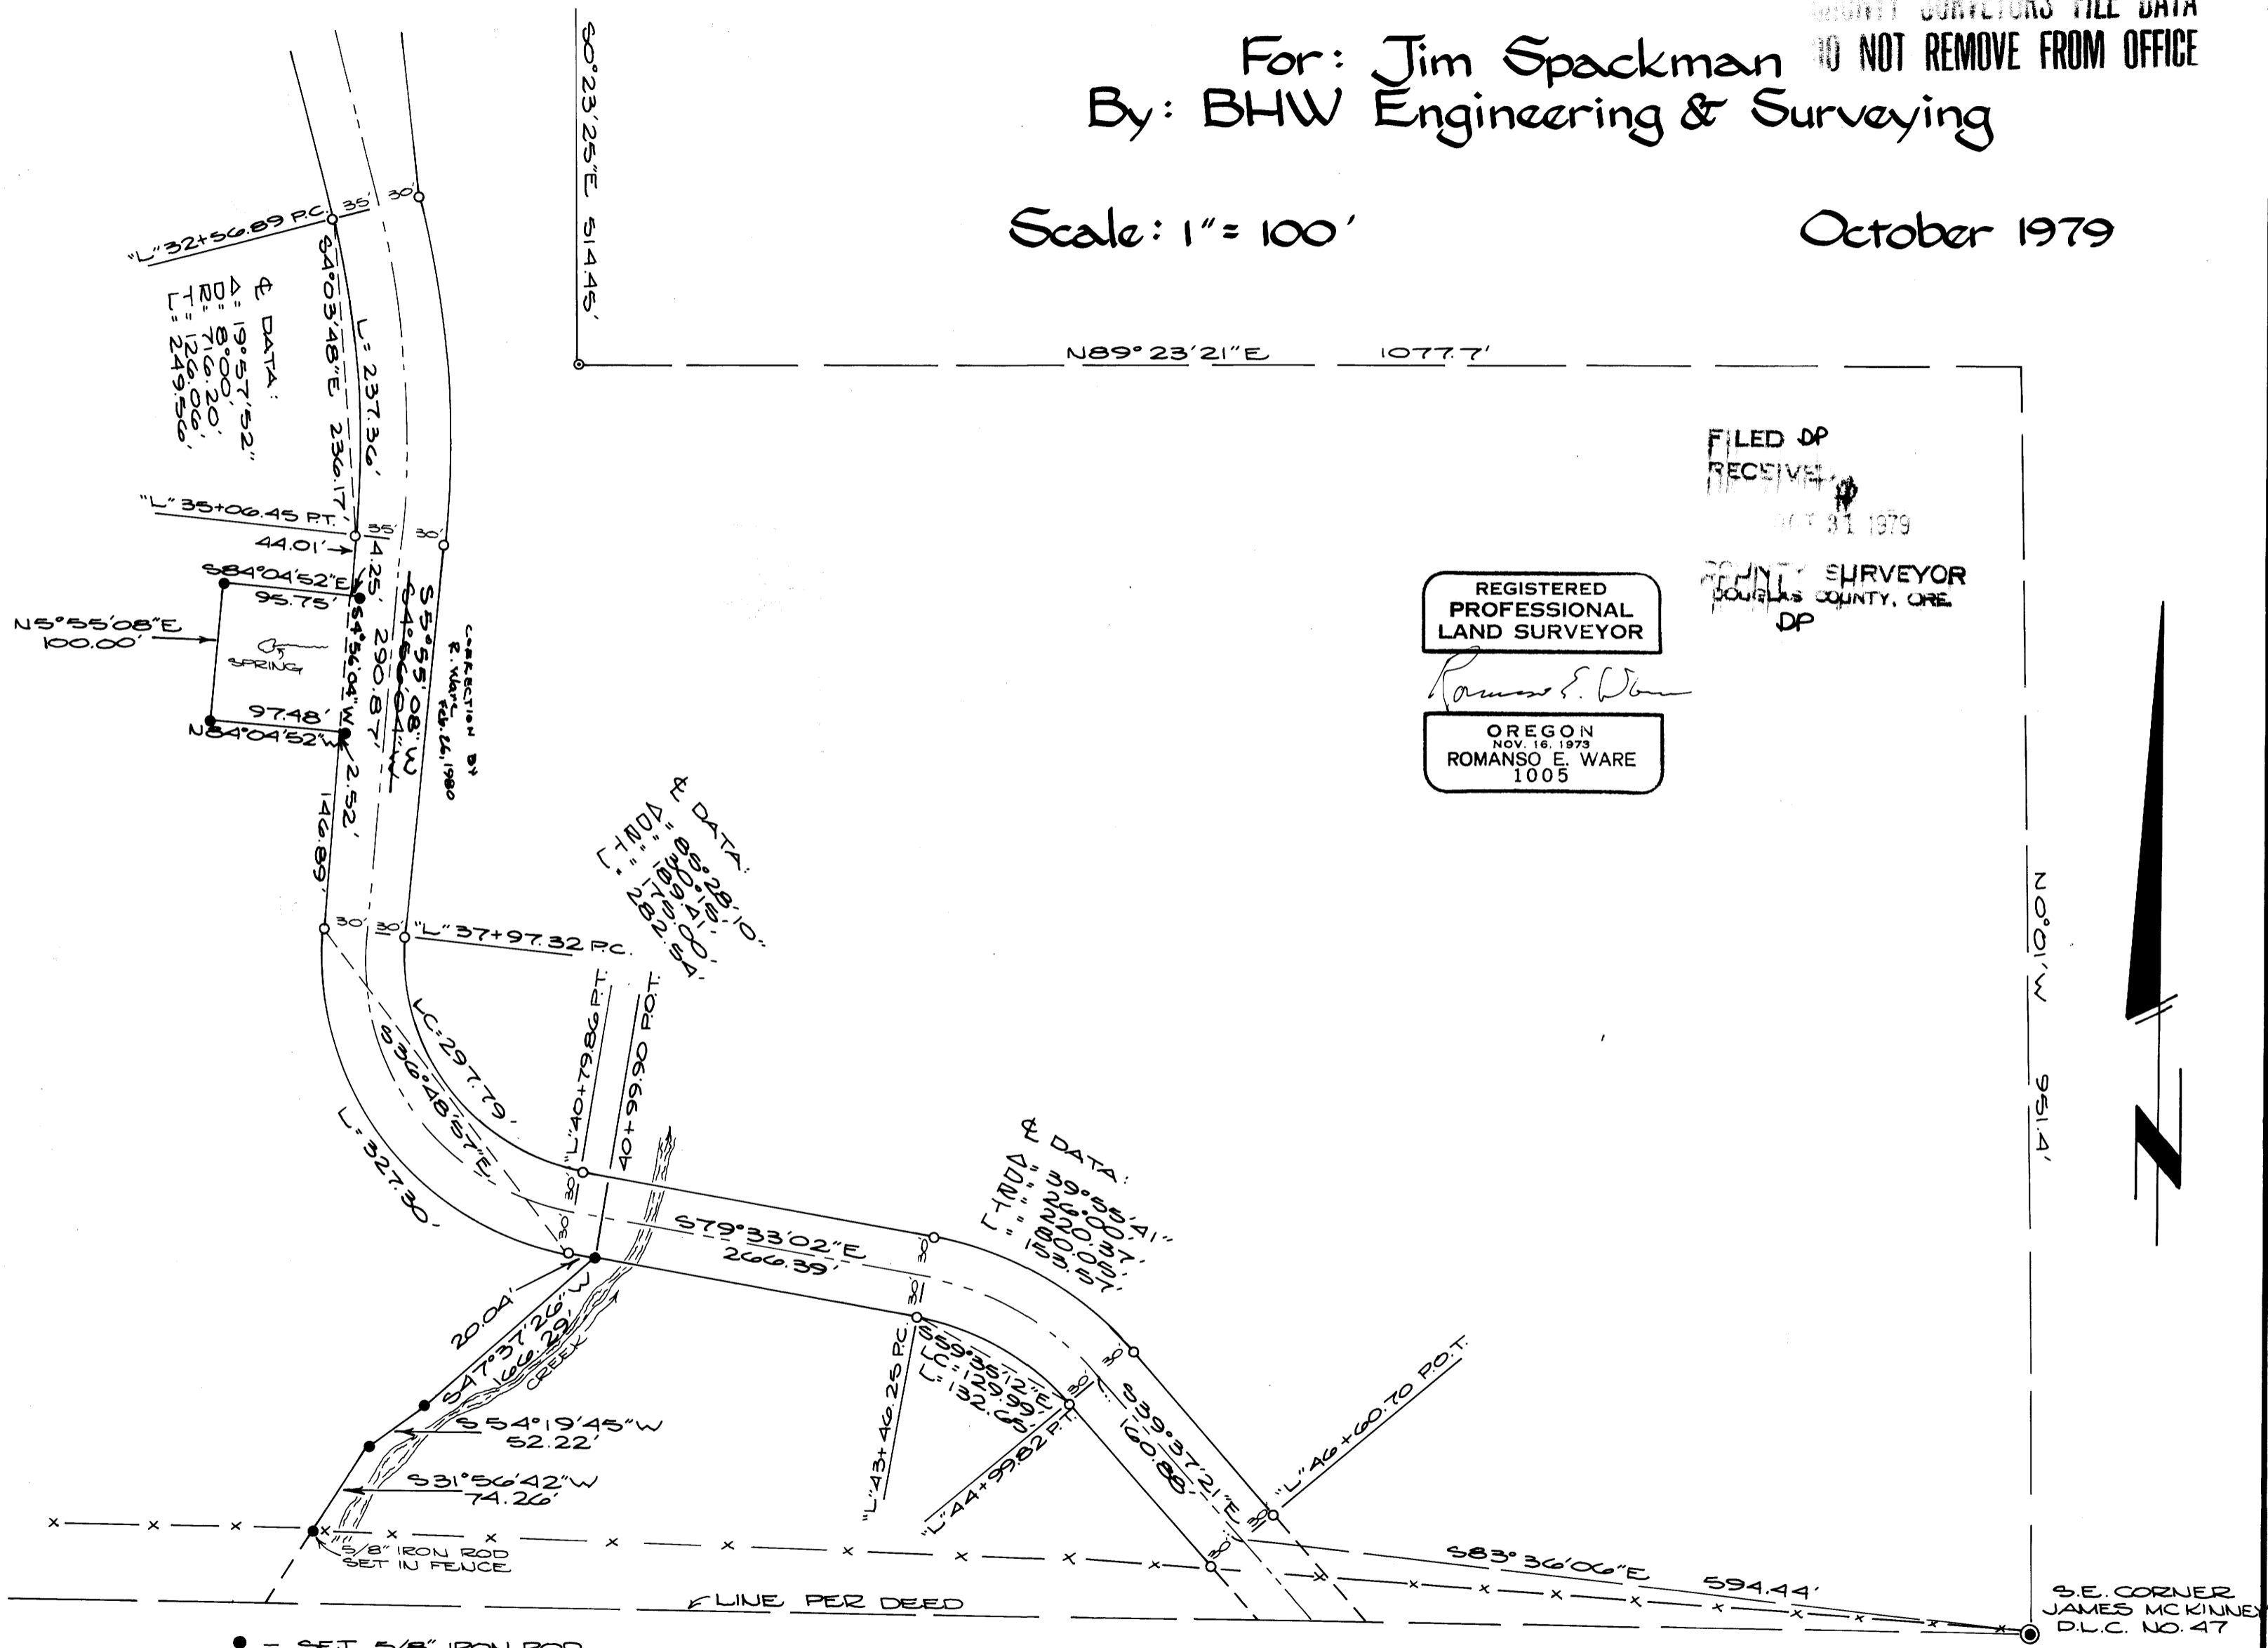

FILED DP
RECEIVED
OCT 31 1979
COUNTY SURVEYOR
DOUGLAS COUNTY, ORE
DP

REGISTERED
PROFESSIONAL
LAND SURVEYOR

Romanso E. Ware

OREGON
NOV. 16, 1973
ROMANSO E. WARE
1005



- LEGEND:
- - SET 5/8" IRON ROD
 - - FD. 5/8" IRON ROD
 - ⊙ - FD. BRASS CAP

BASIS OF BEARING PER RM 3-6.

S.E. CORNER
JAMES MCKINNEY
D.L.C. NO. 47

MAP FILE M 80-49

MAP FILE M 80-49