


TOWNSHIP 26 SOUTH, RANGE 2 WEST, OF THE WILLAMETTE MERIDIAN, OREGON

ADMINISTRATIVE SURVEY

FILED *dh*
RECEIVED *dh*


NOV 26 1979

COUNTY SURVEYOR
WAGLAS COUNTY, ORE.

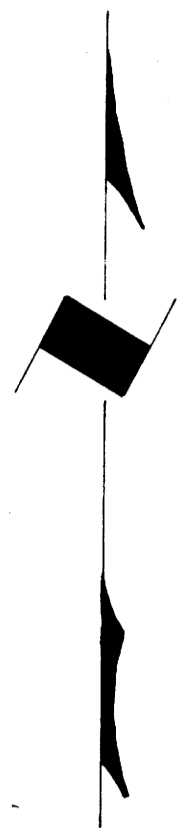

SEC. 19

FOUND
CO. B.C.

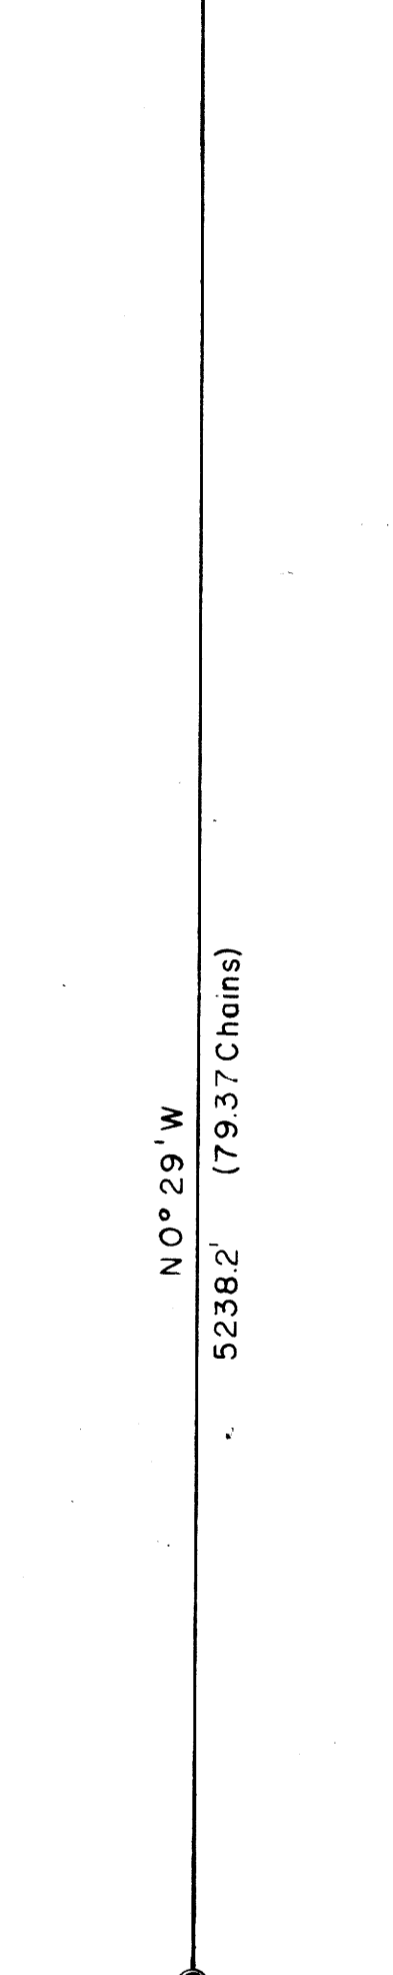

FOUND
CO. B.C.

SEC. 31

BLM
SEC. 30

PRIVATE
SEC. 30


N 0° 29' W
5238.2' (79.37 Chains)

THIS PLAT REPRESENTS AN ADMINISTRATIVE SURVEY OF
T 26 S, R 2 W, SEC. 30, WILLAMETTE MERIDIAN. BEARINGS
ARE DETERMINED BY DIRECT OBSERVATION OF THE SUN AND
ALL B L M PROPERTY LINES ARE TAGGED. REFERENCE
TREE DISTANCE IS TO FACE OF TREE.

COUNTY SURVEYORS FILE DATA
DO NOT REMOVE FROM OFFICE

LEGEND

● CORNERS FOUND

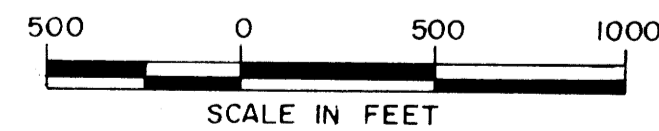

U.S. BUREAU OF LAND MANAGEMENT

ROSEBURG DISTRICT OREGON

DRAWN BY PAUL BENTLEY DATE 11-3-78

SURVEYED BY ALEX TUPYI DATE OCTOBER 1978

APPROVED BY *Bruce P. Chamber* DATE DECEMBER 1978
DISTRICT ENGINEER