

SECT. 17, T. 22 S., R. 5 W. W. M.

For

Albert B. + SEIRETTA Cook DRAIN, ORC.


Nov. 27, 1979

FILED ϕ
RECEIVED ϕ

DEC 6 1979

COUNTY SURVEYOR
DOUGLAS COUNTY, ORE.

ϕ

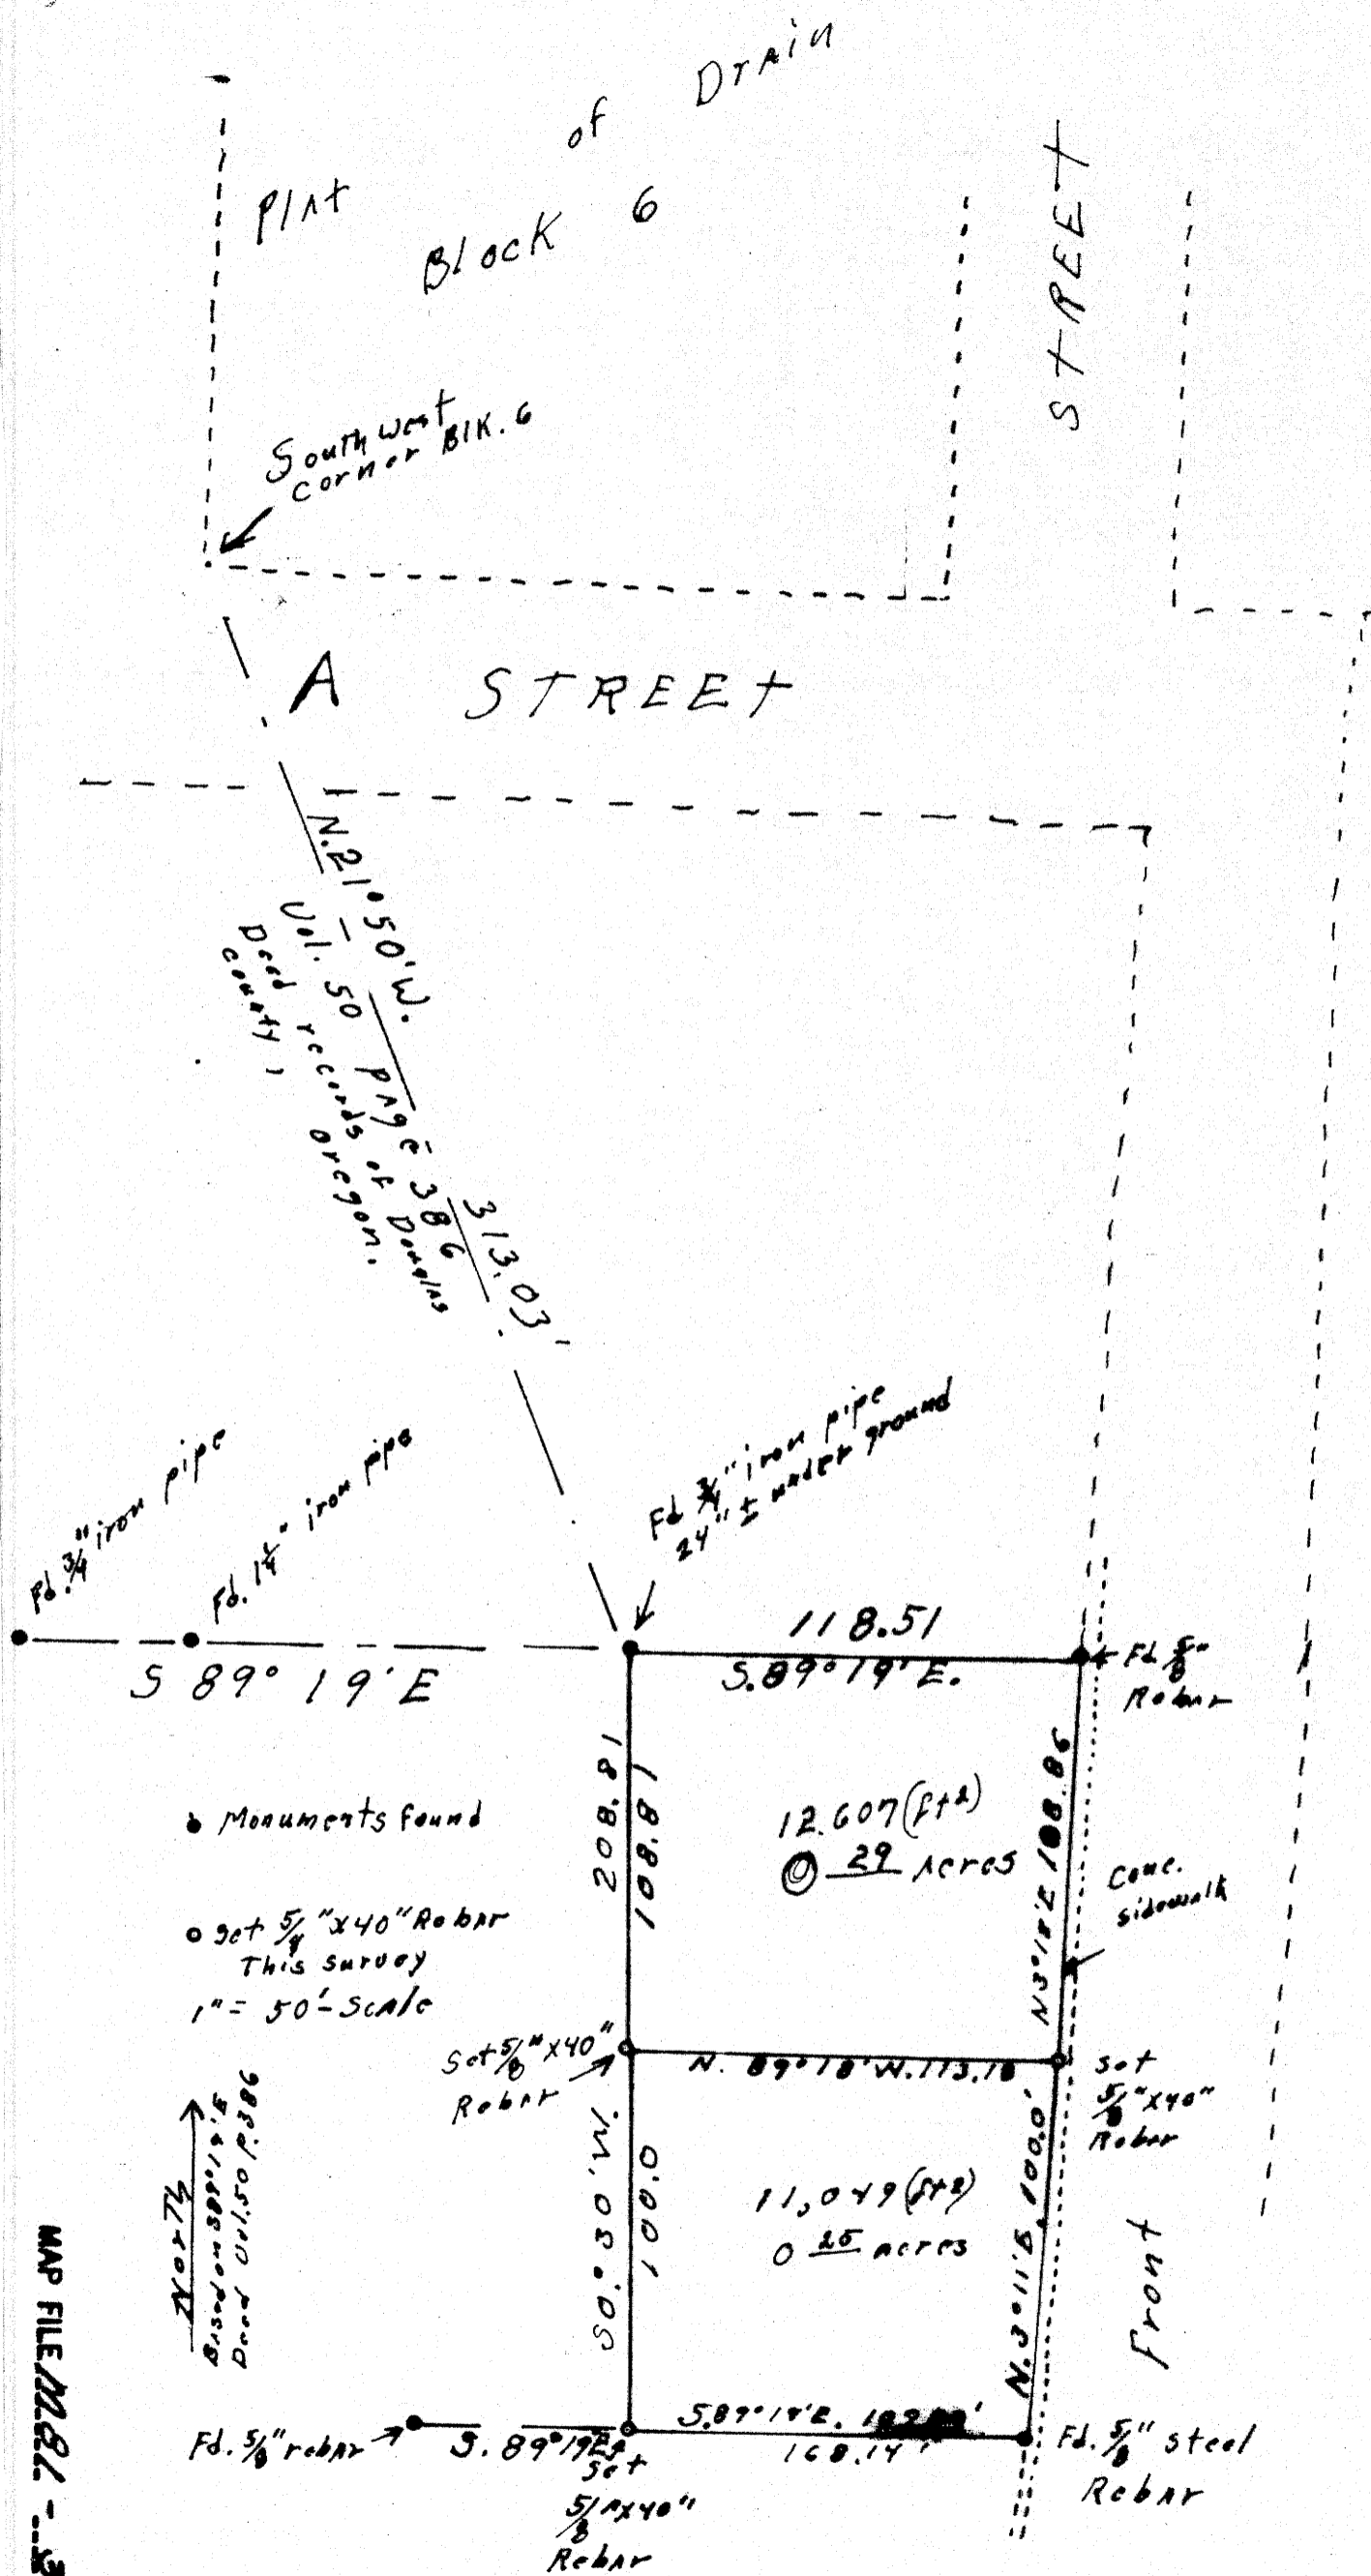

This survey started at a 3/4" iron pipe from which the South West corner of Block 6 City of Drain bears N. 21° 50' W. 313.03 feet, Thence 1 ran S. 89° 30' W. 108.81 ft. and set 5/8" x 40" rebar, Thence continue S. 0° 30' W. 100.0 feet and set a 5/8" x 40" rebar on the North line of Edward D Jones property; Thence S. 89° 19' E. 107.83 feet to a 5/8" rebar, Thence N. 3° 11' E. 100.0 feet and set a 5/8" x 40" rebar, Thence N. 89° 18' W. 113.18 ft to the first 5/8" Rebar set on this survey.

REGISTERED
OREGON
LAND SURVEYOR

Wilford N. Haines
MAY 7, 1948
WILFORD N. HAINES
239