


FILED  $\phi$   
RECEIVED *BS*

FEB 8 1980

COUNTY SURVEYOR  
DOUGLAS COUNTY, ORE.  
 $\phi$

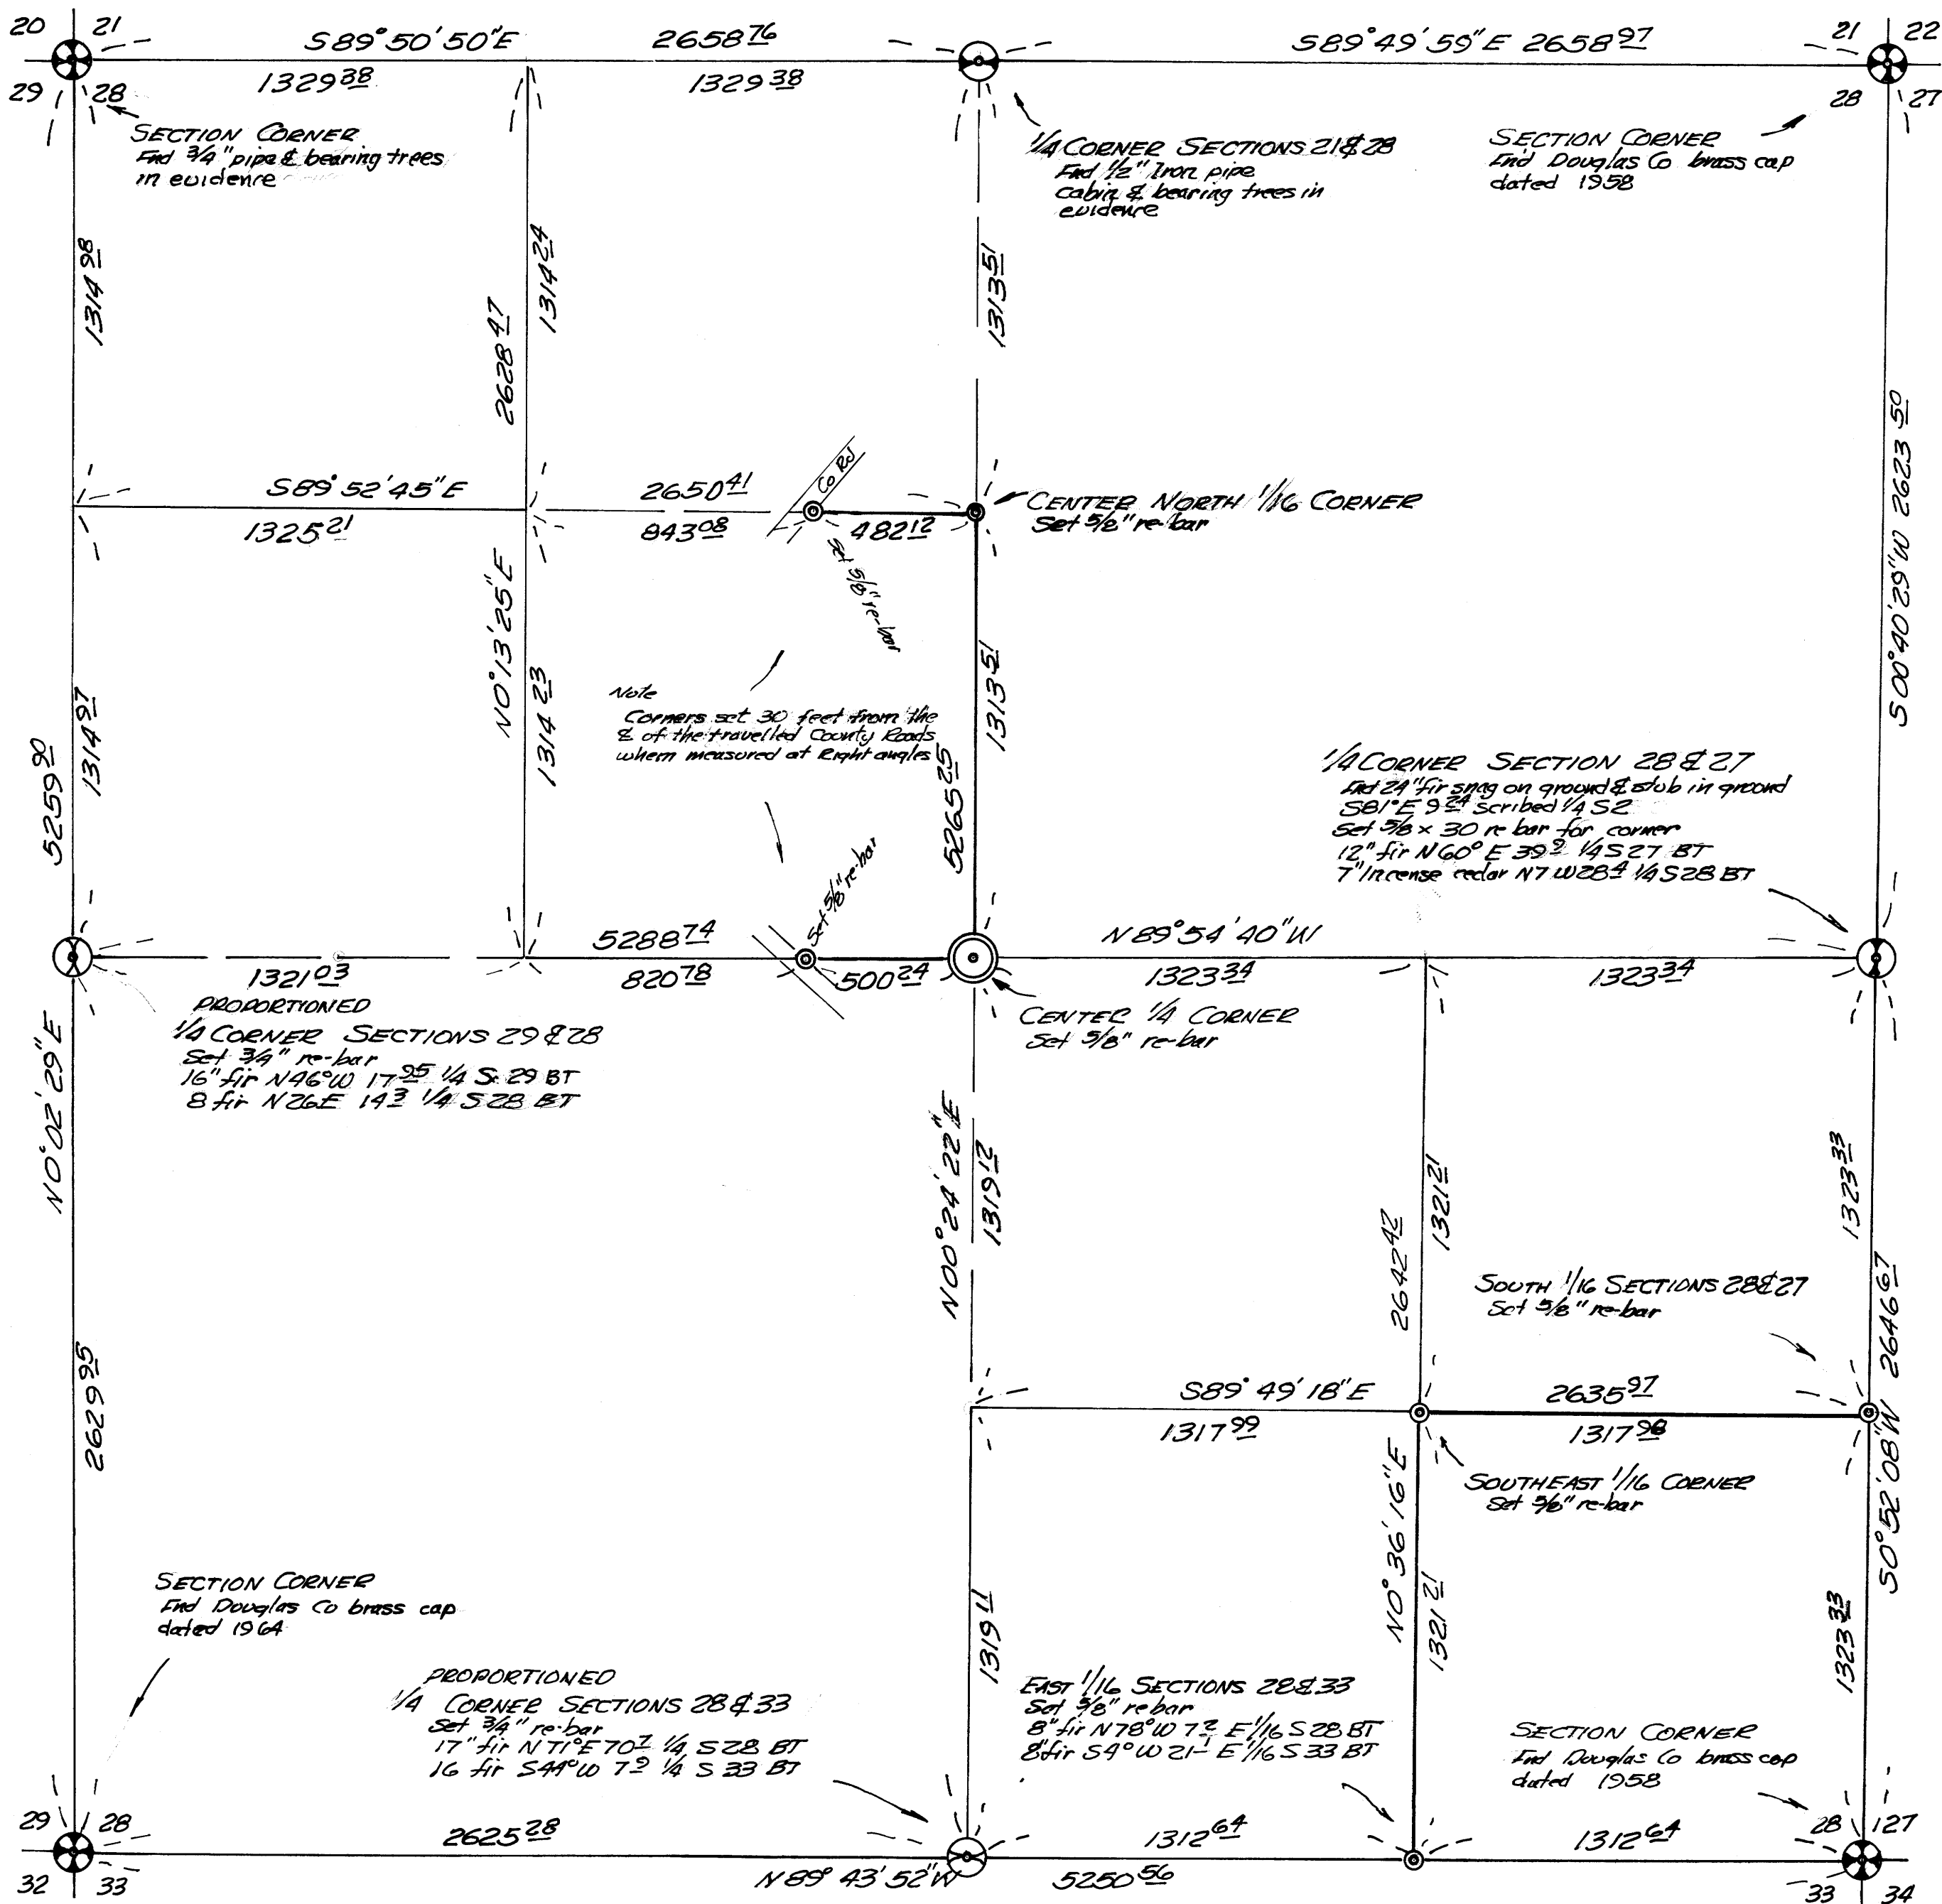

BEARINGS TRUE  
BASED ON POLARIS  
AT EAST ELONGATION

REGISTERED  
PROFESSIONAL  
LAND SURVEYOR  
*William A. Eimstad*  
OREGON  
MAP 4, 1959  
WILLIAM A. EIMSTAD  
377

SURVEY FOR CHARLES BOOHER  
SECTION 28 T21S, R4W OF W.M.  
EIMSTAD & ASSOCIATES  
1717 WASHINGTON ST. EUGENE, ORE.  
DECEMBER, 1979  
SCALE  
1 INCH = 400 FEET

Note  
Survey made with THEODOLITE - EDM - 300 FOOT ENGINEERS TAPE  
PLUMB BUBB.

COUNTY SURVEYORS FILE DATA  
DO NOT REMOVE FROM OFFICE

MAP FILE M 82-14

MAP FILE M 82-14