

SURVEY FOR DEED DESCRIPTION FOR JACK PICKETT

In the South Half of Section 26, T.30 S., R.5 W., W.M.

March 1980 Scale: 1" = 200'

FILED
RECEIVED

MAR 27 1980


COUNTY SURVEYOR
DOUGLAS COUNTY, ORE.

REGISTERED
OREGON
LAND SURVEYOR

JULY 12, 1958
WILLIAM J. RUPPERT
866

UMPQUA SURVEYING COMPANY
MYRTLE CREEK, OREGON

Bearings Based Upon M-78-12

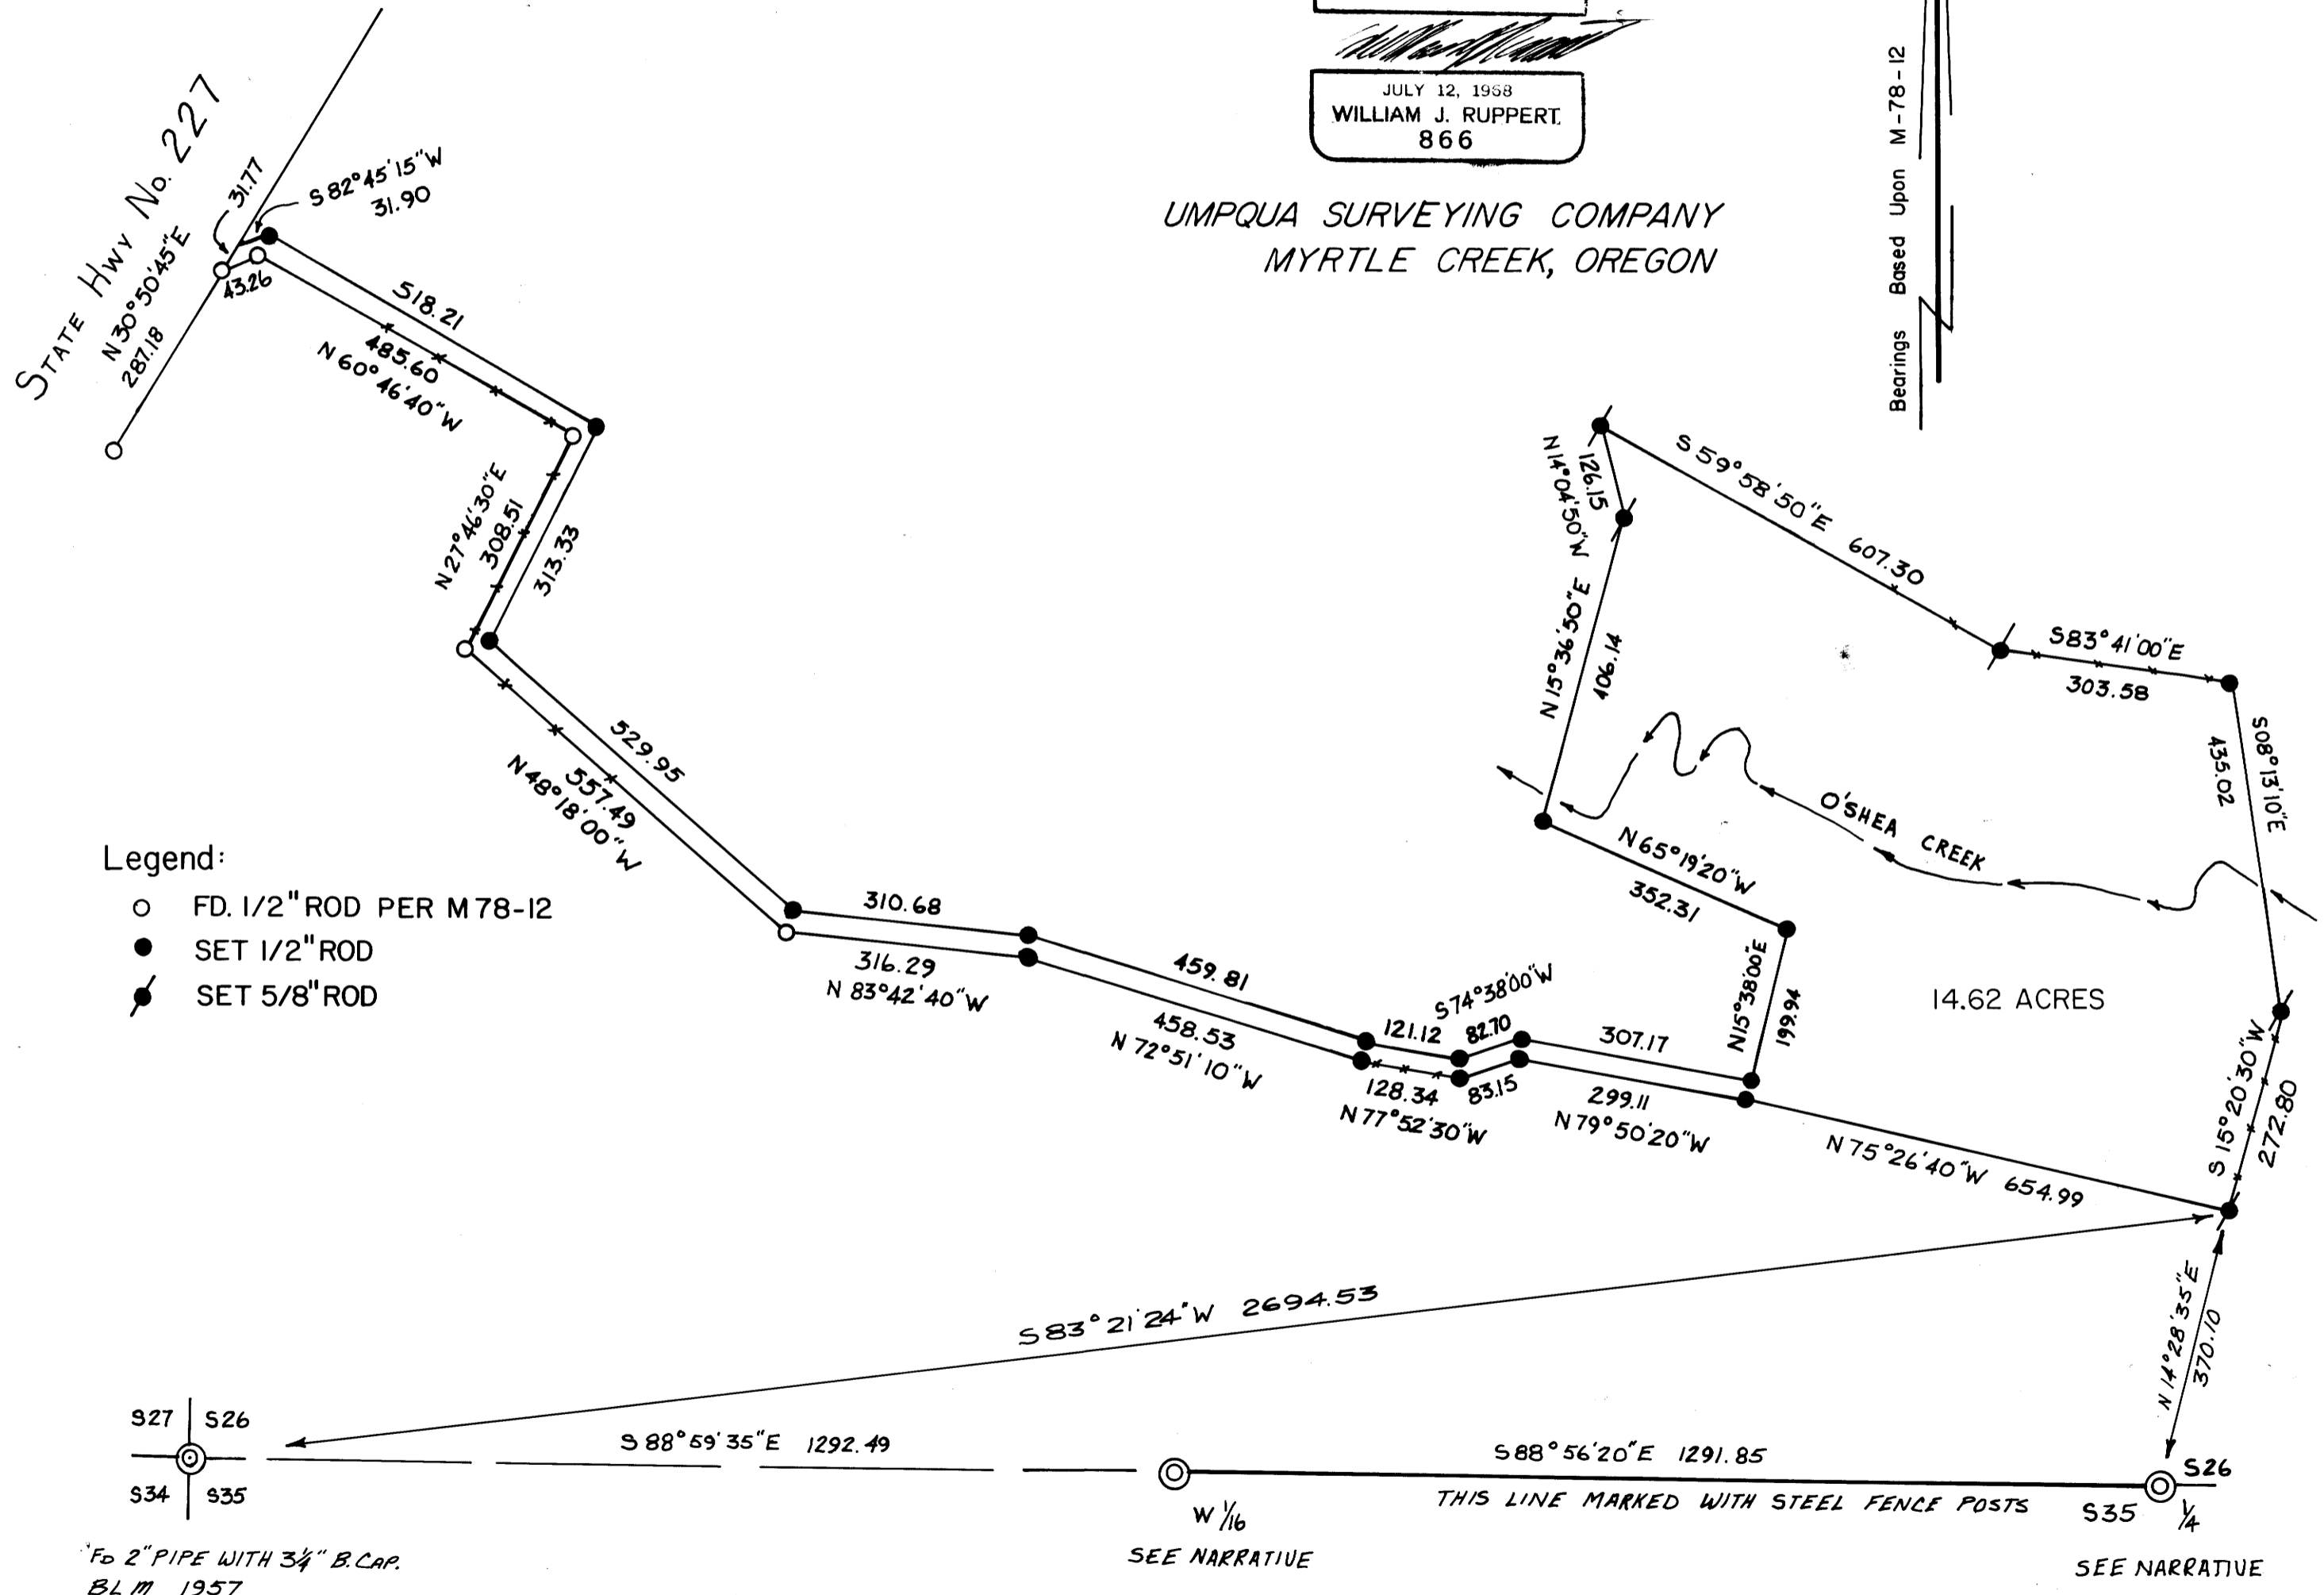

C.S. File 58/143(W)
Map File M82760

C.S. File 58/143(W)
Map File M82760

FO 2" PIPE WITH 3/4" B. CAP.
BLM 1957

M 82-60

UMPQUA SURVEYING COMPANY

P. O. Box 791
Myrtle Creek, Oregon 97457



626 N.E. Division Street
Telephone (503) 863-5201

Page 1 of 2

NARRATIVE FOR JACK PICKETT

PURPOSE: To write Deed Description for parcel larger than ten acres with 25 feet wide access strip. Also to post part of section line.

LOCATION: South half of Section 26, Township 30 South, Range 5 West, Willamette Meridian.

DATE: March 1980

FILED *J*
RECEIVED *JH*

BASIS OF BEARINGS: Solar Observation per M78-12

MAR 27 1980

EQUIPMENT: Angles: Lietz T60D #137424
Lietz T60D #147423
Distances: Traverse-MAC II -
Less than 50' steel tape

COUNTY SURVEYOR
DOUGLAS COUNTY, ORE.

J

CLOSURE: Better than 1:10,000

SURVEYOR: Umpqua Surveying Company
626 Division Street
P. O. Box 791
Myrtle Creek, OR 97457
863-5201

Narrative for Jack Pickett, cont.

W 1/16 $\frac{S26}{S35}$:

FOUND: 2" pipe with 3 1/4" Brass cap marked,
"U.S. Dept. of the Interior

W 1/16 $\frac{S26}{S35}$

Cadastral Survey

Bur. of Land Management"

10" White Oak North 06⁰-27' East 94.6 Ft. good scar

18" Incense Cedar South 51⁰-42' East 16.6 Ft. good scar

FILED *J*
RECEIVED *JH*

MAR 27 1980

COUNTY SURVEYOR
DOUGLAS COUNTY, ORE.

1/4 $\frac{S26}{S35}$:

FOUND: 2" pipe with 3 1/4" Brass cap marked,
"U.S. Dept. of the Interior

T30S R5W

1/4 $\frac{S26}{S35}$

1967

Cadastral Survey

Bureau of Land Management"

18" Madrone South 49⁰-40' West 37.9 Ft. good scar

16" D. Fir North 21⁰-10' East 55.4 Ft. good scar

16" D. Fir Stump South 33⁰-42' West 5.1 Ft. good scar

REGISTERED
OREGON
LAND SURVEYOR

[Signature]
JULY 12, 1968
WILLIAM J. RUPPERT
866