


COUNTY SURVEYORS FILE DATA
DO NOT REMOVE FROM OFFICE

SURVEY FOR PROPERTY CORNERS

IN LOT 1 BLOCK 1 SUBDIVISION OF LOT 23 IN BLOCK 3 SUKSDORF COOS JUNCTION ORCHARD TRACTS
NE 1/4 SECTION 21 T.28S. R.6W. W.M. — SCALE: 1"=50' — APRIL 1980

FOR: DOROTHY LAUGHLIN
BY: A A SURVEYING SERVICE, INC.
P.O. BOX 454, ROSEBURG, OREGON 97470

FILED DP
RECEIVED φ
APR 11 1980
COUNTY SURVEYOR
DOUGLAS COUNTY, ORE.
K5

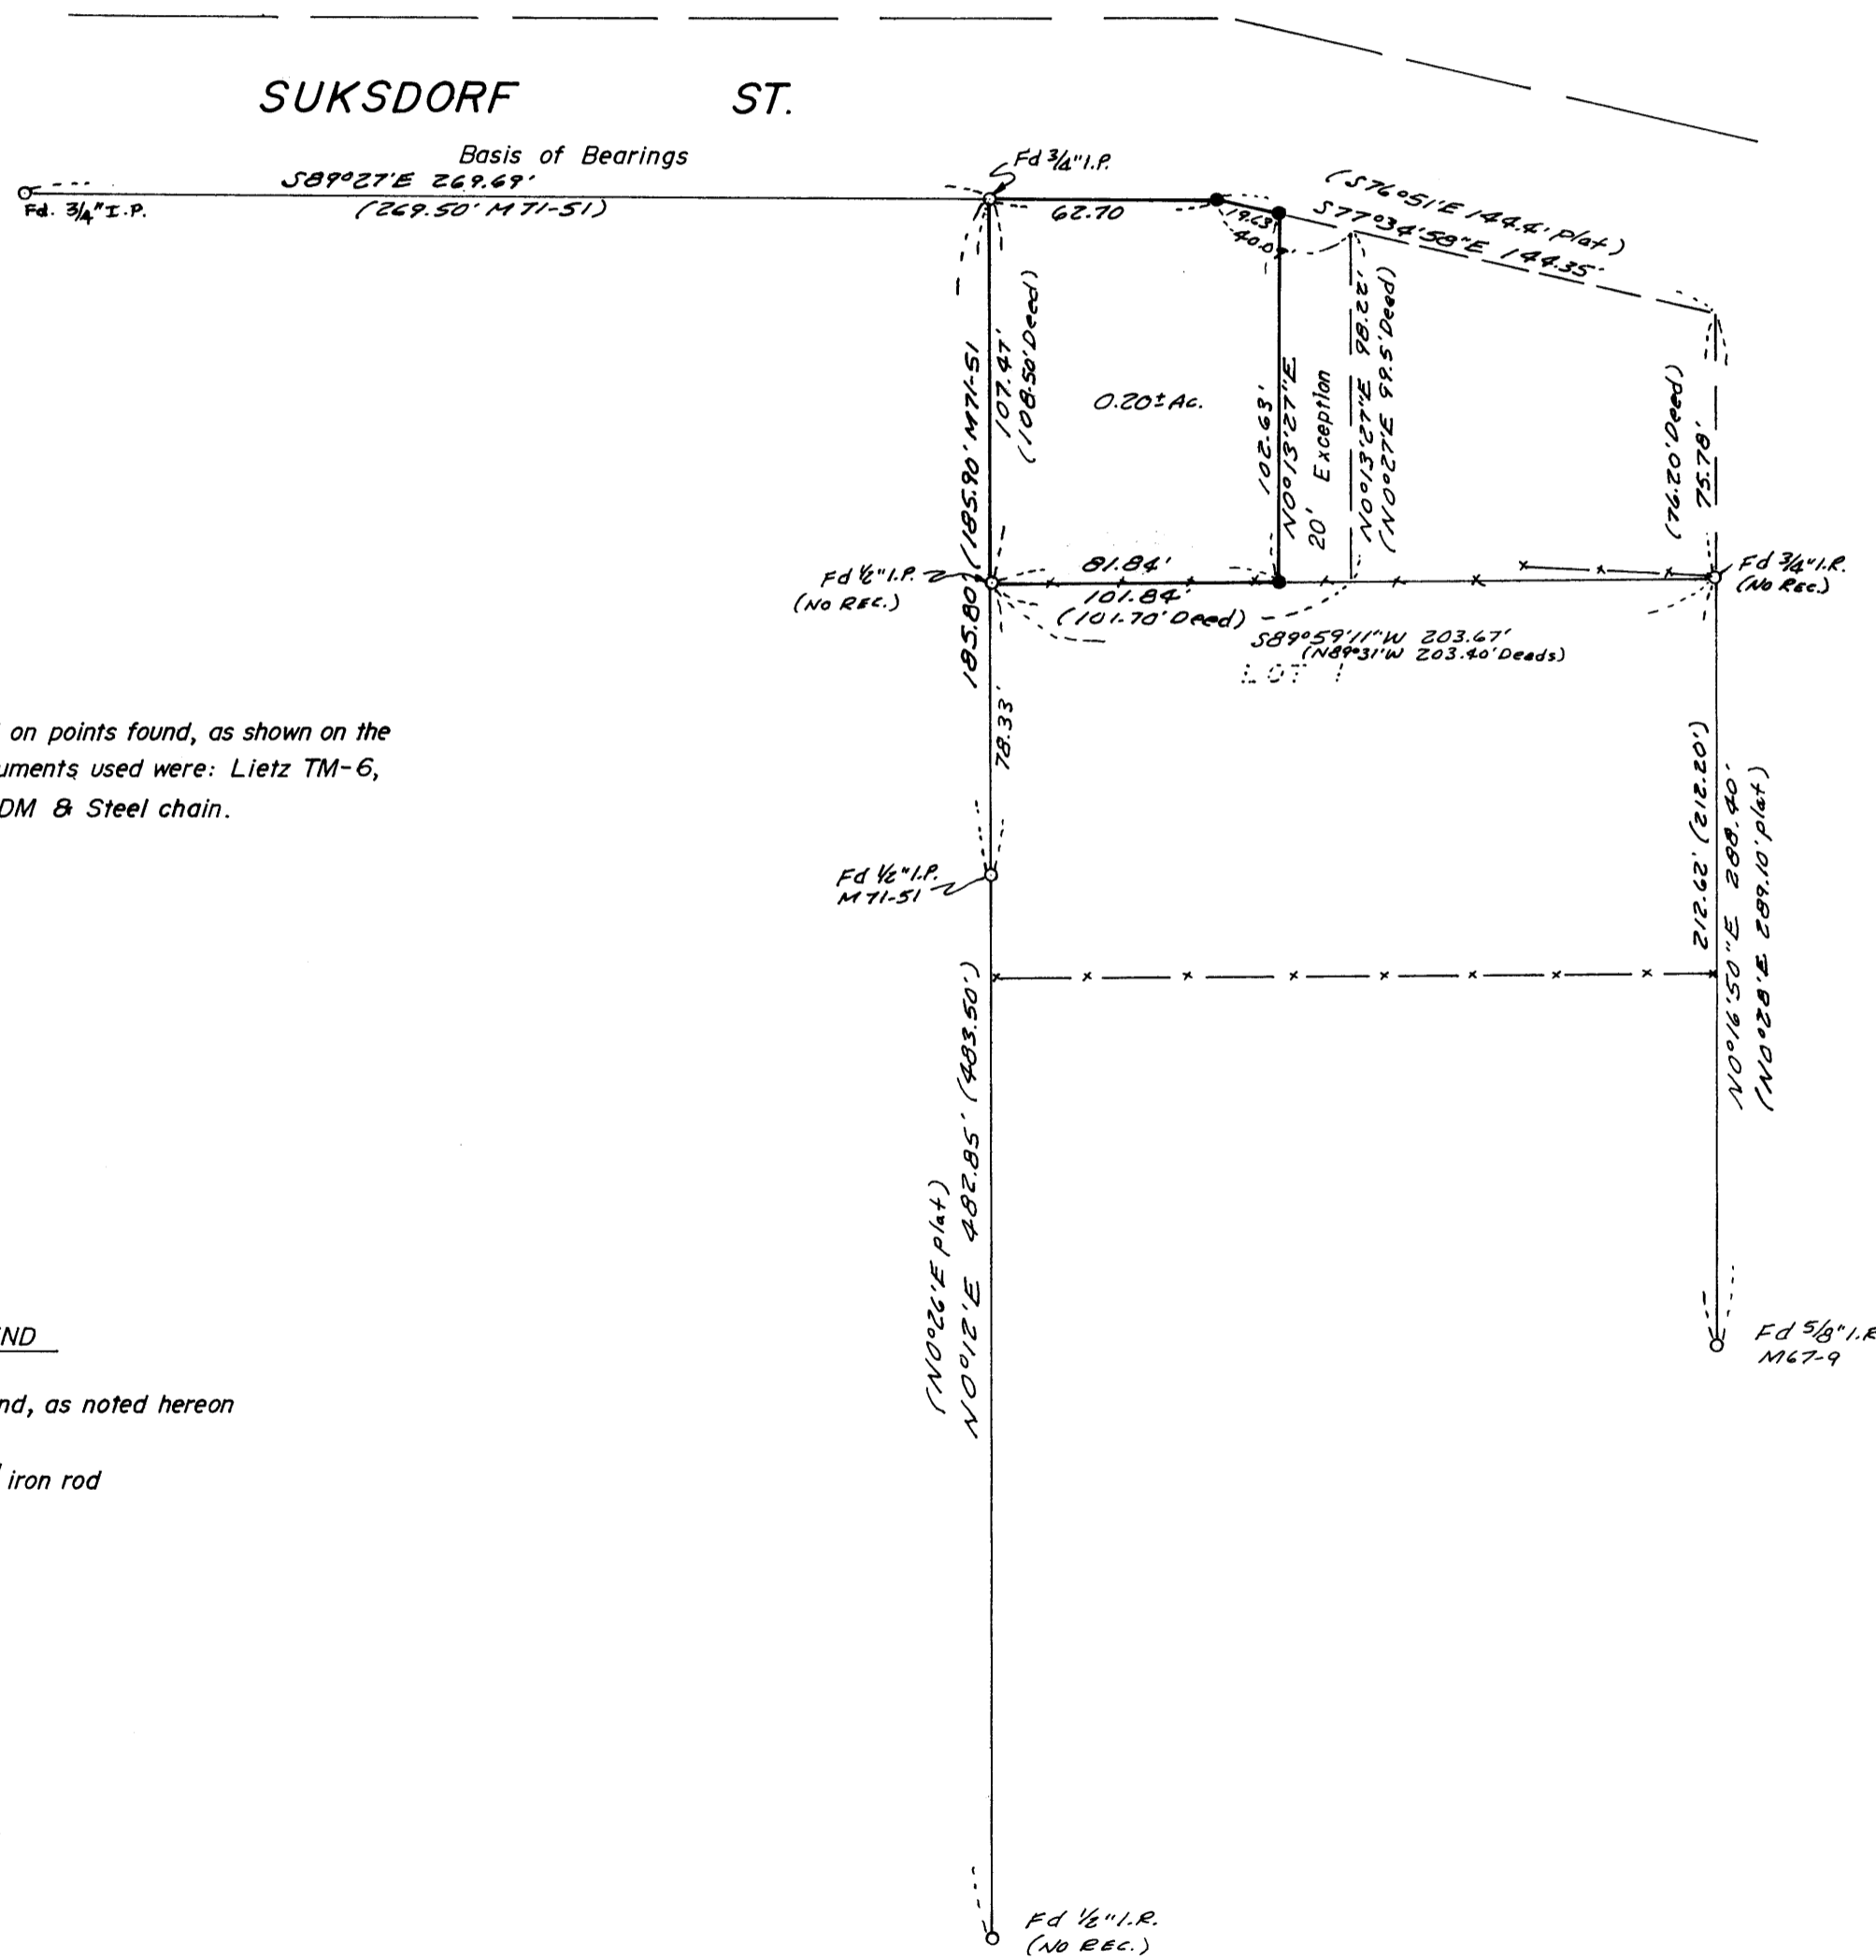

NARRATIVE:

This survey is based on points found, as shown on the annexed map. The instruments used were: Lietz TM-6, K & E Auto Ranger EDM & Steel chain.

LEGEND

- — Point found, as noted hereon
- — Set 5/8" iron rod



REGISTERED
PROFESSIONAL
LAND SURVEYOR

Eugene A. Bloom

OREGON
MAY 13, 1980
EUGENE A. BLOOM
492