

SURVEYORS FILE DATA
DO NOT REMOVE FROM OFFICE

FILED ✓
RECEIVED ✓

JUN 18 1980

COUNTY SURVEYOR
DOUGLAS COUNTY, ORE.


Survey in Section 29, T. 32 S., R. 2 W., W.M.

For the U.S. DEPARTMENT OF AGRICULTURE, UMPQUA NATIONAL FOREST

Contract No. 53 04HI 0 7669 N


Tiller Land Survey No. 38

May 1980

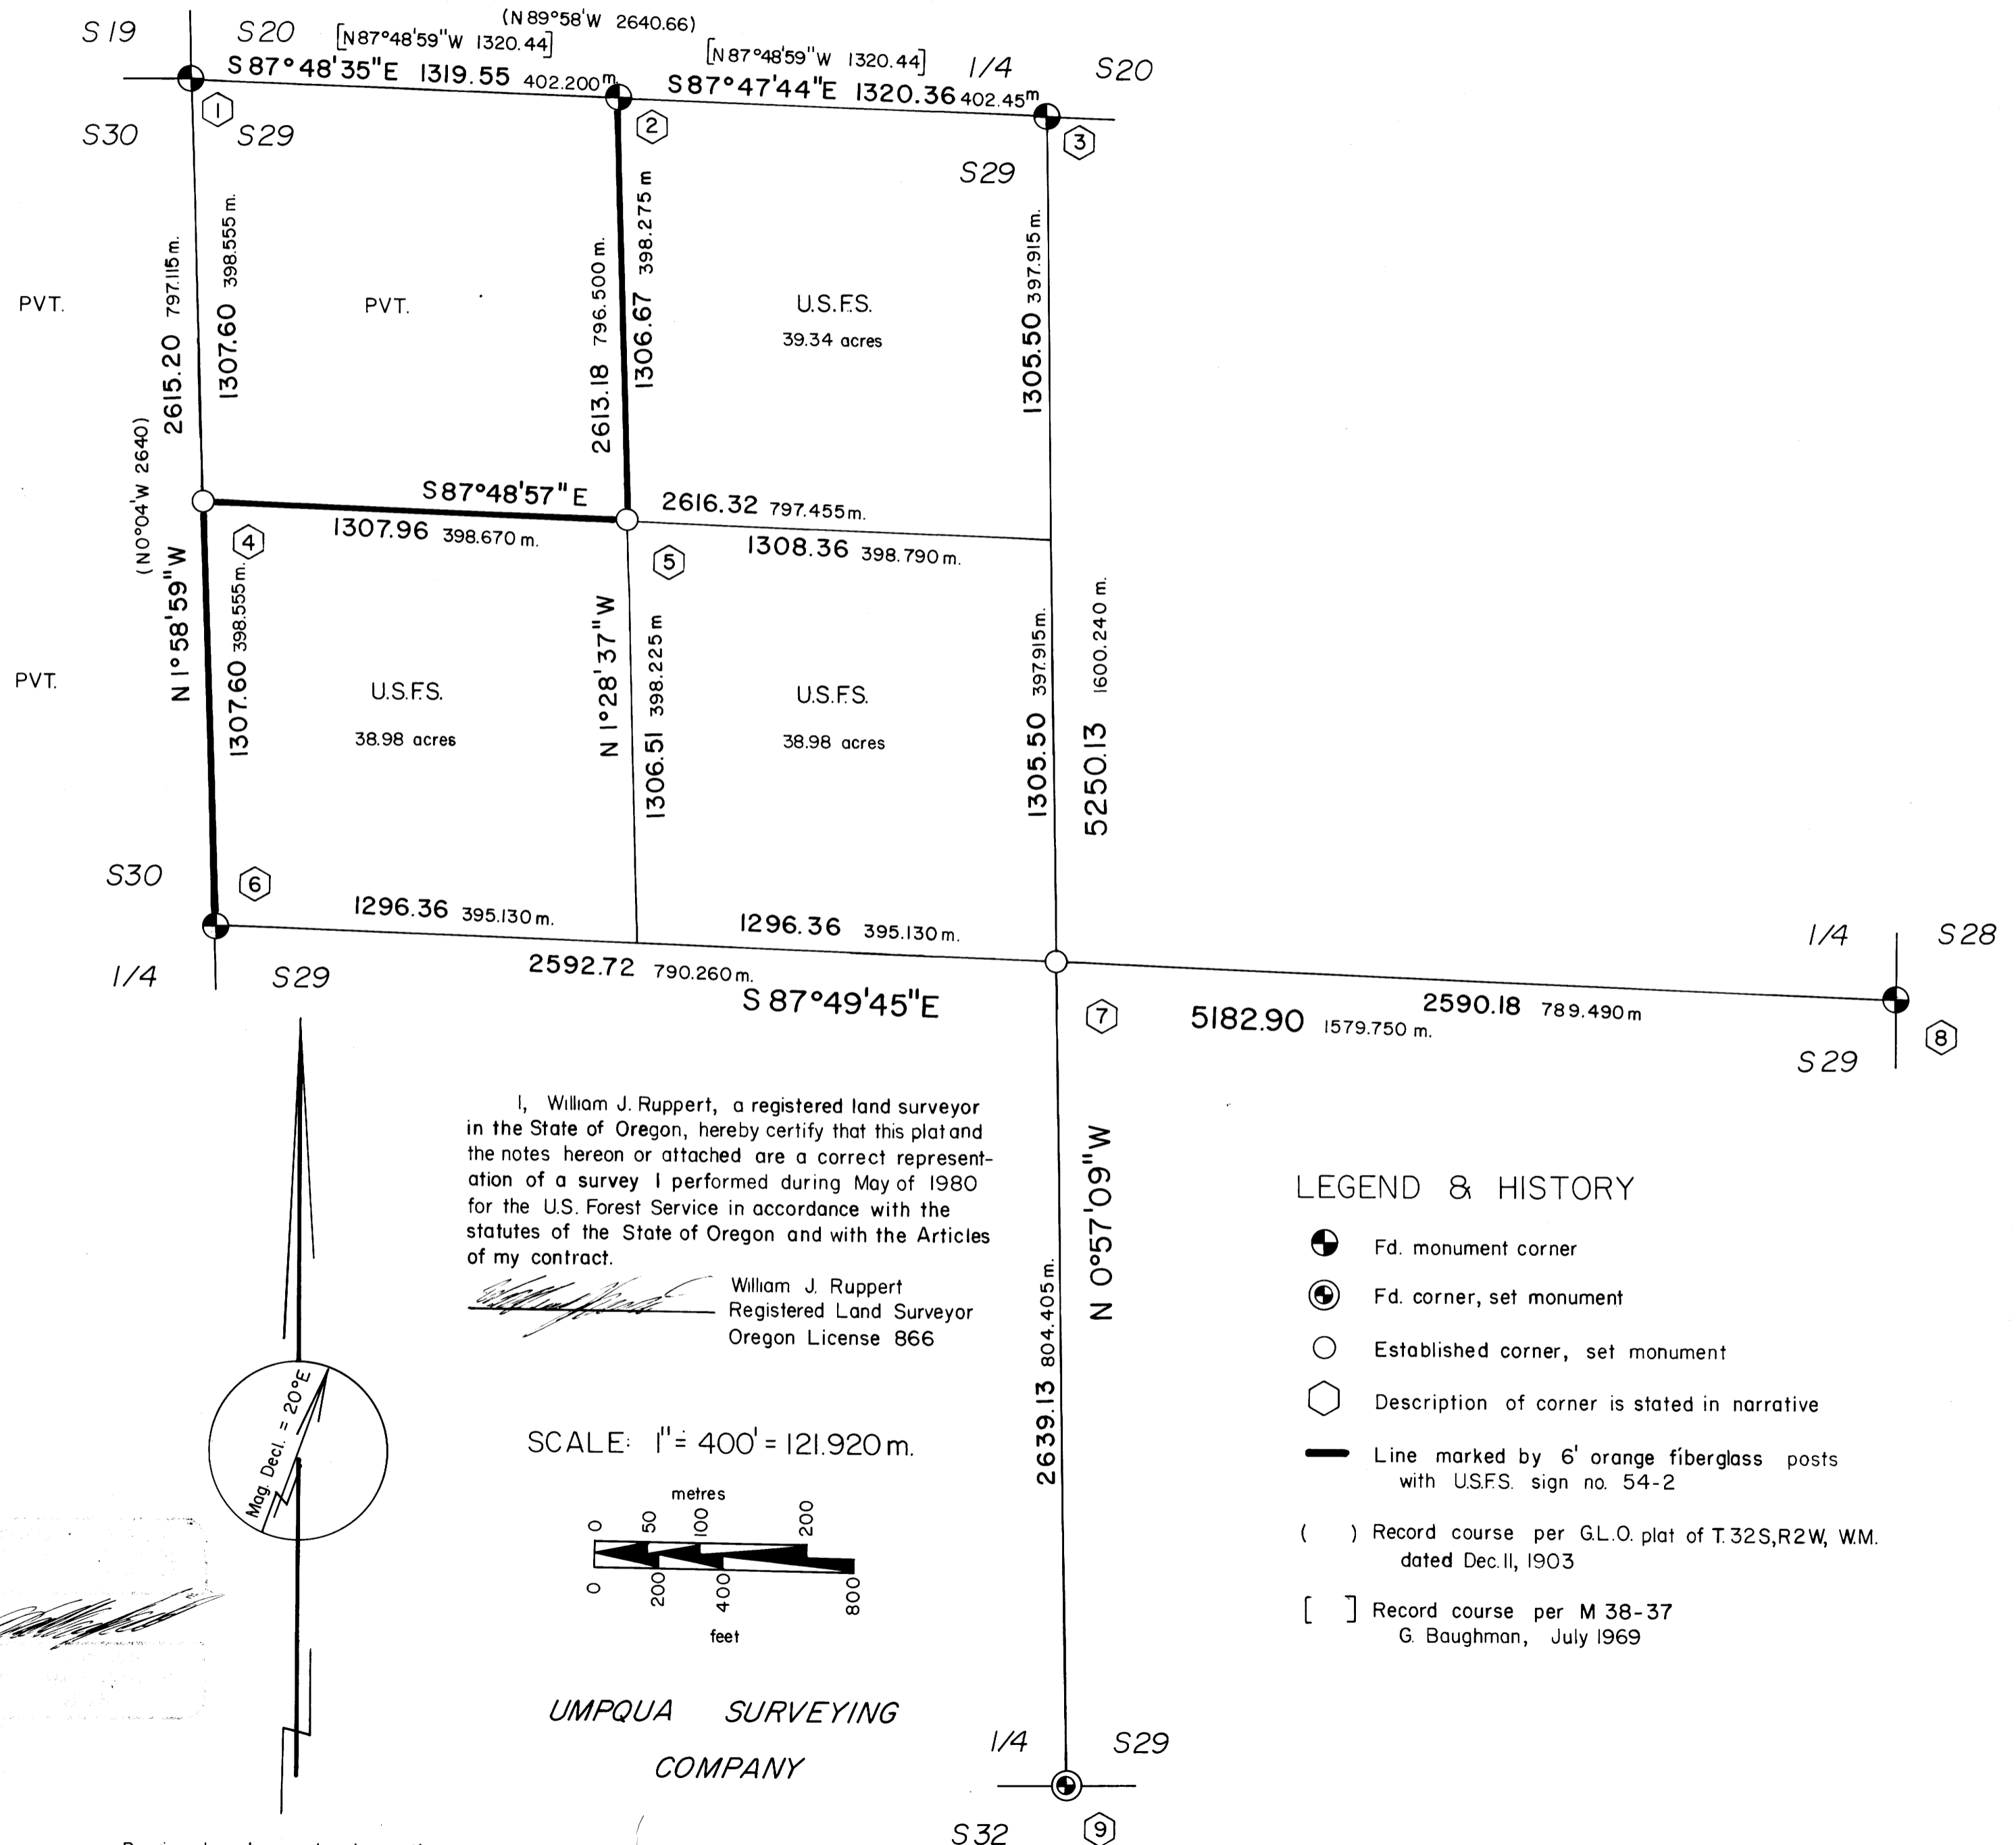


I, William J. Ruppert, a registered land surveyor in the State of Oregon, hereby certify that this plat and the notes hereon or attached are a correct representation of a survey I performed during May of 1980 for the U.S. Forest Service in accordance with the statutes of the State of Oregon and with the Articles of my contract.

William J. Ruppert
 William J. Ruppert
 Registered Land Surveyor
 Oregon License 866

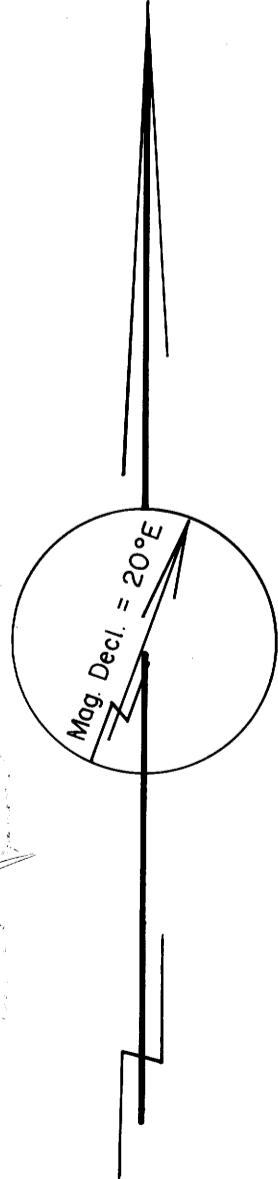

SCALE: 1" = 400' = 121.920 m.

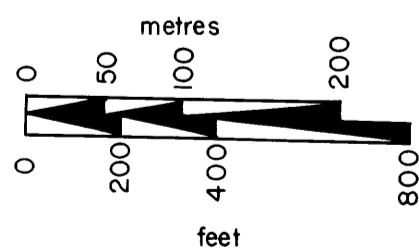

UMPQUA SURVEYING
COMPANY

LEGEND & HISTORY

- Fd. monument corner
- ⊙ Fd. corner, set monument
- Established corner, set monument
- ⬡ Description of corner is stated in narrative
- Line marked by 6' orange fiberglass posts with USFS. sign no. 54-2
- () Record course per G.L.O. plat of T.32S,R2W, W.M. dated Dec. II, 1903
- [] Record course per M 38-37 G. Baughman, July 1969

Bearings based upon solar observation

M84-5

UMPQUA SURVEYING COMPANY

P. O. Box 791
Myrtle Creek, Oregon 97457

626 N.E. Division Street
Telephone (503) 863-5201

FILED
RECEIVED

JUN 18 1980

COUNTY SURVEYOR
DOUGLAS COUNTY, ORE.

Page 1 of 3.


SURVEY NARRATIVE

May 1980

- LOCATION: SECTION 29, TOWNSHIP 32 SOUTH, RANGE 2 WEST, WILLAMETTE MERIDIAN
- PURPOSE: TO SUBDIVIDE SECTION 29 & MARK LINES AS SHOWN ON THE SURVEY PLAT.
- EVIDENCE: FOUND CORNER MONUMENTS AND EVIDENCE AS DESCRIBED BELOW.
- CONCLUSIONS: ACCEPTED ORIGINAL CORNERS FROM EVIDENCE SHOWN BELOW. ACCEPTED PROPORTIONED CORNERS SET PER M38-37 AS BEING WITHIN ACCEPTABLE LIMITS OF PROPORTIONED POSITIONS, AFTER SEARCHING AGAIN FOR EVIDENCE OF ORIGINAL CORNERS.
- EQUIPMENT: LEITZ T60D THEODOLITES, BEETLE & MAC EDM EQUIPMENT.

DESCRIPTIONS OF CORNERS NUMBERED
ON SURVEY PLAT
SEC. 29
T32S, R2W

1. FOUND: 2" Galvanized iron pipe with 3" Brass cap marked as shown.
Original stone is in mound around cap.

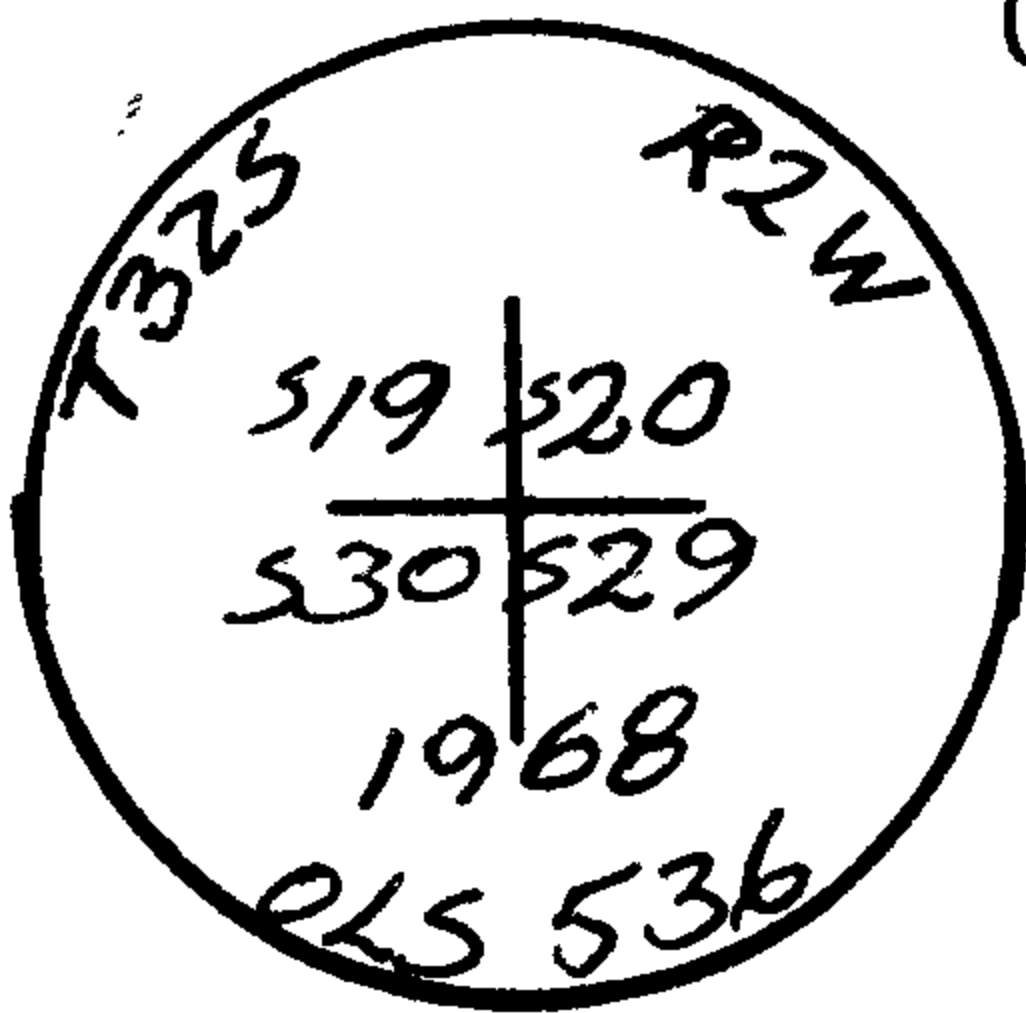

- 22" Snag S14⁰-43' E 42.35 "T32S R2W S29 BT" visible. "X" in bark.
- 53" D. Fir N70⁰-00' E 31.3 ft "T32S R2W S20 BT" visible
- 28" Hemlock N6⁰-10' W 27.7 ft "W" visible
- 36" Uproot S17⁰-35' W 18.0 ft "T32S R2W S30 BT" visible

- NEW BT: 11" Yew S31⁰-40' E 32.0 ft "T32 R2W S29 BT"
- 6" Madrone S6⁰-52' W 5.5 ft "T32S R2W S30 BT"

Attached 3/4" Brass washer marked "LS 866" to lower blaze of each new BT.

#113


REGISTERED
OREGON
LAND SURVEYOR

William J. Ruppert
JULY 12, 1968
WILLIAM J. RUPPERT
866

C. S. File No. 58/133-237


M84-5

2. FOUND: 2" galvanized iron pipe 2½" Brass cap marked as shown.

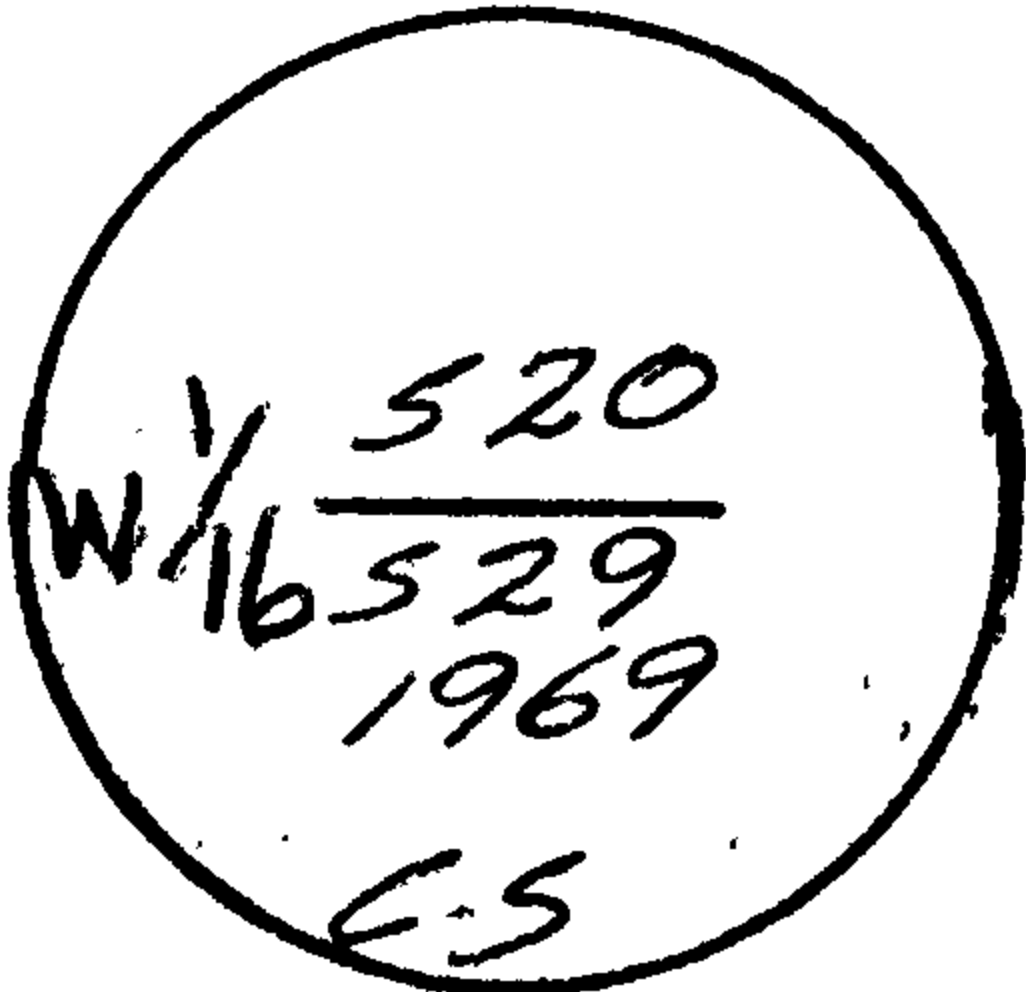


13" Madrone S2° E 14.1 ft "N1/16 S29 CS BT" visible
14" D. Fir N1° W 22.8 ft "N1/16 S20 CS BT" visible

3. FOUND: 2" galvanized pipe and 2½" Brass cap marked as shown

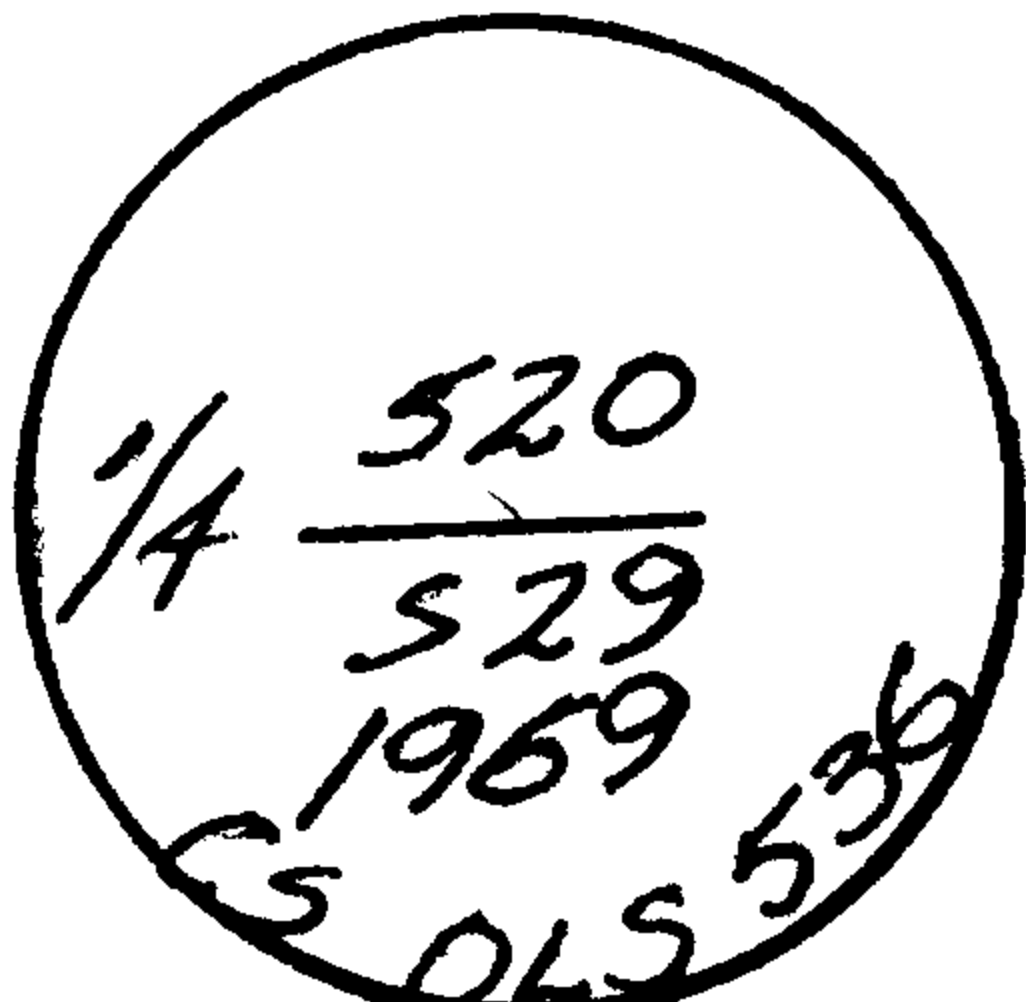

11" D. Fir N24° W 19.6 ft. Good scars
13" D. Fir S03° E 13.8 ft. Good scars

4. SET: 2" x 30" aluminum pipe with 2½" magnetized aluminum cap marked as shown.

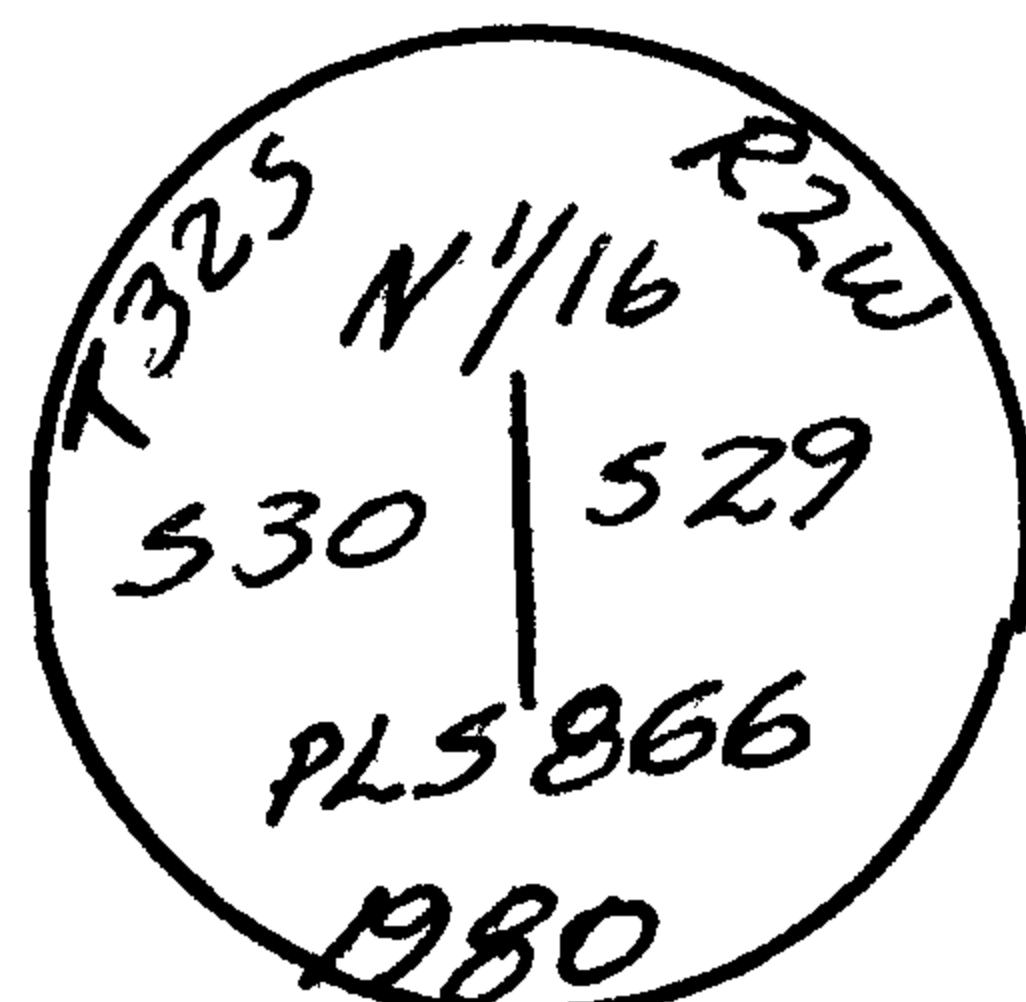

Built cairn to cap.

NEW BT: 10" Pine S0°-20' W 28.4 ft "N1/16 S30 BT"
12" D. Fir S53°-40' E 47.8 ft "N1/16 S29 BT"

Attached 3/4" Brass washer marked "LS 866" to lower blaze of each new BT.

5. SET: 2" x 30" aluminum pipe with 2½" aluminum cap marked as shown.




No rocks available for mound.

NEW BT: 14" D. Fir N24°-15' W 14.2 ft. Scribed "NW1/16 S29 BT"
12" D. Fir N35°-25' W 6.8 ft. Scribed "NW1/16 S29 BT"


Attached 3/4" Brass washer marked "LS 866" to lower blaze of each new BT.

6. FOUND: 1" galvanized iron pipe with 2 1/2" brass cap marked as shown.

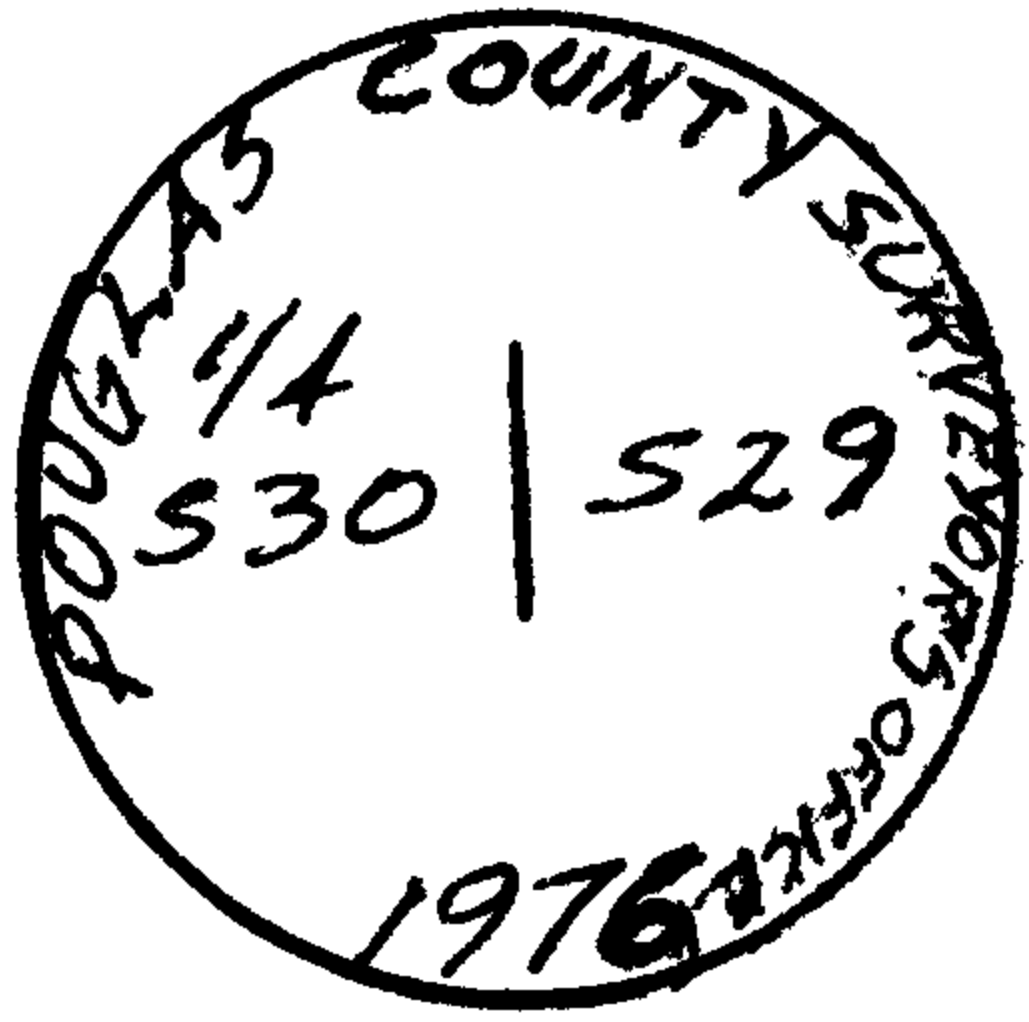

42" Snag S51⁰-54' W 29.3 ft. "S30 BT" on old face.
34" D. Fir N66⁰-06' W 36.9 ft "1/4 S30 CS BT" visible
12" D. Fir N9⁰-54' E 22.4 ft "1/4 S29 BT" visible

7. SET: 2" x 30" aluminum pipe 28" into the ground and marked the 2 1/2" attached Brass cap as shown.

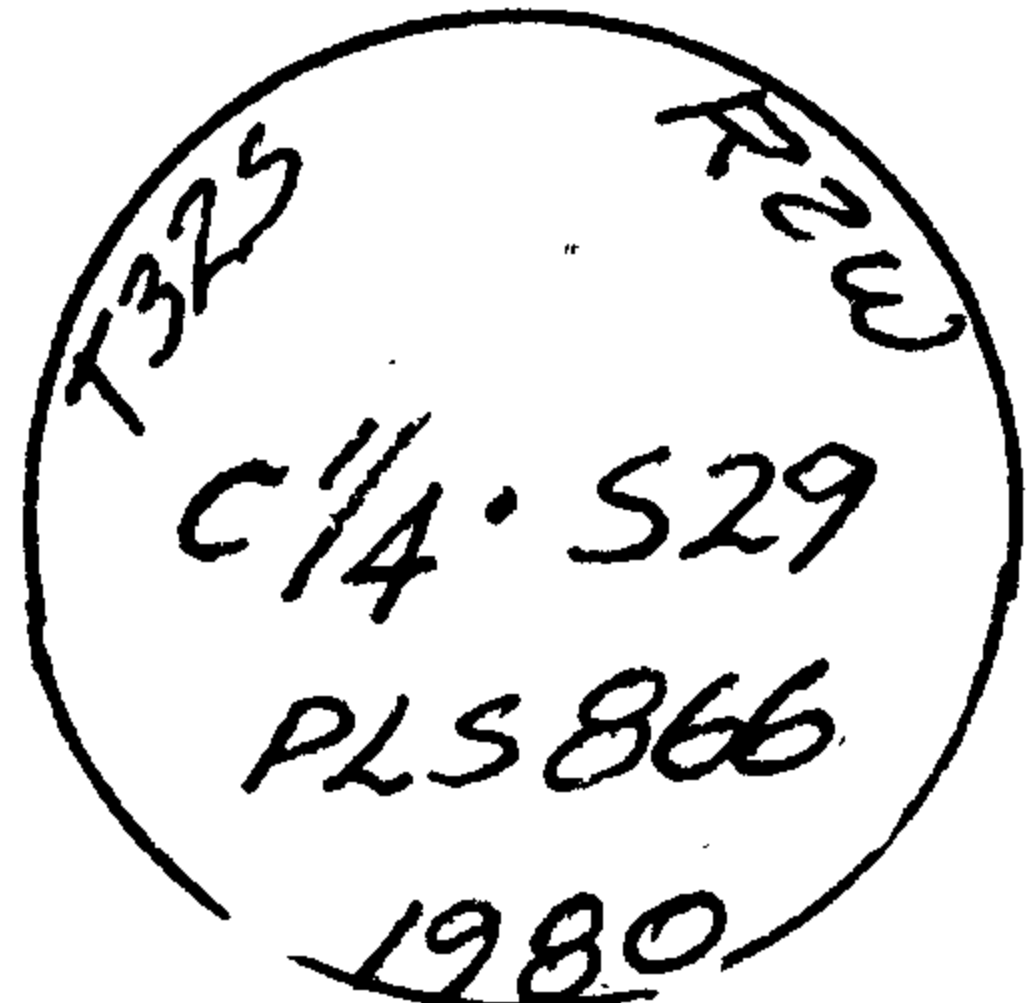

Constructed mound of stones around the pipe.


NEW BT: 10" D. Fir S35⁰-27' E 9.4 ft Scribed "1/4 S29 BT"

21" Pine N6⁰-53' W 14.7 ft Scribed "1/4 S29 BT"

Attached 3/4" Brass washer marked "LS 866" to lower blaze of each new BT.

#114

8. FOUND: 2" galvanized pipe with 3" Brass cap marked as shown

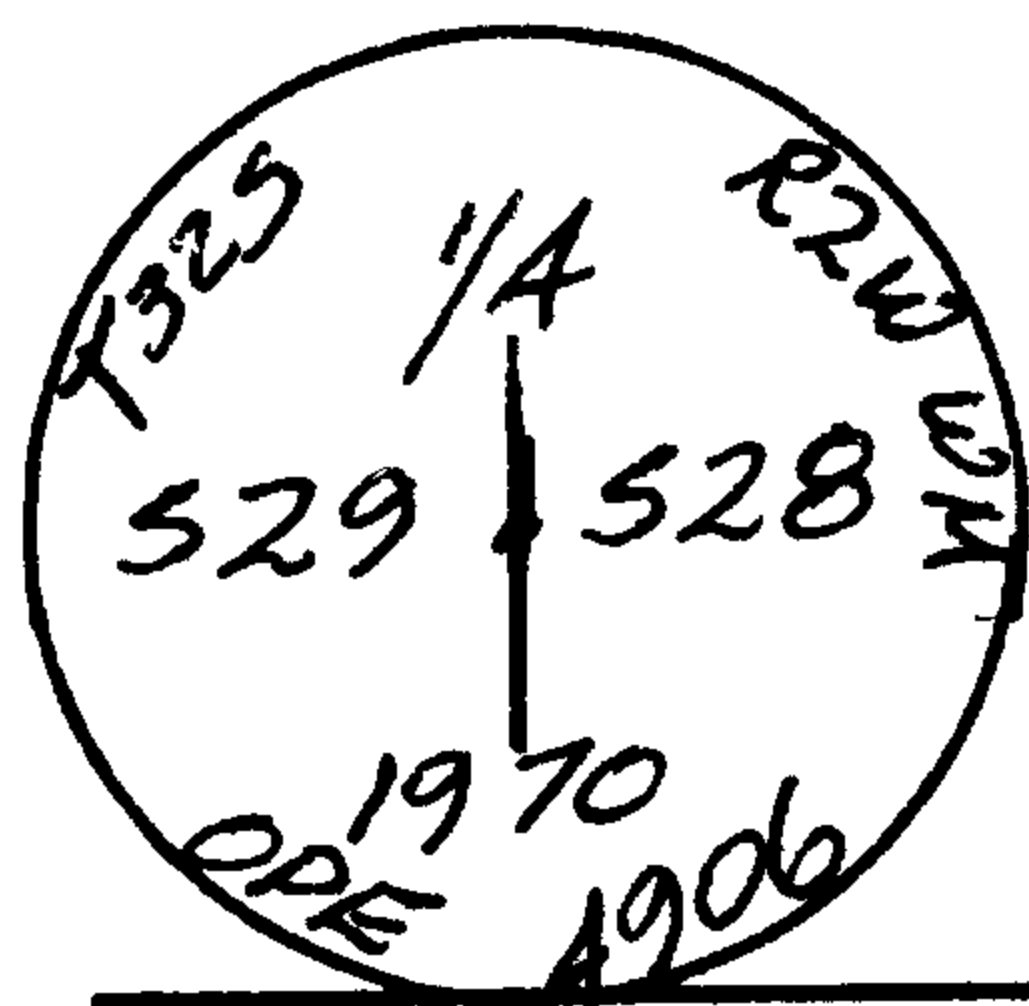

48" D. Fir N31⁰-34' W 15.0 ft "1/4 S29 BT" visible

15" Rotten Fir stump N0⁰-54' W 22.6 ft "1/4 S" visible

38" D. Fir S34⁰-34' E 9.8 ft "1/4 S28 BT" visible


12" Rotten stump S78⁰-30' E 13.3 ft.

9. FOUND: 12" x 12" x 5" stone with 1/4 on north side of stone

Rotten stump hole S25⁰-30' E 15.7 ft.

Rotten Hemlock stump N26⁰ W 7.0 ft "1/4 S" visible

SET: 2" x 30" aluminum pipe with 2 1/2" aluminum cap stamped as shown at position of found stone.

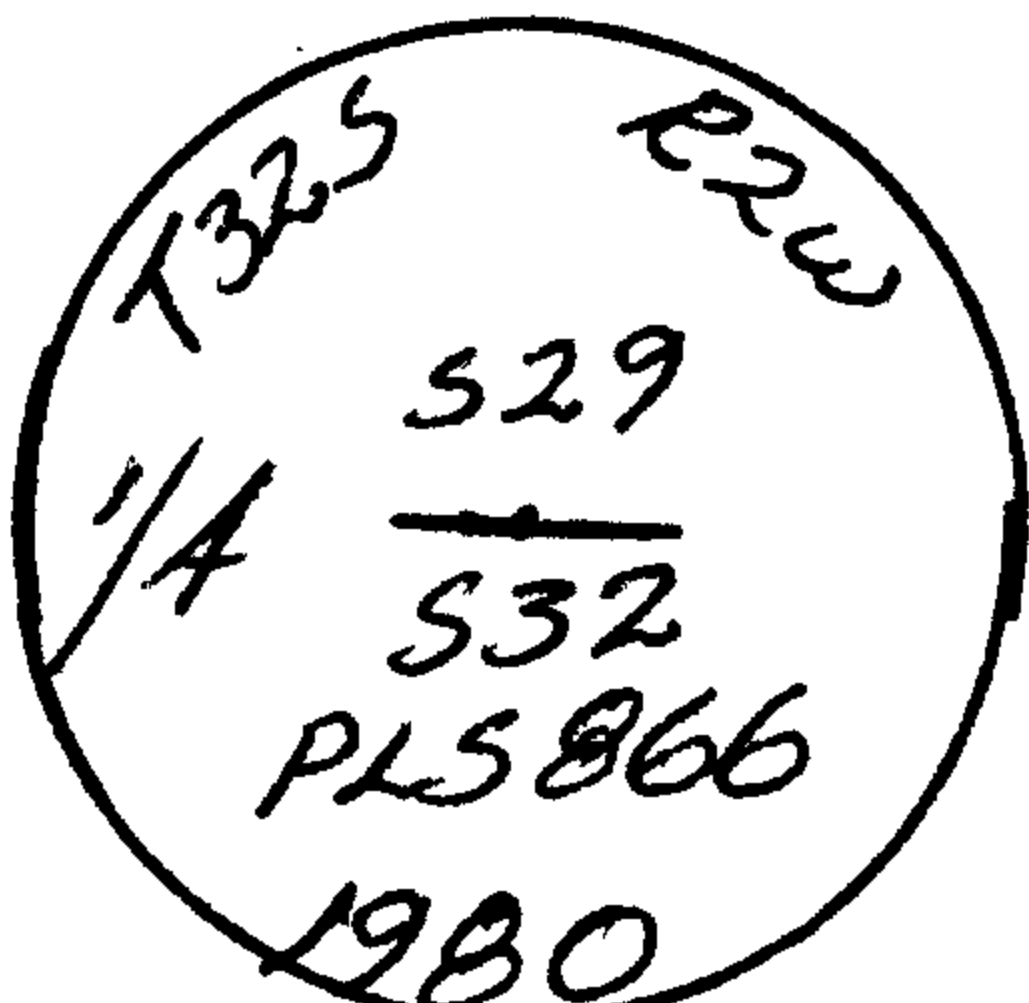

Constructed mound of stones around pipe. Buried stone along side pipe.

NEW BT: 15" W. Fir N83⁰-30' E 14.5 ft Scribed "1/4 S29 BT"

8" D. Fir N3⁰-45' W 19.7 ft Scribed "1/4 S29 BT"

8" Chinquapin S67⁰-36' E 11.7 ft Scribed "1/4 S32 BT"

Attached 3/4" Brass washer marked "LS 866" to lower blaze of each new BT.

#115