

# SURVEY IN SE 1/4 SECTION 34, T.24S. R.6W.W.M.

FOR: BRIAN SHIRLEY  
BY: A A SURVEYING SERVICE, INC.

P.O. BOX 454, ROSEBURG, ORE. 97470

AUGUST 1980 — SCALE: 1"=200


COUNTY SURVEYORS FILE DATA  
DO NOT REMOVE FROM OFFICE

FILED \$  
RECEIVED \$

AUG 14 1980

COUNTY SURVEYOR  
WALSH COUNTY, ORE.

\$

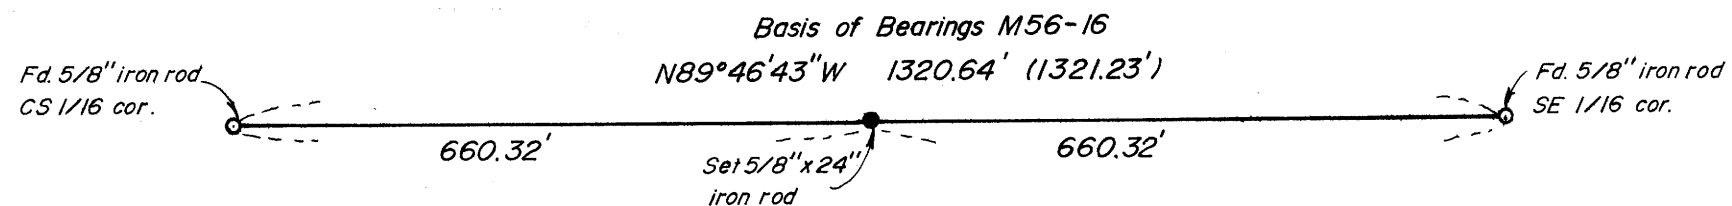

### NARRATIVE

The purpose of this survey is to set a point midway between the CS 1/16 corner and the SE 1/16 corner.

The field crew consisted of Darrell Jones and Mark Holt. The instruments used were: Leitz TM-6 Theodolite and K&E Auto Ranger E.D.M.

The point set was based upon a traverse tying in the 1/16 corners set in a previous survey filed under M56-16.

REGISTERED  
PROFESSIONAL  
LAND SURVEYOR

OREGON  
MAY 13, 1980  
EUGENE A. BLOOM  
492