

SURVEY IN SECTIONS 21 & 22, TOWNSHIP 27 SOUTH, RANGE 6 WEST, WILLAMETTE BASE & MERIDIAN
 Surveyed for L.E. Busenbark, & John O. Busenbark by James F. Gosson 1257 Washington, Roseburg, Ore. 97470

COUNTY SURVEYORS FILE DATA
DO NOT REMOVE FROM OFFICE

FILED *B.S.*
 RECEIVED

DEC 12 1980

COUNTY SURVEYOR
 DOUGLAS COUNTY, ORE.

B.S.

REGISTERED
 PROFESSIONAL
 LAND SURVEYOR

James F. Gosson

OREGON
 SEPTEMBER 23, 1977
 JAMES F. GOSSON
 1198


MELROSE RD. #13

MAP FILE *M 86-17*

- FOUND 5/8" IRON ROD
 - SET 5/8" IRON ROD
 - SURVEYED POINT, NOT SET
- BEARINGS BASED UPON DON GARRET SURVEY, MAP NUMBER M52-14, DOUGLAS COUNTY SURVEYORS OFFICE

NARRATIVE:

SURVEY FOR THE PURPOSE OF MONUMENTING TRACT 4 AS SHOWN ON MAP M52-14, ALSO FOR PARTITIONING A 60.42 AC.± PARCEL, AND FOR DESCRIBING AN EASEMENT NOTE: THIS EASEMENT, STATION P.C. 4+88.43 COINCIDES WITH EASEMENT STATION 4+88.43 AS SHOWN ON MAP 49-36. NOTE, ALSO, STATIONING OF THIS EASEMENT CONTINUES WESTERLY FROM STATION P.C. 4+88.43.
 EQUIPMENT: THEODOLITE & E.D.M., TRANSIT & CHAIN.
 COMPUTATIONS: L. BUSENBARK
 DRAFTING: R. FOUT
 FIELD CREW: J. GOSSON, K. KARLINGER, & L. BUSENBARK
 REFERENCE SURVEYS: M 52-14, & 49-36.

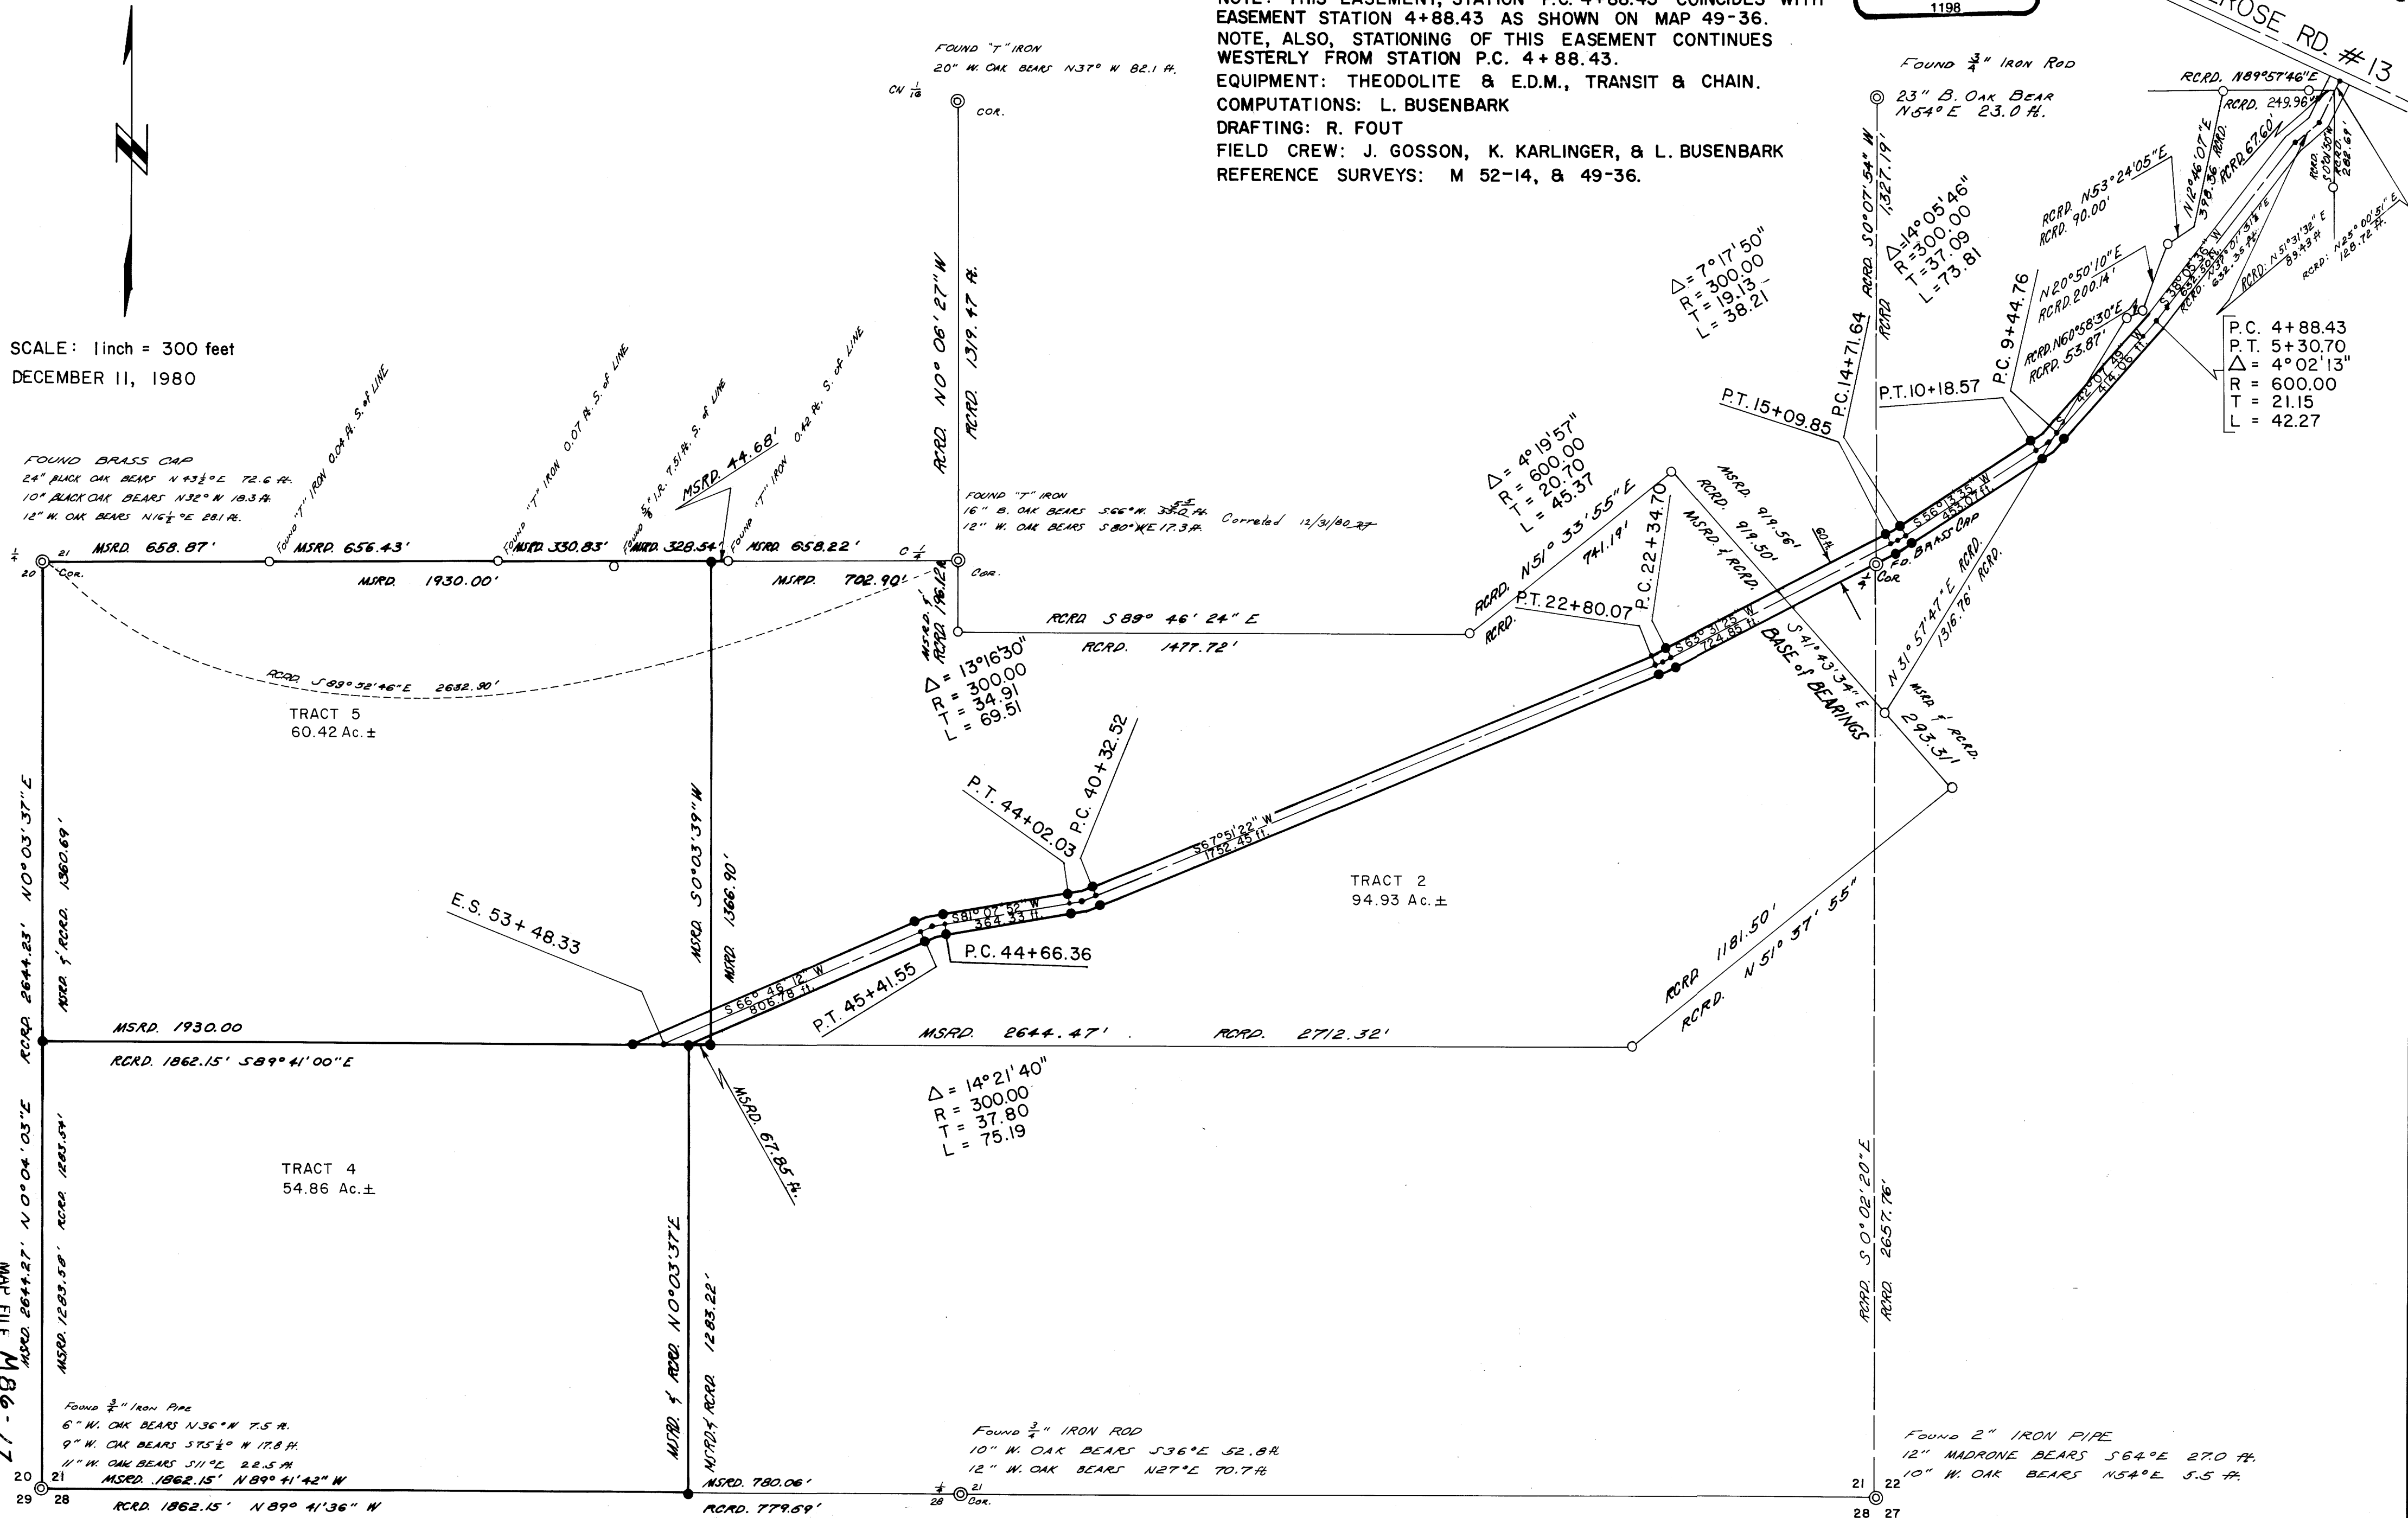

SCALE: 1 inch = 300 feet
 DECEMBER 11, 1980

MAP FILE *M 86-17*