


COUNTY SURVEYORS FILE DATA
DO NOT REMOVE FROM OFFICE

PROPERTY SURVEY FOR INTERNATIONAL PAPER CO.

SEC. 12, T22S, R12W
SCALE 1" = 400' JAN. 1981

FILED BS
RECEIVED JK
FEB 24 1981
COUNTY SURVEYOR
DOUGLAS COUNTY, OREG.
BS

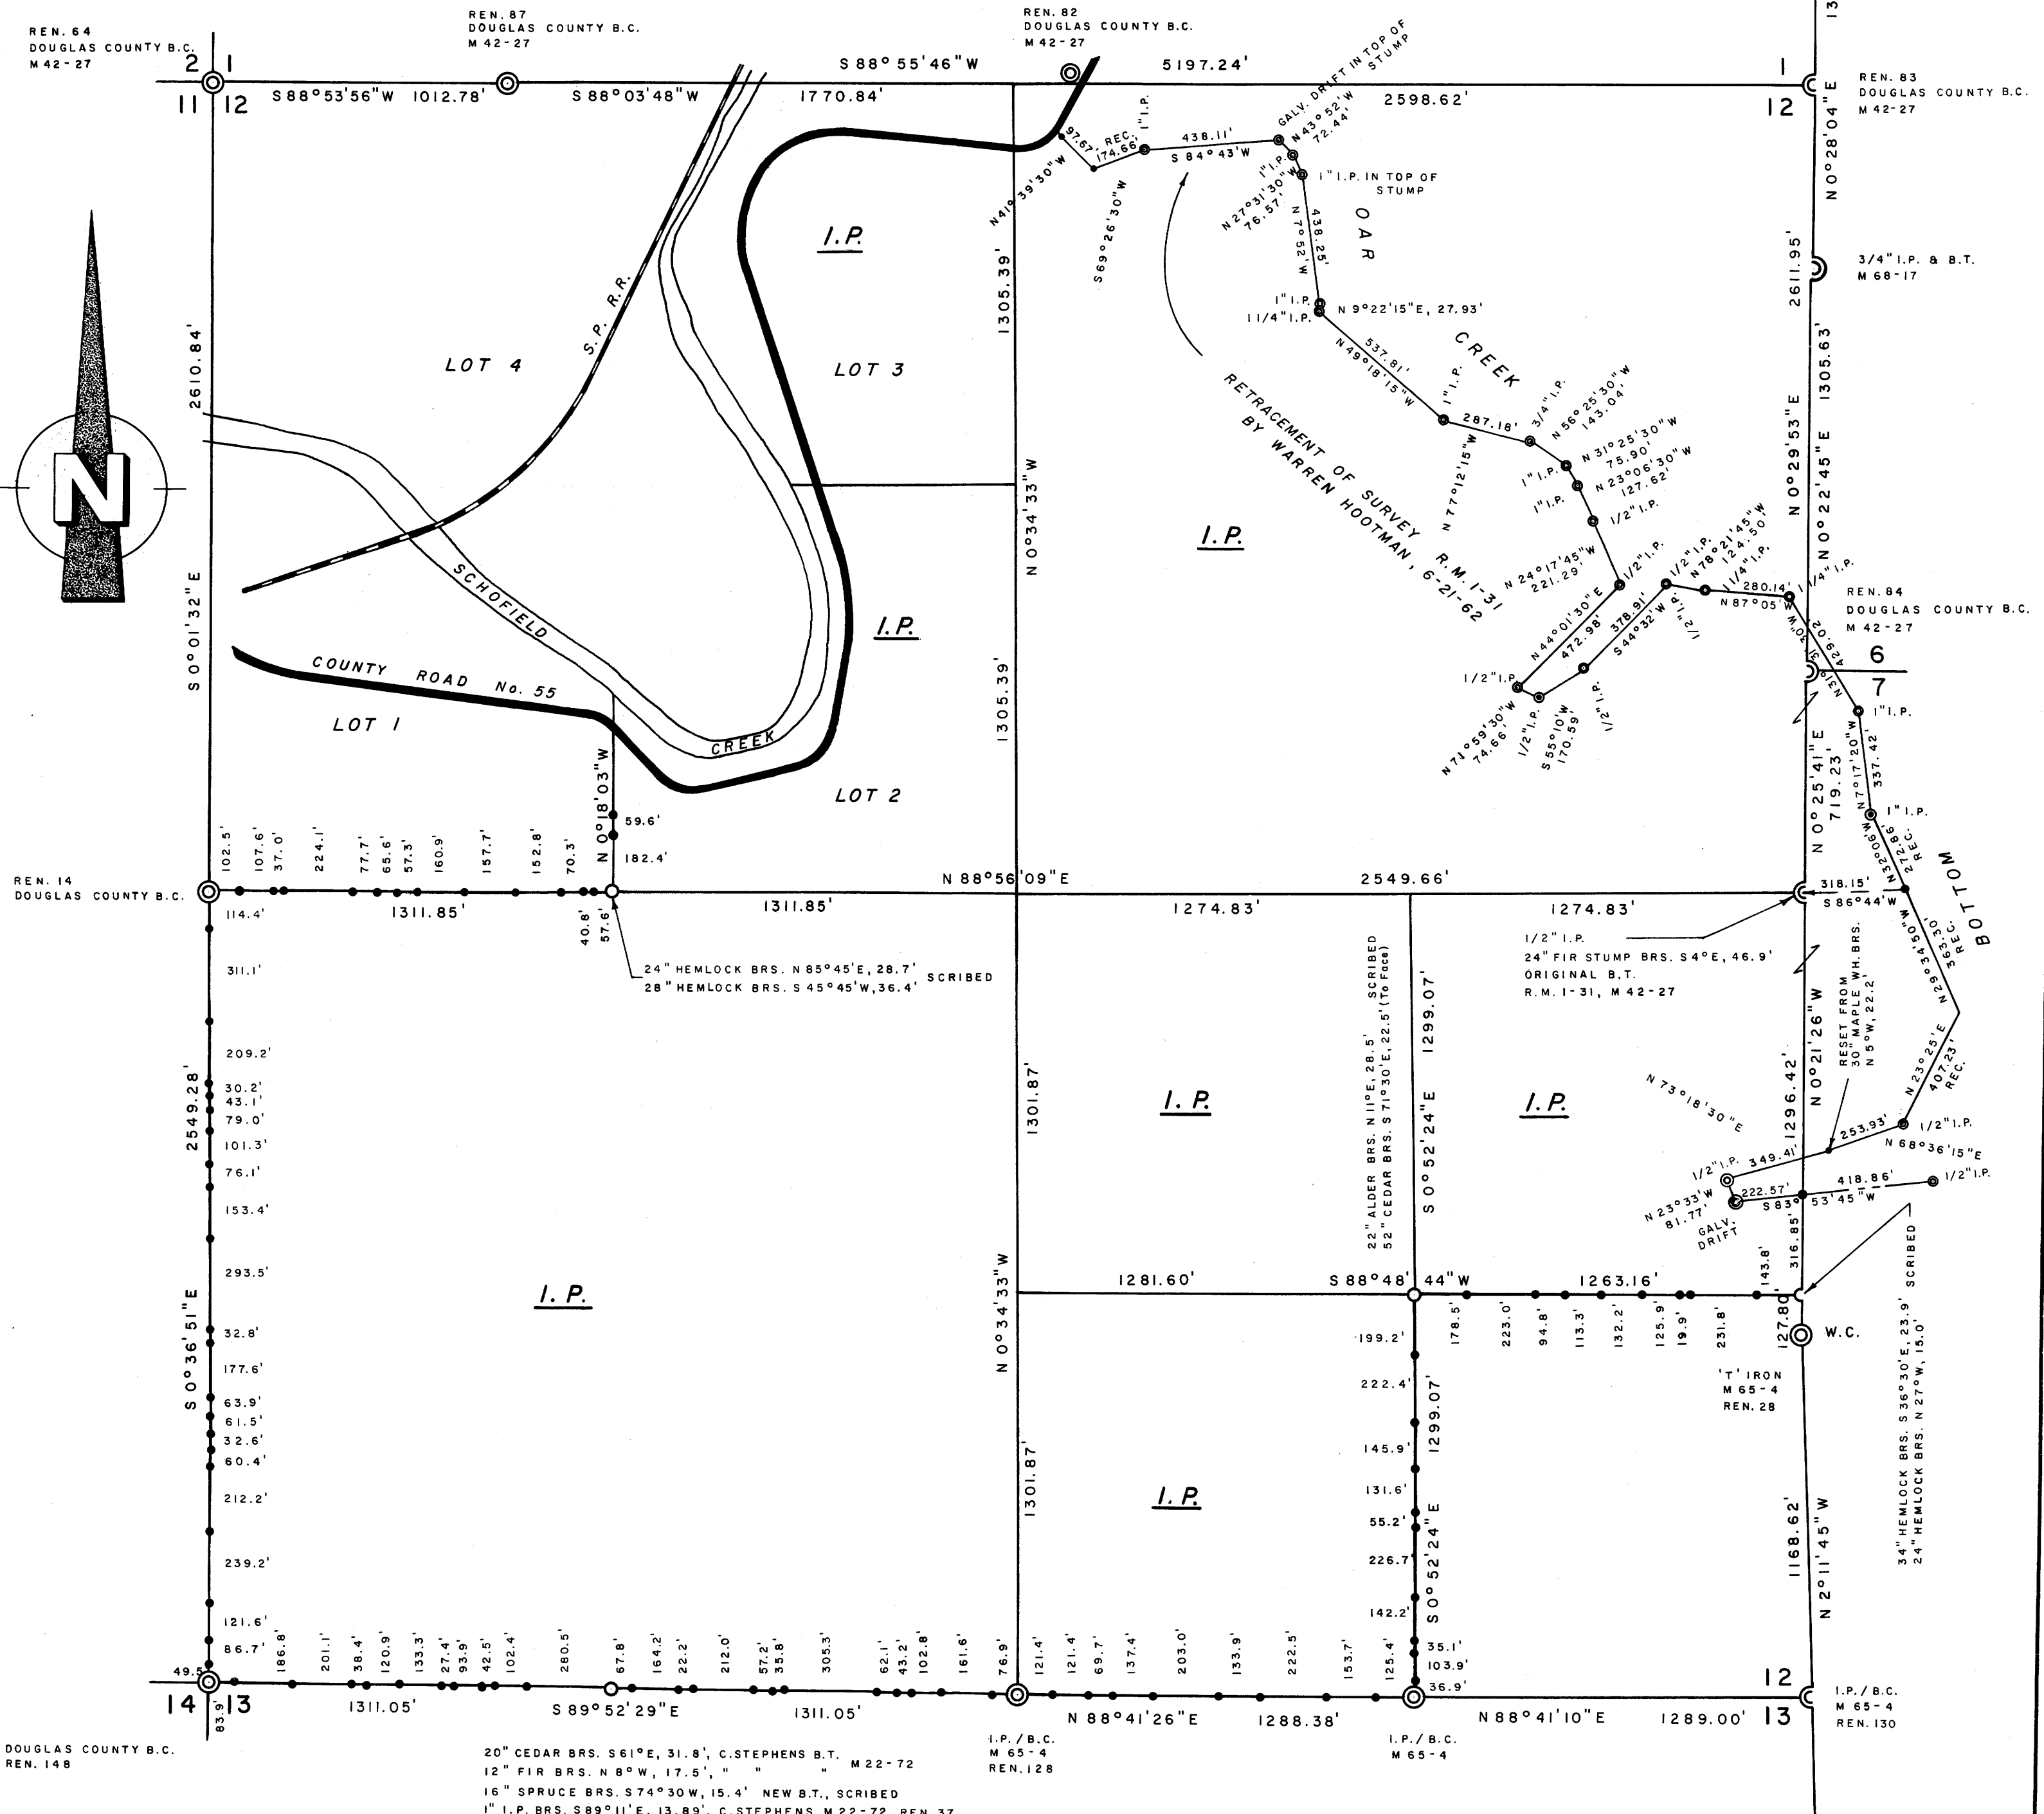

LEGEND

- CORNERS FOUND \odot
- SET 1 1/4 x 36" I.P.'S / STAMPED BRASS CAPS \circ
- PROPERTY LINES ESTABLISHED, 1/2 x 60" I.R.'S WITH ATTACHED ALUMINUM SIGNS

NOTES

1. BASIS FOR BRG. M 83-57 (TRUE FROM SOLAR OBSERVATION) VAR. 18°50'
2. DISTANCES ARE TAKEN TO A 50d NAIL IN THE CENTER OF EACH BEARING TREE, UNLESS NOTED.
3. THIS SURVEY WAS MADE IN ACCORDANCE WITH THE B.L.M. MANUAL OF SURVEY INSTRUCTIONS.

REGISTERED
PROFESSIONAL
LAND SURVEYOR

Richard J. Hintz
RICHARD J. HINTZ
497

RICHARD J. HINTZ
1890 N. 14th ST.
COOS BAY, OREGON