

COUNTY SURVEYORS FILE DATA  
DO NOT REMOVE FROM OFFICE

# Resurvey of Line Between Sections 6 & 7, T 30 S, R 9 W And East 1/4 of Line Between Sections 1 & 12, T 30 S, R 10 W, W. M., Oregon

For Roseburg Lumber Company

Scale: 1" = 500'

January 15, 1981

FILED *BS*  
RECEIVED *BS*  
FEB 25 1981  
COUNTY SURVEYOR  
DOUGLAS COUNTY, ORE.  
*BS*

MAP FILE M 86-63

**Legend**

- Found Iron Rod
- Found Brass Cap
- Set Aluminum Cap
- T — Line Referenced to Alum. Tags
- ( ) Record Data

Bearings based on Solar Observation


I ran a closed traverse using a Jena 1 second theodolite and a Mac I-E EDM. I achieved a precision of 1:8750 and adjusted the traverse by the Crandall method. I set the 1/6 corners between Sections 6 & 7 by proportionate distance using the distances recorded in the original 1893 survey.

Howard W. Johnstone P.O. Box 1088 Roseburg, Oregon

REGISTERED  
PROFESSIONAL  
LAND SURVEYOR

*Howard W. Johnstone*

OREGON  
MAY 13, 1960  
HOWARD W. JOHNSTONE  
498

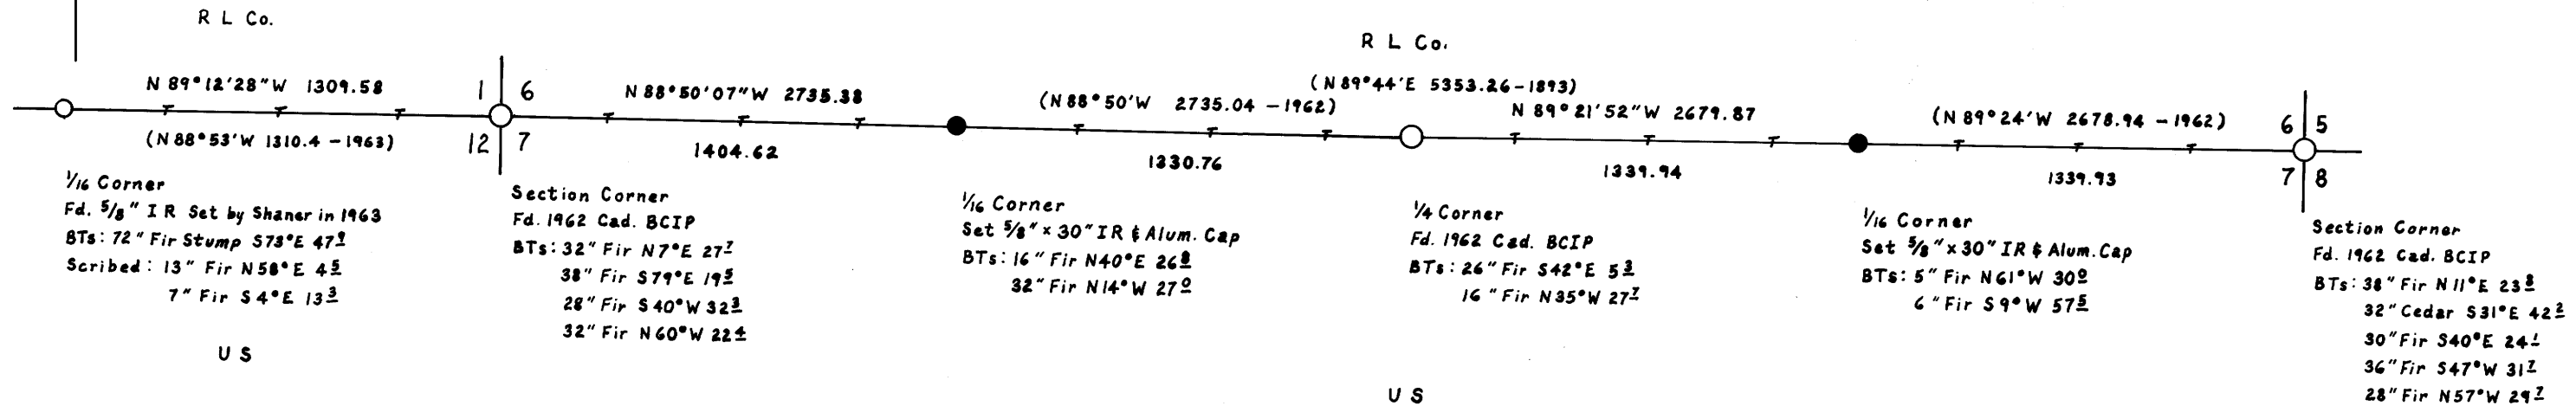

MAP FILE M 86-63