
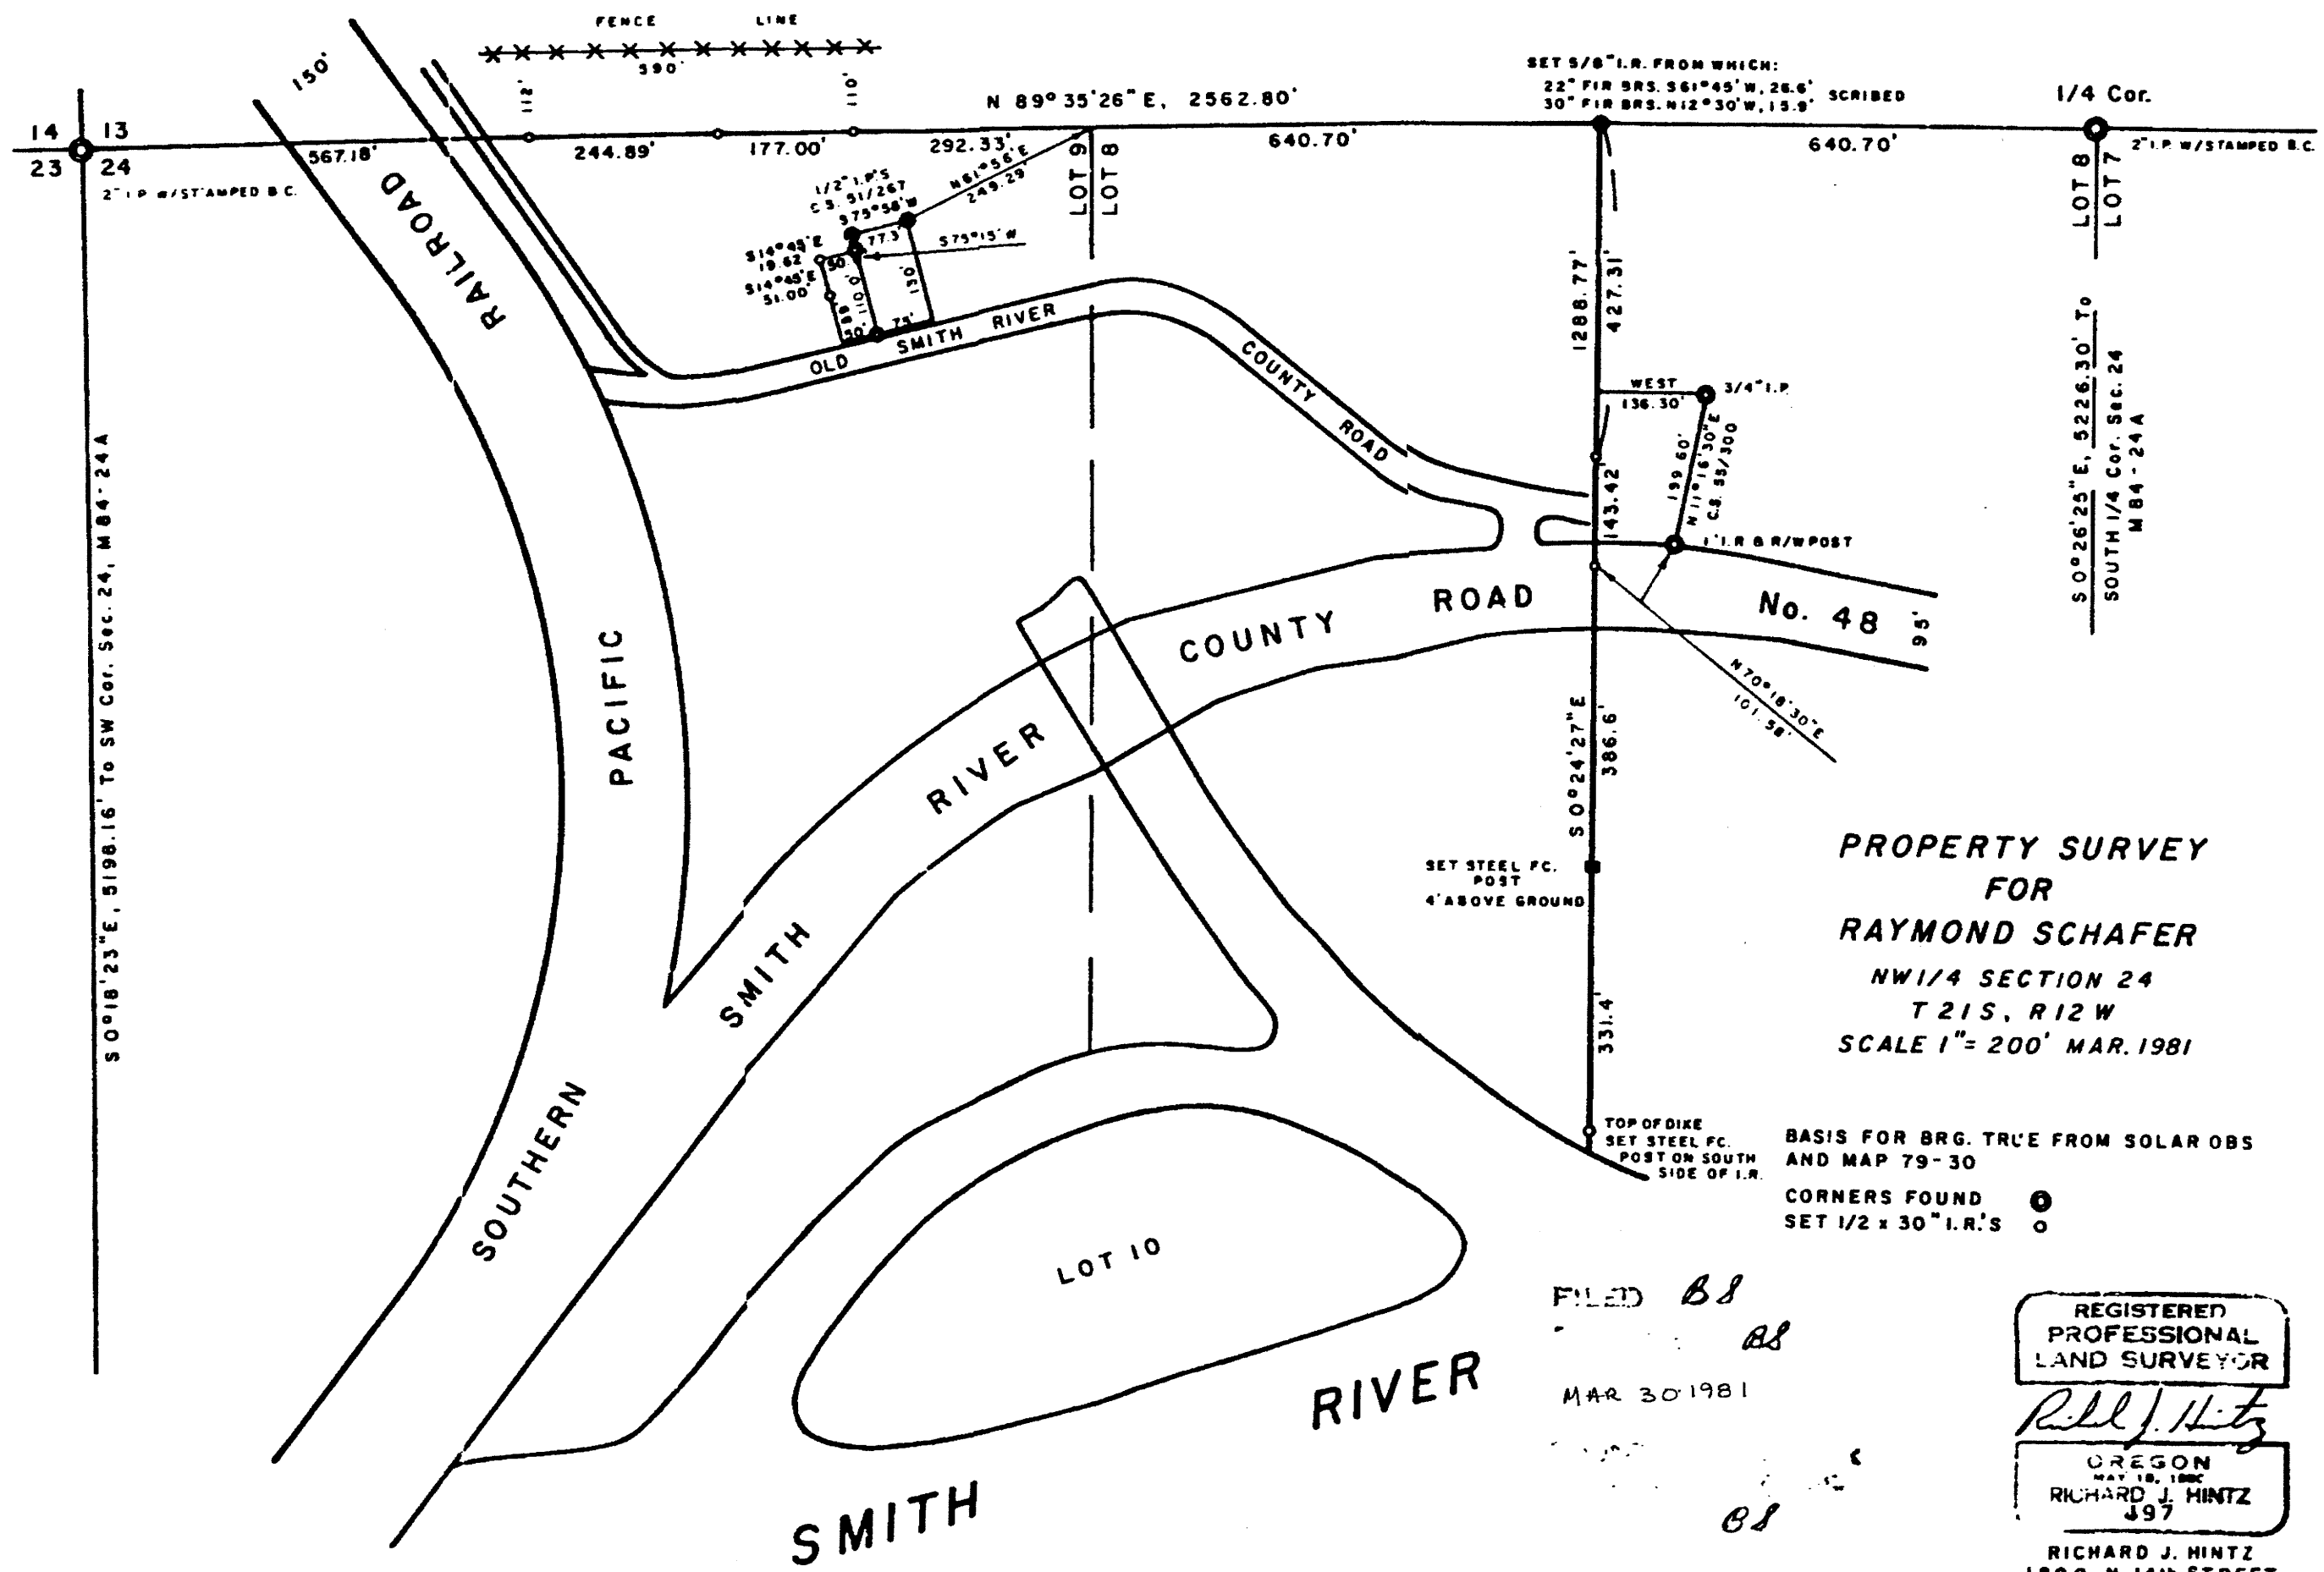


MAP FILE M87-11

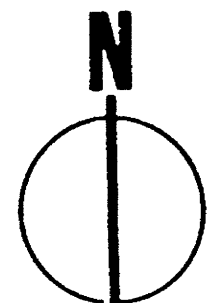

This copy made from micro film (7-19-2001)
ALSO filed in CS 58/267-5 (microfilm
copy made 12/29/82 BS)

FILE M87-11
ALSO filed AS CS 58/267-5
(microfilm copy)

COUNTY SURVEYORS FILE DATA
DO NOT REMOVE FROM OFFICE