

COUNTY SURVEYORS FILE DATA  
DO NOT REMOVE FROM OFFICE

# PROPERTY SURVEY

OF LOTS 1 AND 2 BLOCK 4 PLAT C  
ROSEBURG HOME ORCHARD TRACTS  
IN THE NE 1/4, SECTION 32, T25S, R5W, W.M.  
DOUGLAS COUNTY, OREGON  
MARCH, 1981 SCALE: 1"=100'


FILED *BS*  
RECEIVED *BS*  
APR 3 1981

COUNTY SURVEYOR  
DOUGLAS COUNTY, ORE.  
*BS*

FOR: DALE BEAHM

BY: ROBERT L. DOLAN  
RT. 1 BOX 1820  
SUTHERLIN, OR 97479

BOUNDARY LINE  
AGREEMENT IS  
NECESSARY FOR  
THESE LINES

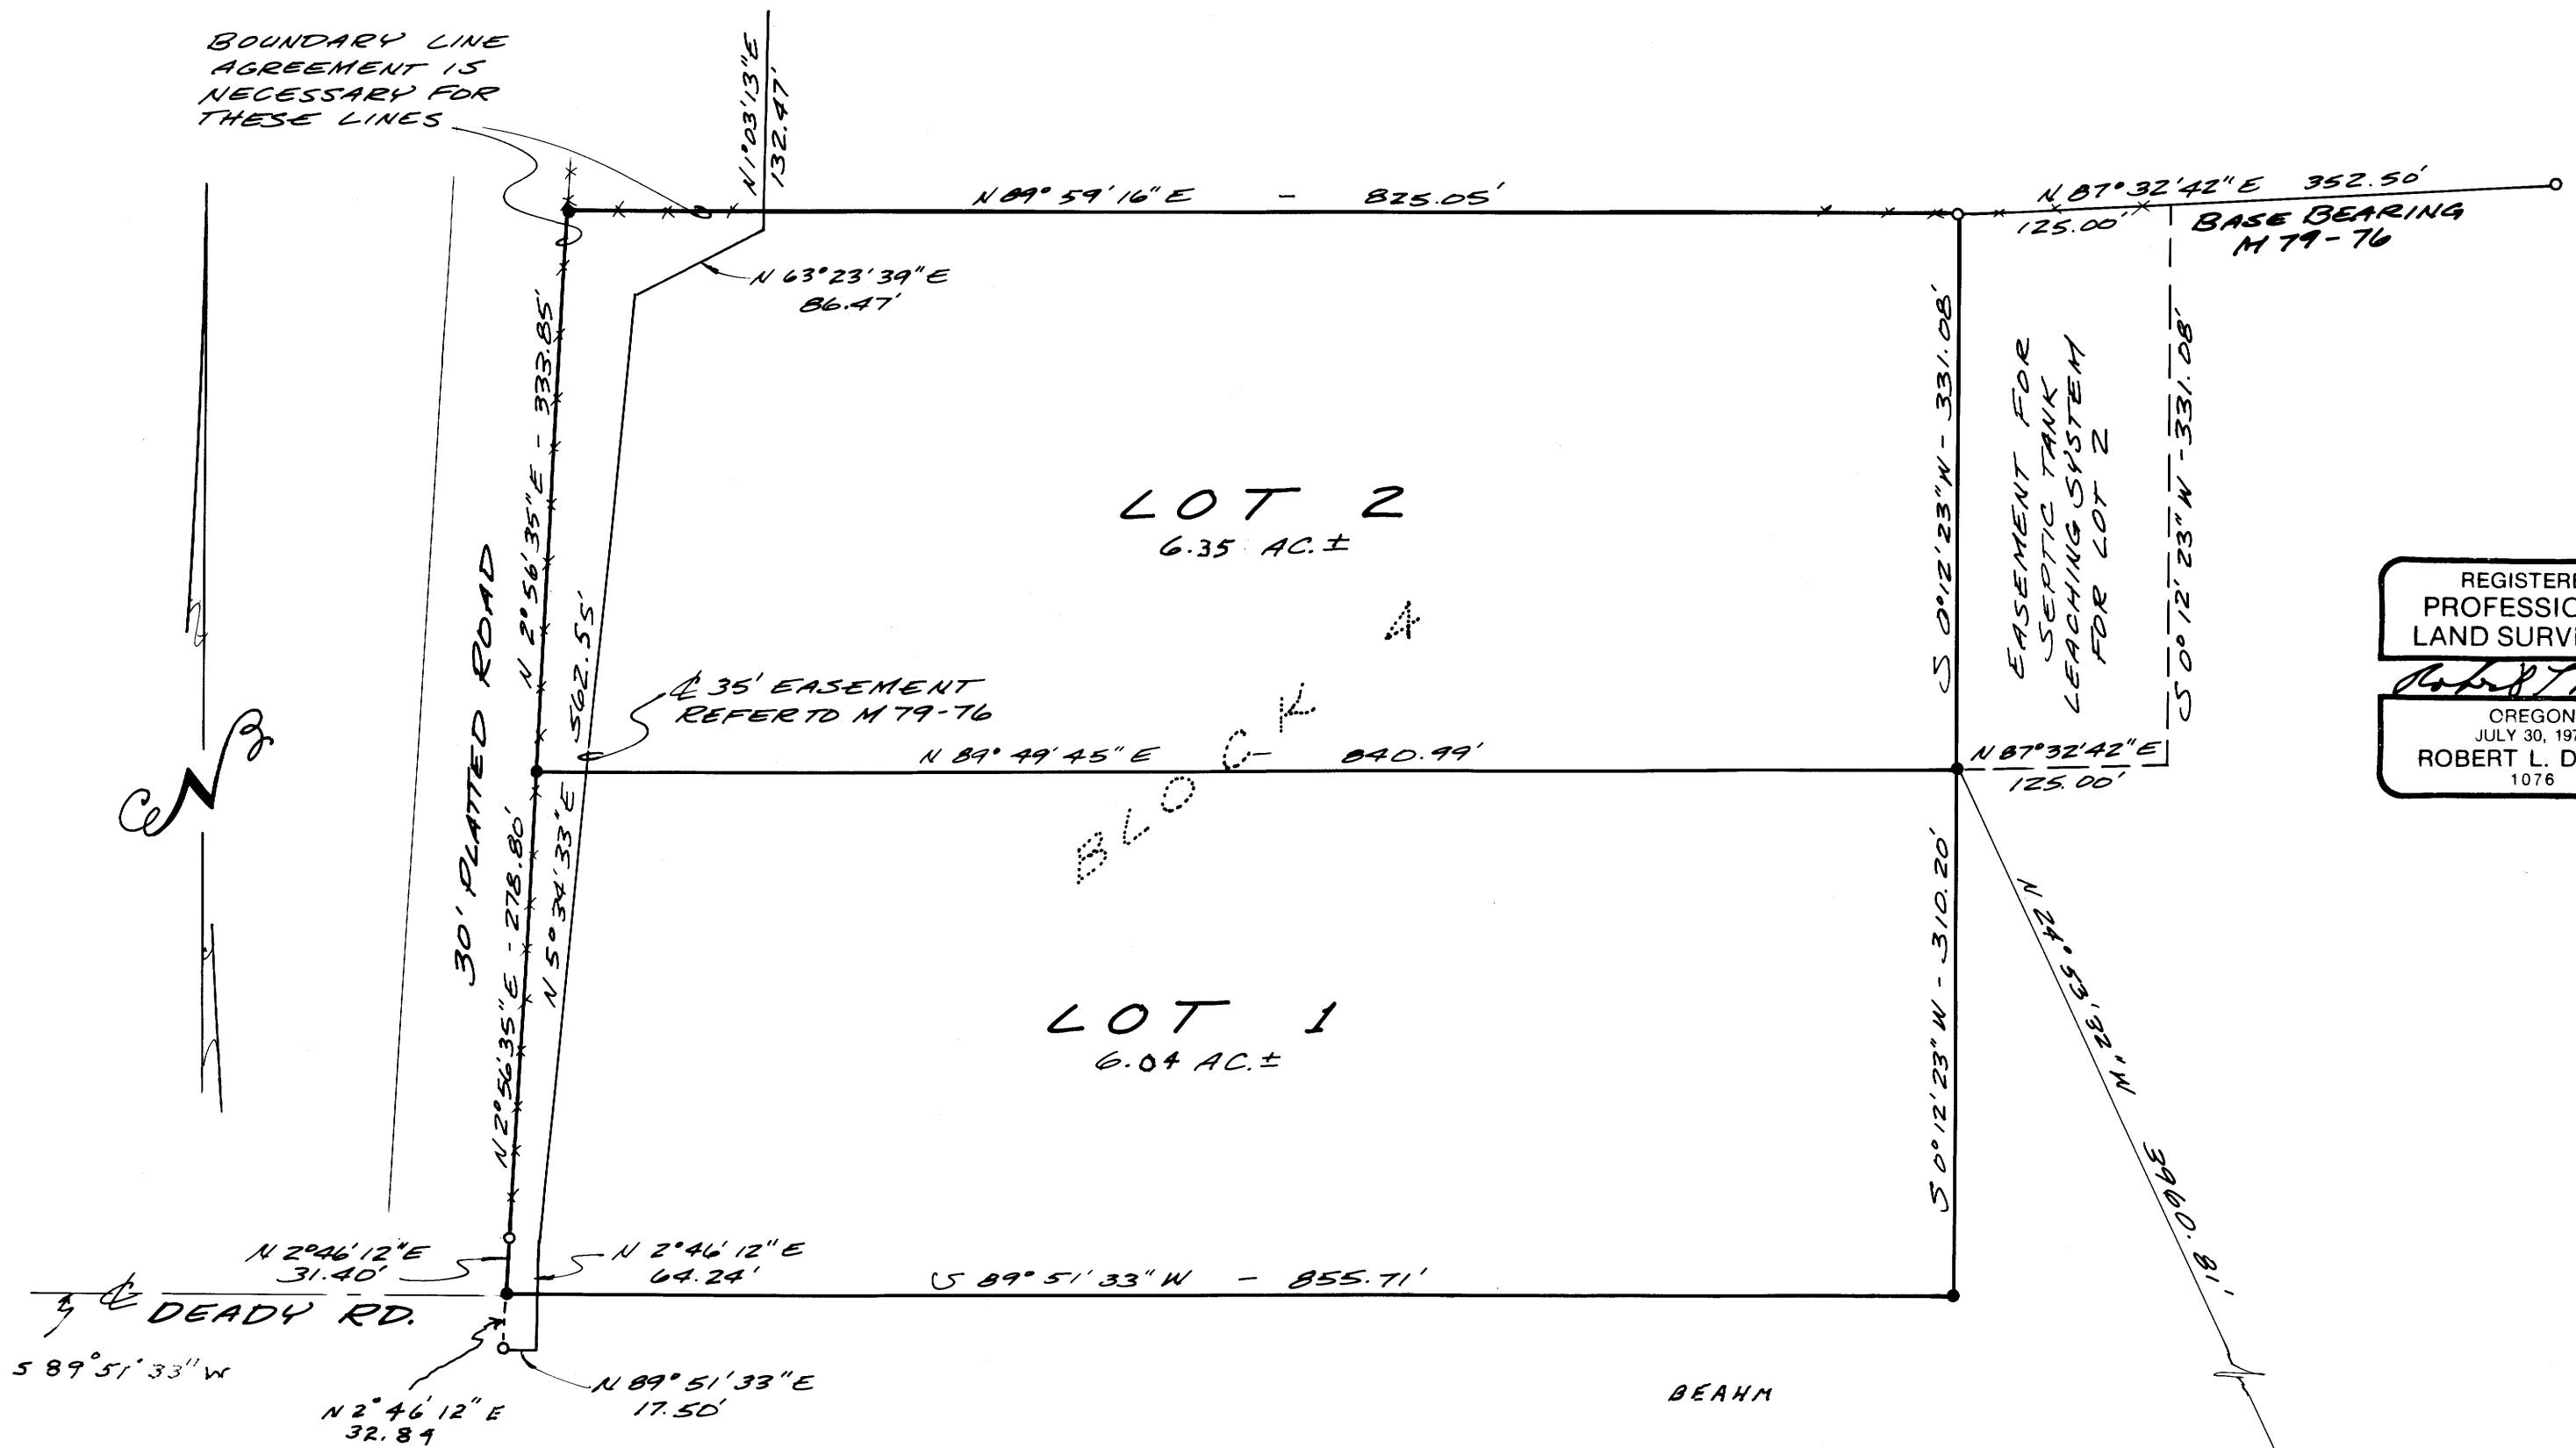

MAP FILE M87-21

MAP FILE M87-21