

COUNTY SURVEYORS FILE DATA
DO NOT REMOVE FROM OFFICE

Section 9, Township 31 South, Range 8 West, Willamette Meridian, Oregon
United States Department of the Interior
Bureau of Land Management

Surveyed by Don E. Garrett RPLS 544 State of Oregon
August 1972 Contract No. 53500-GT2-334(N) Scale 1" = 660'

FILED *BS*
RECEIVED *BS*

FEB 10 1982

COUNTY SURVEYOR
REGISTERED
PROFESSIONAL
LAND SURVEYOR

Don E. Garrett

OREGON
JULY 14, 1961
DON E. GARRETT
544

MAP FILE 22-91-13

COUNTY SURVEYORS FILE DATA
DO NOT REMOVE FROM OFFICE

Fd. Brass Cap Marked US Cadastral Survey
BLM, S4, S5, S8, S9, T31S, R8W, 1961
23" Fir Bears N 4 1/2° W 29 Lts. (Scar)
46" Pine N 25° E 60 " (Scribing)
15" Fir (Now Stump) Bears S 53 3/4° E
51 Lts. (Scribing)
SW Bearing Tree is Down

Fd. Brass Cap Marked US Cadastral Survey
BLM, 1/4 S4, S9, T31S, R8W, 1961
40" Fir Bears N 49 1/2° E 47 Lts. (Scribing)
7" Hemlock " S 38 1/2° W 19 " (Scribing)

Fd. Brass Cap Marked US Cadastral Survey
BLM, S3, S4, S9, S10, T31S, R8W,
28" Fir Bears S 75° E 8 Lts. (Bark Scribe)
16" " " S 68° W 28 " (Scar)
16" " " N 66° W 15 " (Scar)
7" Hemlock " N 27 1/2° W 65 Lts. (Scribing)
7" Fir " N 65° E 41 " (Scar)
19" " " S 56 1/2° W 44 " (Scribing)


Fd. Brass Cap Marked US Cadastral Survey
BLM, 1/4 S8, S9, T31S, R8W, 1961
12" Fir Bears N 86 3/4° W 47 Lts. (Scar)
30" " " N 45° E 22 " (Scar)
40" " " S 10° E 5 " (Bark Scribe)
22" " " S 40° W 4 " (Scar)

Fd. Brass Cap Marked US Cadastral Survey
BLM, 1/4 S9, S10, T31S, R8W, 1961
37" Fir Bears N 61 1/2° W 40 Lts. (Scribing)
45" " " S 56° E 72 " (Scar)
15" " " N 72° E 33 " (Bark Scribe)

Fd. Brass Cap Marked US Cadastral Survey
BLM, S8, S9, S16, S17, T31S, R8W
31" Fir Bears N 8 3/4° E 50 Lts. (Scar)
16" " " S 39° E 35 " (Scar)
9" " " S 4° W 76 " (Scribing)
6" " " N 15 1/2° W 55 " (Scar)

Fd. Brass Cap Marked US Cadastral Survey
BLM, S9, S10, S15, S16, T31S, R8W, 1961
32" Fir Bears N 7° W 25 Lts. (No Visible Scar)
25" " " N 13° E 55 " (Scar)
13" " " S 88° E 79 " (Scar)
23" " " S 15° W 35 " (Scar)

Fd. Brass Cap Marked US Cadastral Survey
BLM, 1/4 S9, S16, T31S, R8W, 1961
6" Cedar Bears S 11 1/2° E 22 Lts. (Scribing) (Now Snag)
20" Fir " N 62° W 18 " (Scar)

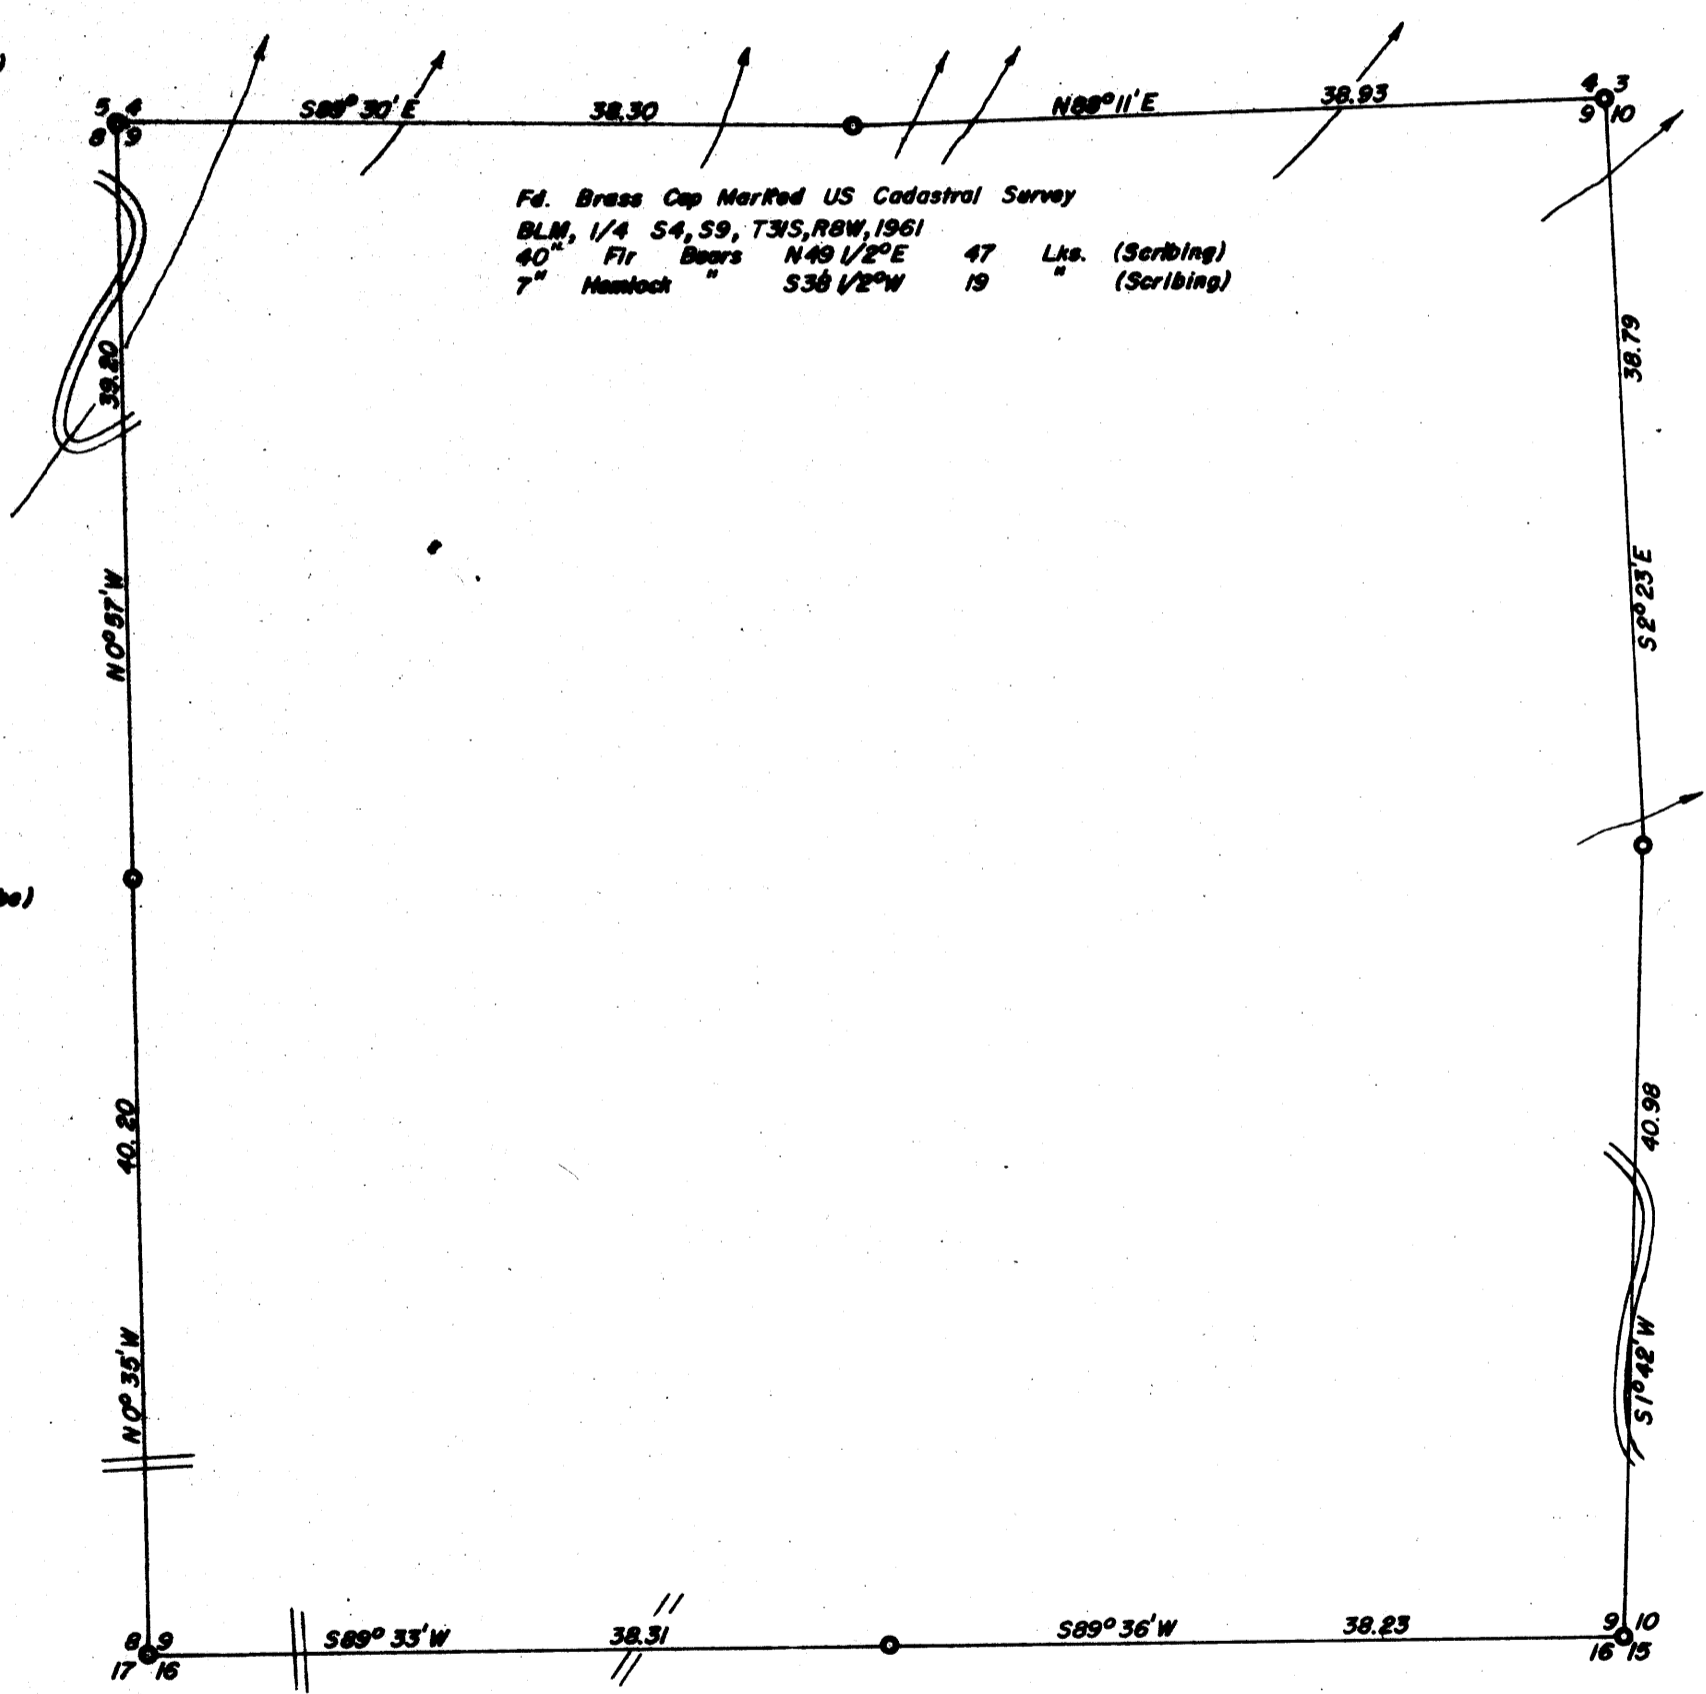

MAP FILE 22-91-13

COUNTY SURVEYORS FILE DATA
DO NOT REMOVE FROM OFFICE