

COUNTY SURVEYORS FILE DATA  
DO NOT REMOVE FROM OFFICE

FILED AS  
RECORDED  
COUNTY SURVEYORS  
DEPARTMENT

SURVEY FOR DEED DESCRIPTION  
IN PARCEL 1, LOT 12, BLOCK 2, PLAT C,  
SUTHERLIN LAND AND WATER CO. IN THE  
SW 1/4, SEC. 20, T25S, R5W, W.M., SUTHERLIN,  
OREGON


FOR: Gary Hall  
BY: Robert L. Dolan  
Rt. 1, Box 1820  
Sutherlin, Or.  
DATE: April, 1982  
SCALE: 1" = 100'

LEGEND: ° Fd. 5/8" Iron Rod  
• Set 5/8" x 30" Iron Rod w/cap (L.S. 1076)  
( ) Denotes Record Bearing & Distances

NARRATIVE

Survey to monument division of Parcel 1 (Refer to C.S. Map No. M 74-80 for Parcel 1).

Instruments: Theodolite & Distance meter

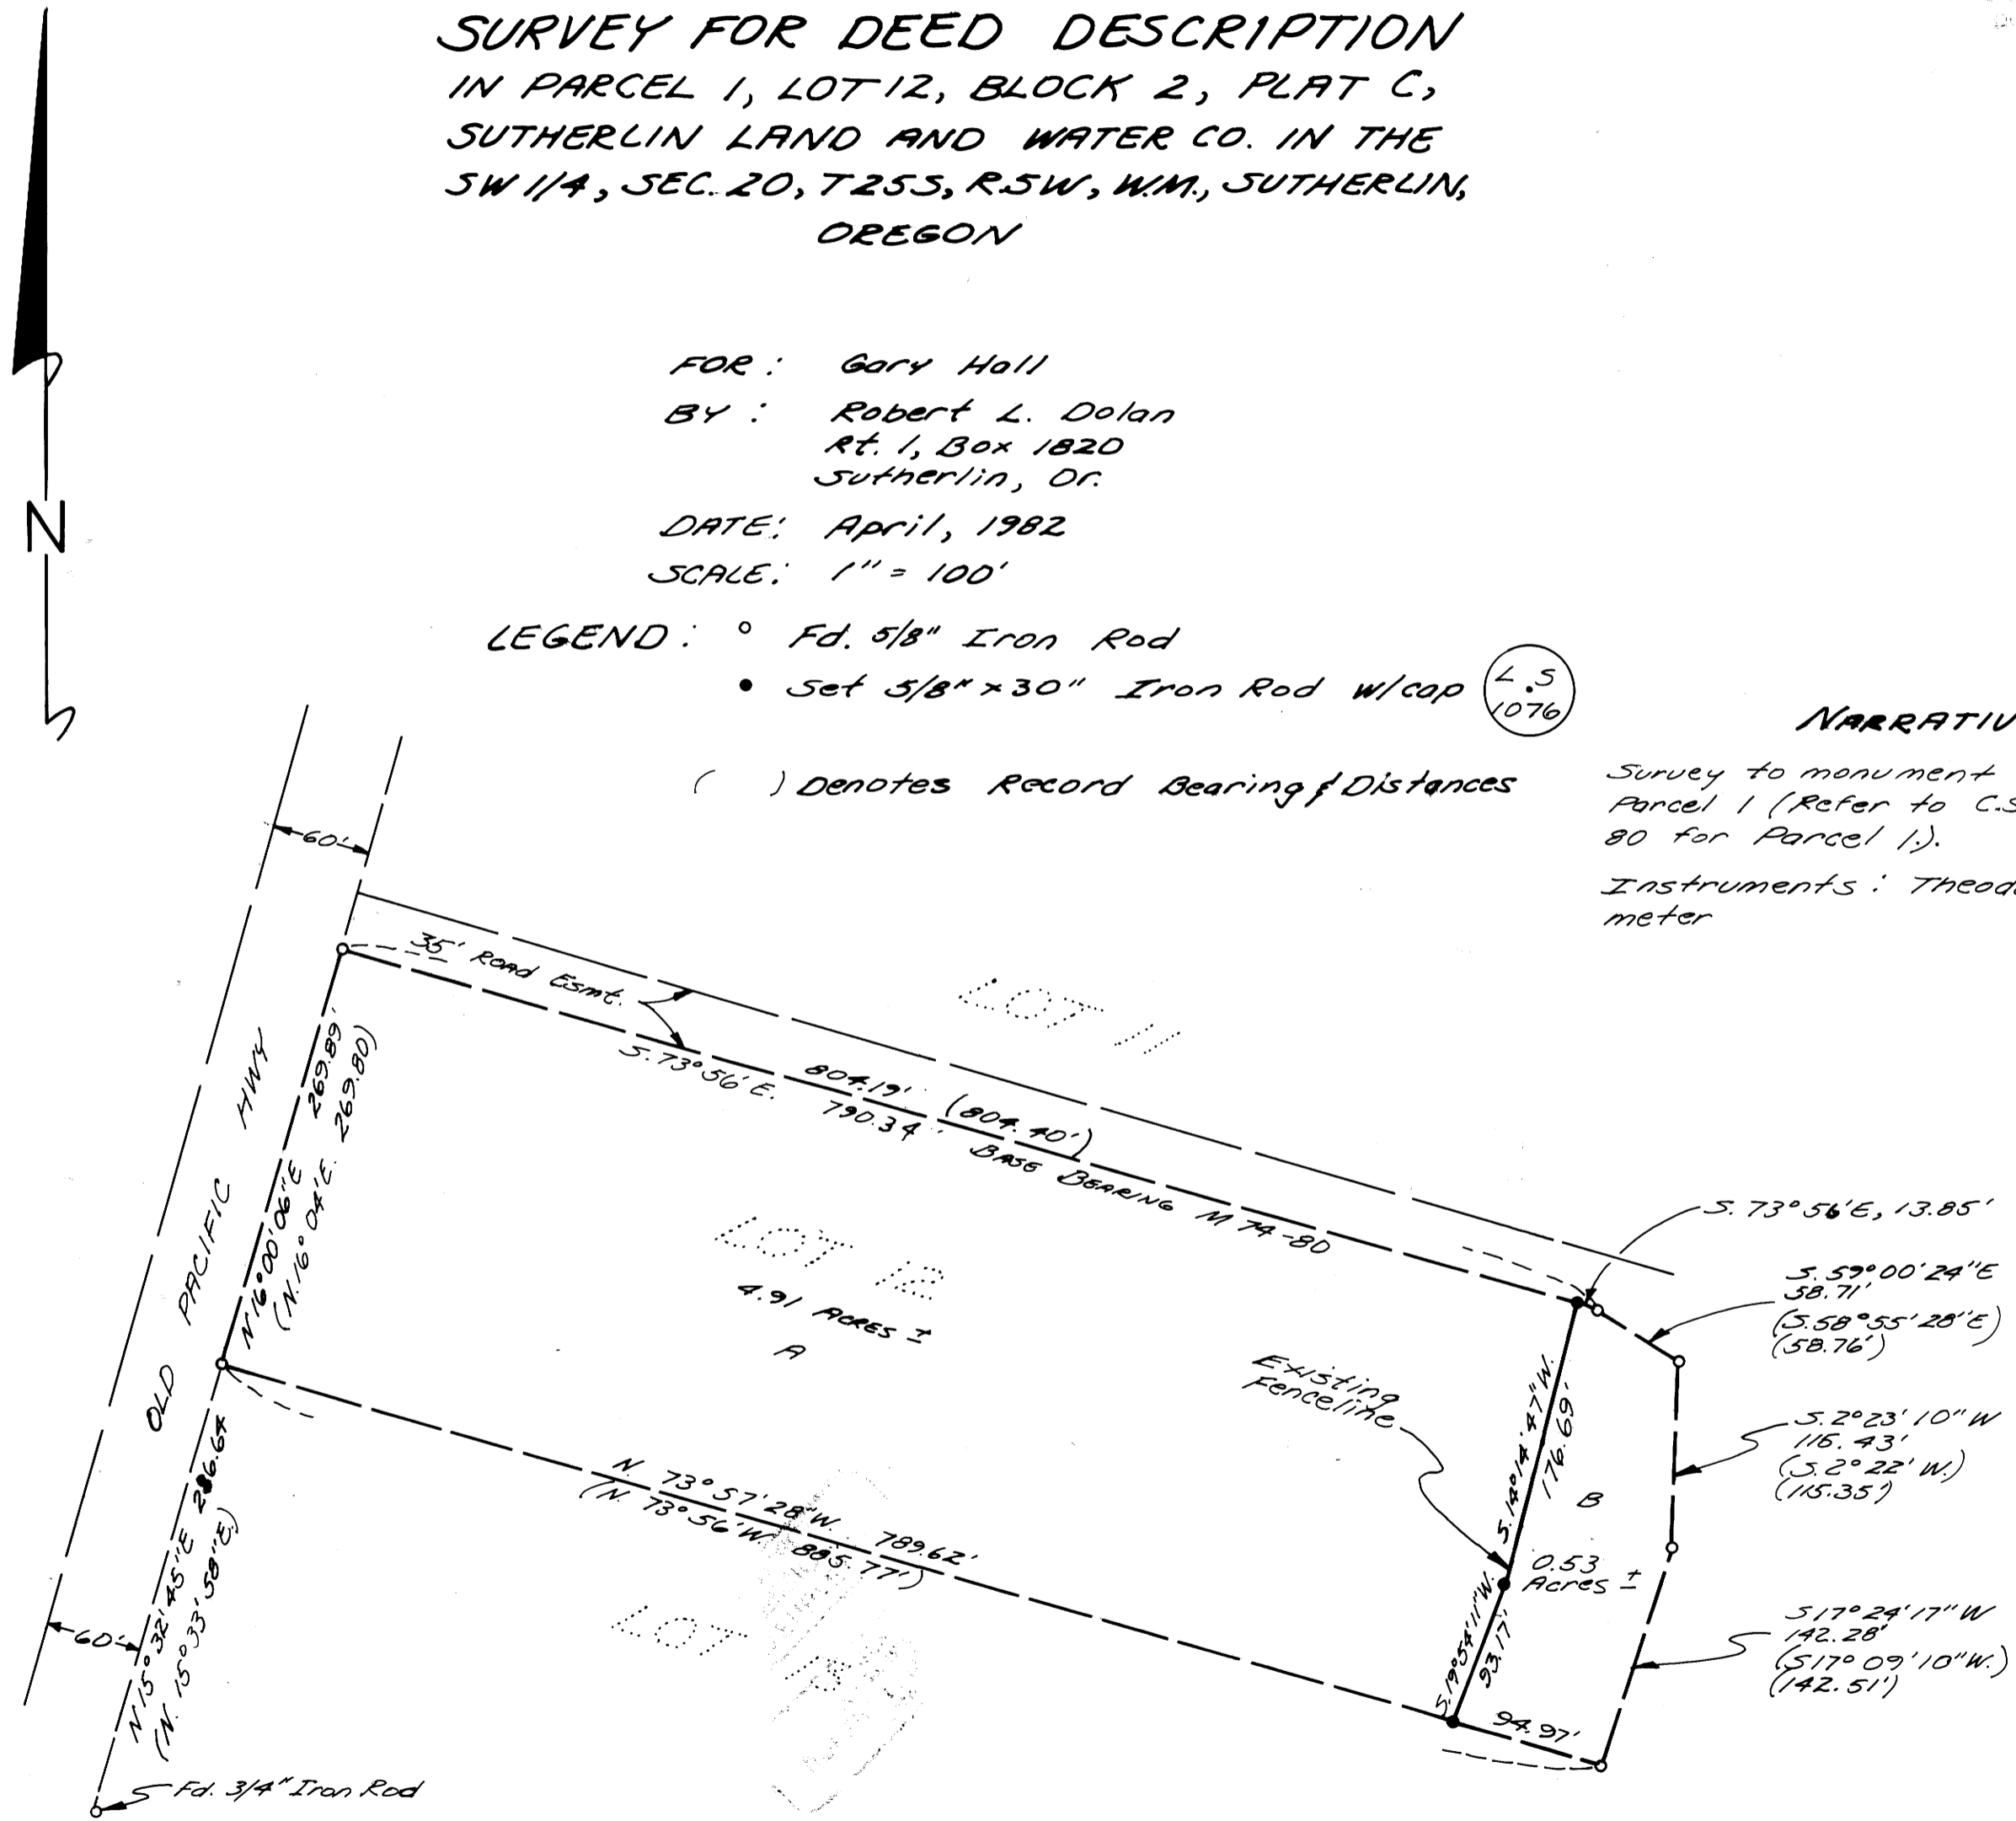

REGISTERED  
PROFESSIONAL  
LAND SURVEYOR  
ROBERT L. DOLAN  
OREGON  
JULY 30, 1976  
1976

M 91 - 59

M 91 - 59