


**COUNTY SURVEYORS FILE DATA  
DO NOT REMOVE FROM OFFICE**

FILED *68*  
RECEIVED *if*  
MAY 5 1982

S.W. SECTION CORNER  
FD. 1" x 1" x 36" "T" IRON SET  
IN SURVEY M 38-69

SOUTH 1/16 CORNER  
SET 5/8" x 36" IRON PIN WITH YELLOW  
PLASTIC CAP MARKED "ROBERTS L.S. 1039"

COUNTY SURVEYOR  
DOUGLAS COUNTY, ORE.  
*68*

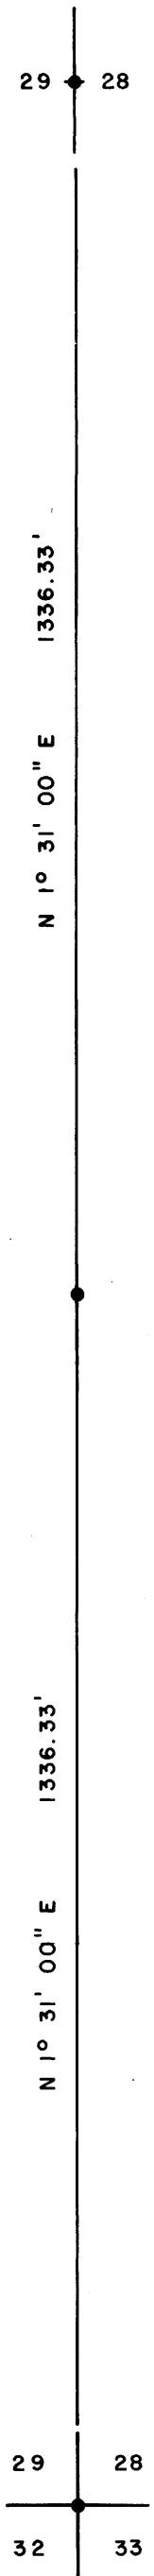

MAP FILE *M 91-76*

WEST 1/4 CORNER  
FD. 1" x 1" x 36" "T" IRON SET  
IN SURVEY M 38-69  
28" OAK, N 46 1/2° E, 97.4' (SCAR VIS.)

*See Roberts*



**NARRATIVE**  
THE PURPOSE OF THIS SURVEY IS TO SET THE S 1/16 CORNER BETWEEN SECTIONS 28 AND 29 AND TO MARK THE PROPERTY LINE BETWEEN THE S.W. SECTION CORNER AND THE WEST 1/4 CORNER OF SECTION 28. A CLOSED MEANDER TRANSIT AND E.D.M. TRAVERSE WAS RUN BETWEEN THE S.W. SECTION CORNER AND THE WEST 1/4 CORNER OF SECTION 28 AND USED FOR CONTROL. OFFSETS WERE COMPUTED FROM THIS MEANDER TRAVERSE TO THE TRUE PROPERTY LINE. THE S 1/16 CORNER BETWEEN SECTIONS 28 AND 29 WAS SET HALFWAY BETWEEN THE S.W. SECTION CORNER AND THE WEST 1/4 CORNER.

**LEGEND**

- CORNERS FOUND AND USED FOR CONTROL
- CORNERS SET, 5/8" IRON ROD
- ( ) DATA OF RECORD, M 38-69

BASIS OF BEARING, WEST LINE SECTION 28 FROM SURVEY M 38-69  
DISTANCE TO BEARING TREES ARE CENTER MEASURE  
SCALE 1" = 200'

**SURVEY IN**  
SECTION 28, T 22S, R 7W, W.M.  
DOUGLAS COUNTY, OREGON  
FOR  
JOHN BECKLEY  
BY  
ROBERTS SURVEYING INC.  
29 WEST 29TH STREET  
EUGENE, OREGON 97405  
APRIL 10, 1982

MAP FILE *M 91-76*