

PROPERTY LINE SURVEY IN THE SOUTH HALF OF SECTION 5 AND THE NORTH HALF OF SECTION 8, T. 25 S., R. 5 W., U.M., DOUGLAS COUNTY, OREGON

FILED *BS*

RECEIVED *BS*

JUL 20 1982

COUNTY SURVEYOR
DOUGLAS COUNTY, ORE.

BS

FOR JAMES E. STEARNS

BY ROBERT L. DOLAN

RT. 1 BOX 1820

SUTHERLIN, OR. 97479


DATE JULY, 1982

Legend: • SET 5/8" x 30' IRON ROD W/CAP (10)
○ FOUND PINS AS NOTED

SCALE: 1"=100' COUNTY SURVEYORS FILE DATA
DO NOT REMOVE FROM OFFICE

FOUND BRASS CAP
C.S.O. 1975 - 1/4 COR 92 T. 24 S., R. 5 W.
5 T. 25 S., R. 5 W.


S. 0° 02' 16" W.
3752.52'
(COMPUTED TIE)
COUNTY RD. NO. 23A
60'
SET 5/8" IRON ROD
30' FROM CENTER
OF COUNTY ROAD

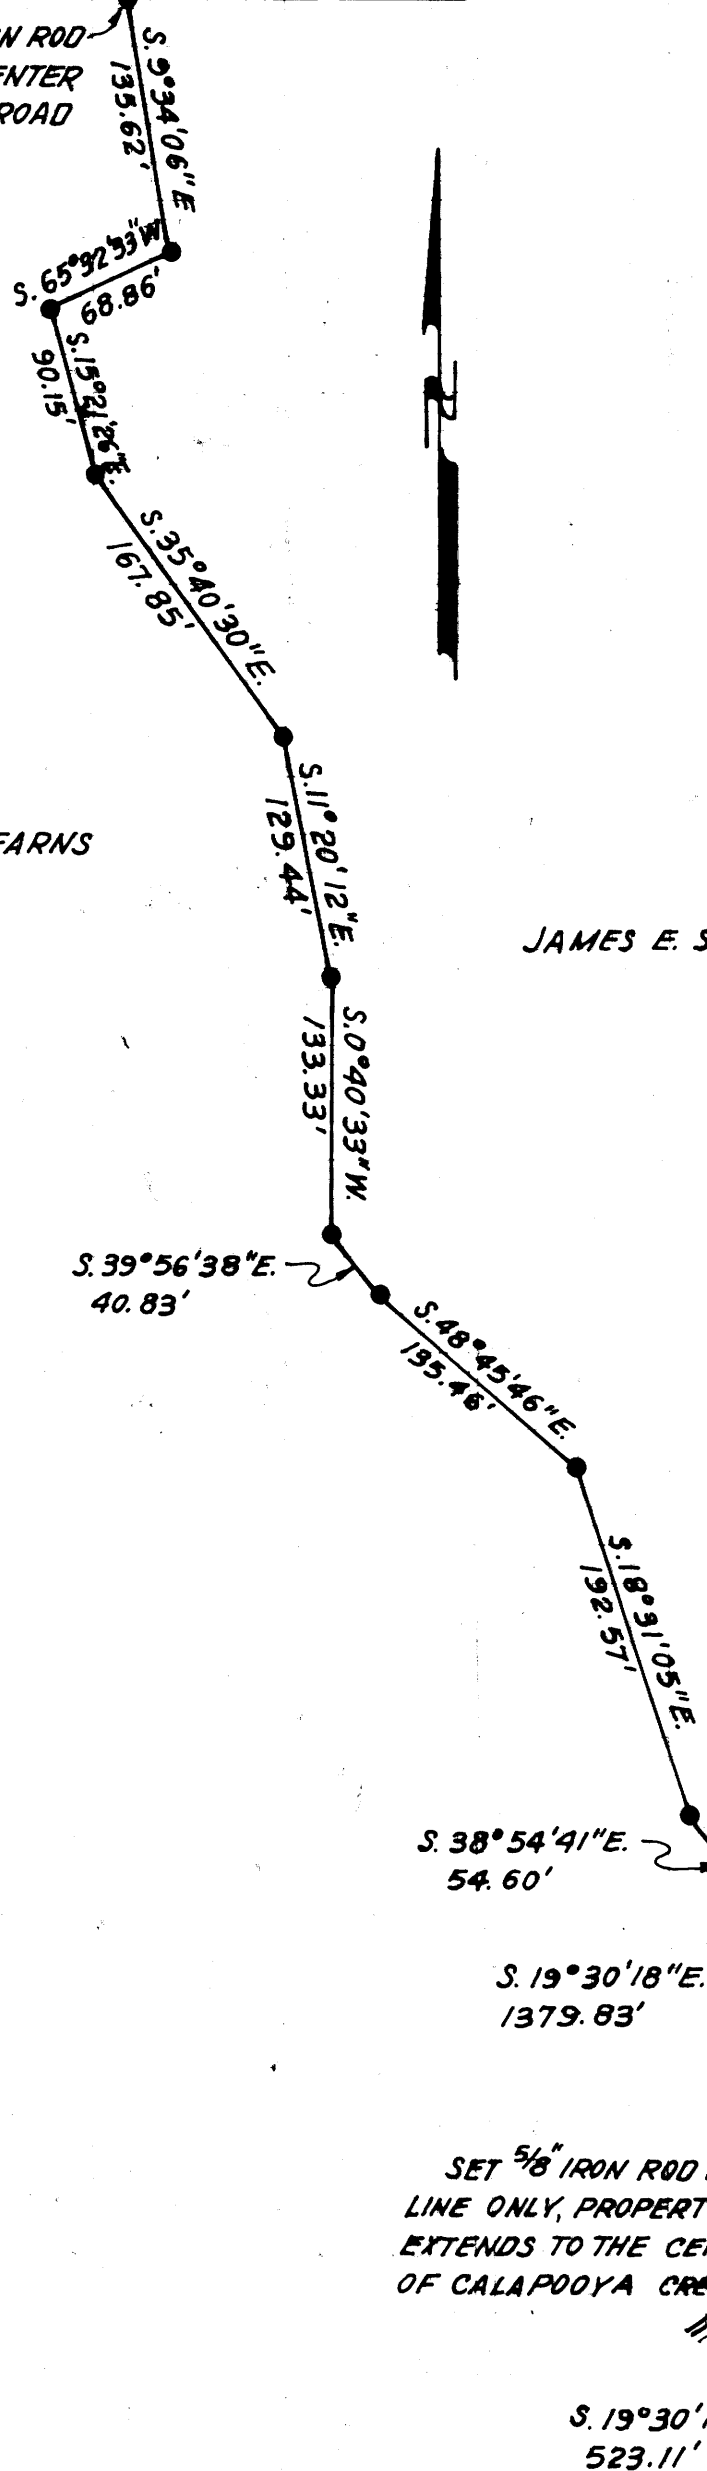

JAMES E. STEARNS

JAMES E. STEARNS

BASE BEARING SOUTH LINE M 56-21

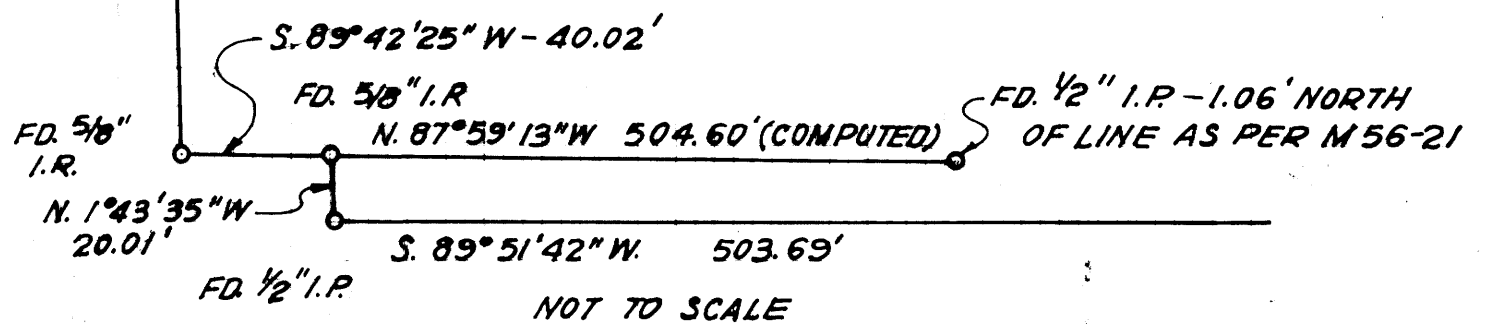

NARRATIVE:

SURVEY TO MONUMENT PROPERTY LINE FOR
DIVISION OF PROPERTY.

REFERENCES: DEED NO. 238/189/35, RM 1-4

EQUIPMENT: DISTANCE METER-THEODOLITE

SET 5/8" IRON ROD FOR
LINE ONLY, PROPERTY LINE
EXTENDS TO THE CENTER
OF CALAPOOYA CREEK

S. 19° 30' 18" E.
523.11'

FOUND 3/4" IRON ROD.
STEARNS AVENUE

REGISTERED
PROFESSIONAL
LAND SURVEYOR
Robert L. Dolan
OREGON
JULY 30, 1976
ROBERT L. DOLAN
1078