

# Resurvey And Subdivision of E 1/2 Section 14, T 25 S, R 8 W, W.M.

For Roseburg Lumber Company


September 2, 1983

FILED  
RECEIVED  
SEP 13 1983  
COUNTY SURVEYOR  
DOUGLAS COUNTY, ORE


Scale: 1" = 400'

### Legend

- Found Monument as Noted
- Set 5/8" x 3/16" IR & Alum. Cap Marked LS 498
- Section Subdivision or Property Line
- Line Referenced to Alum. Tags
- ( ) Record Data - 1964 Cadastral Resurvey

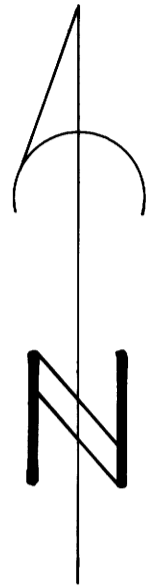

Bearing Based on Solar Observation

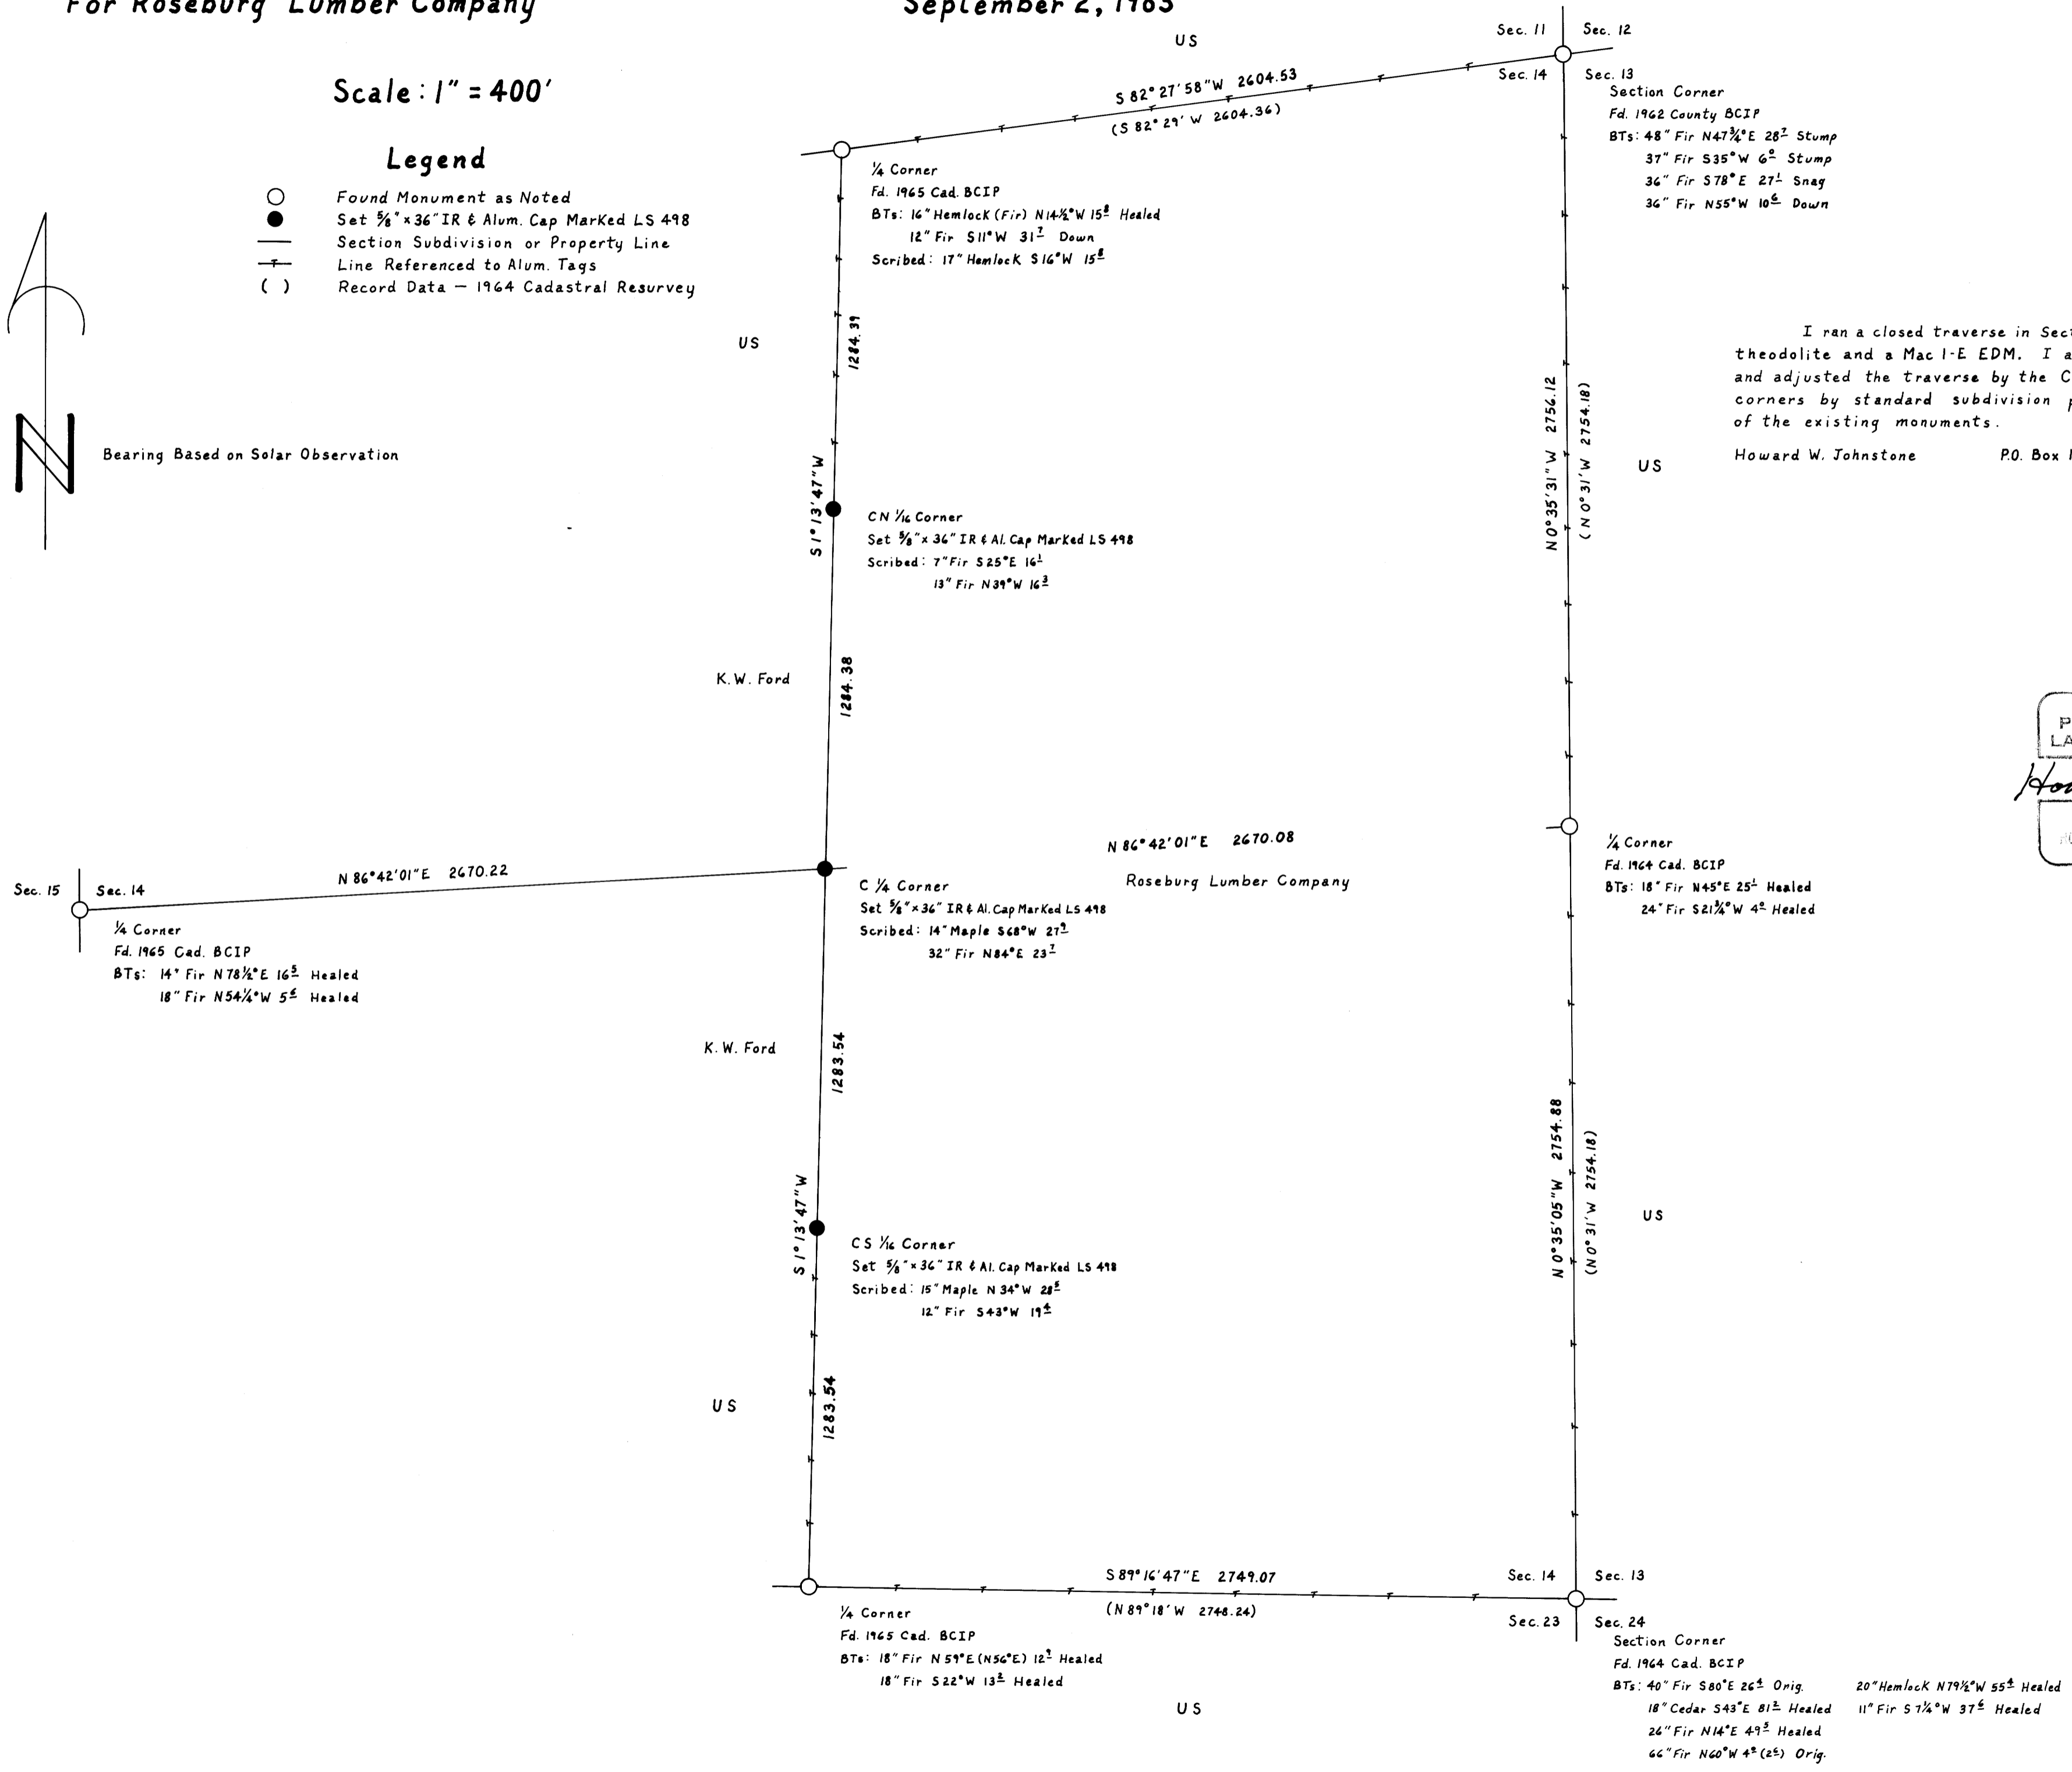

I ran a closed traverse in Section 14 using a Jena one second theodolite and a Mac I-E EDM. I achieved a precision of 1:22,100 and adjusted the traverse by the Crandall method. I set the corners by standard subdivision procedure based on the location of the existing monuments.

Howard W. Johnstone P.O. Box 1088 Roseburg, Oregon

REGISTERED  
PROFESSIONAL  
LAND SURVEYOR  
*Howard W. Johnstone*  
OREGON  
MAY 13, 1954  
HOWARD W. JOHNSTONE  
498

MAP FILE 1194-76