

COUNTY SURVEYORS FILE DATA
DO NOT REMOVE FROM OFFICE


RECORD OF SURVEY

COOKED WASSEN CADASTRAL SURVEY
FOR THE U.S.D.A. FOREST SERVICE
SILKSLAW NATIONAL FOREST



SECTIONS 3, 4 & 5, T21S, R10W, W.M.
DOUGLAS COUNTY, OREGON
NOVEMBER 1983

NOTES:


1. BASIS OF BEARINGS & BEARING CHECKS ARE FROM SOLAR OBSERVATIONS.
2. () INDICATES DATA OF RECORD
3. [] INDICATES DATA OF RECORD PER M91-24, SURVEY FILED BY RICHARD J. HINTZ, L.S. 497
4. / / / / INDICATES LINES POSTED THIS SURVEY

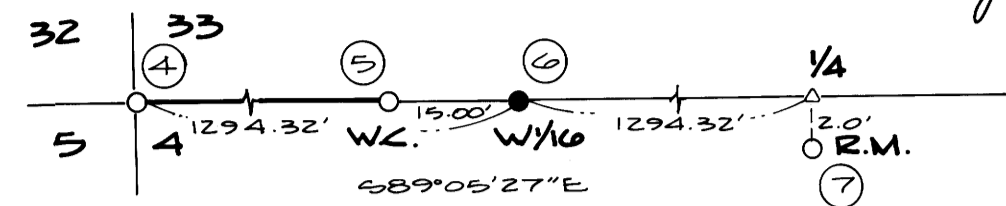

DETAIL A

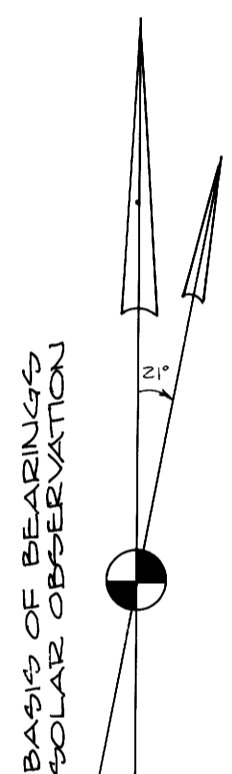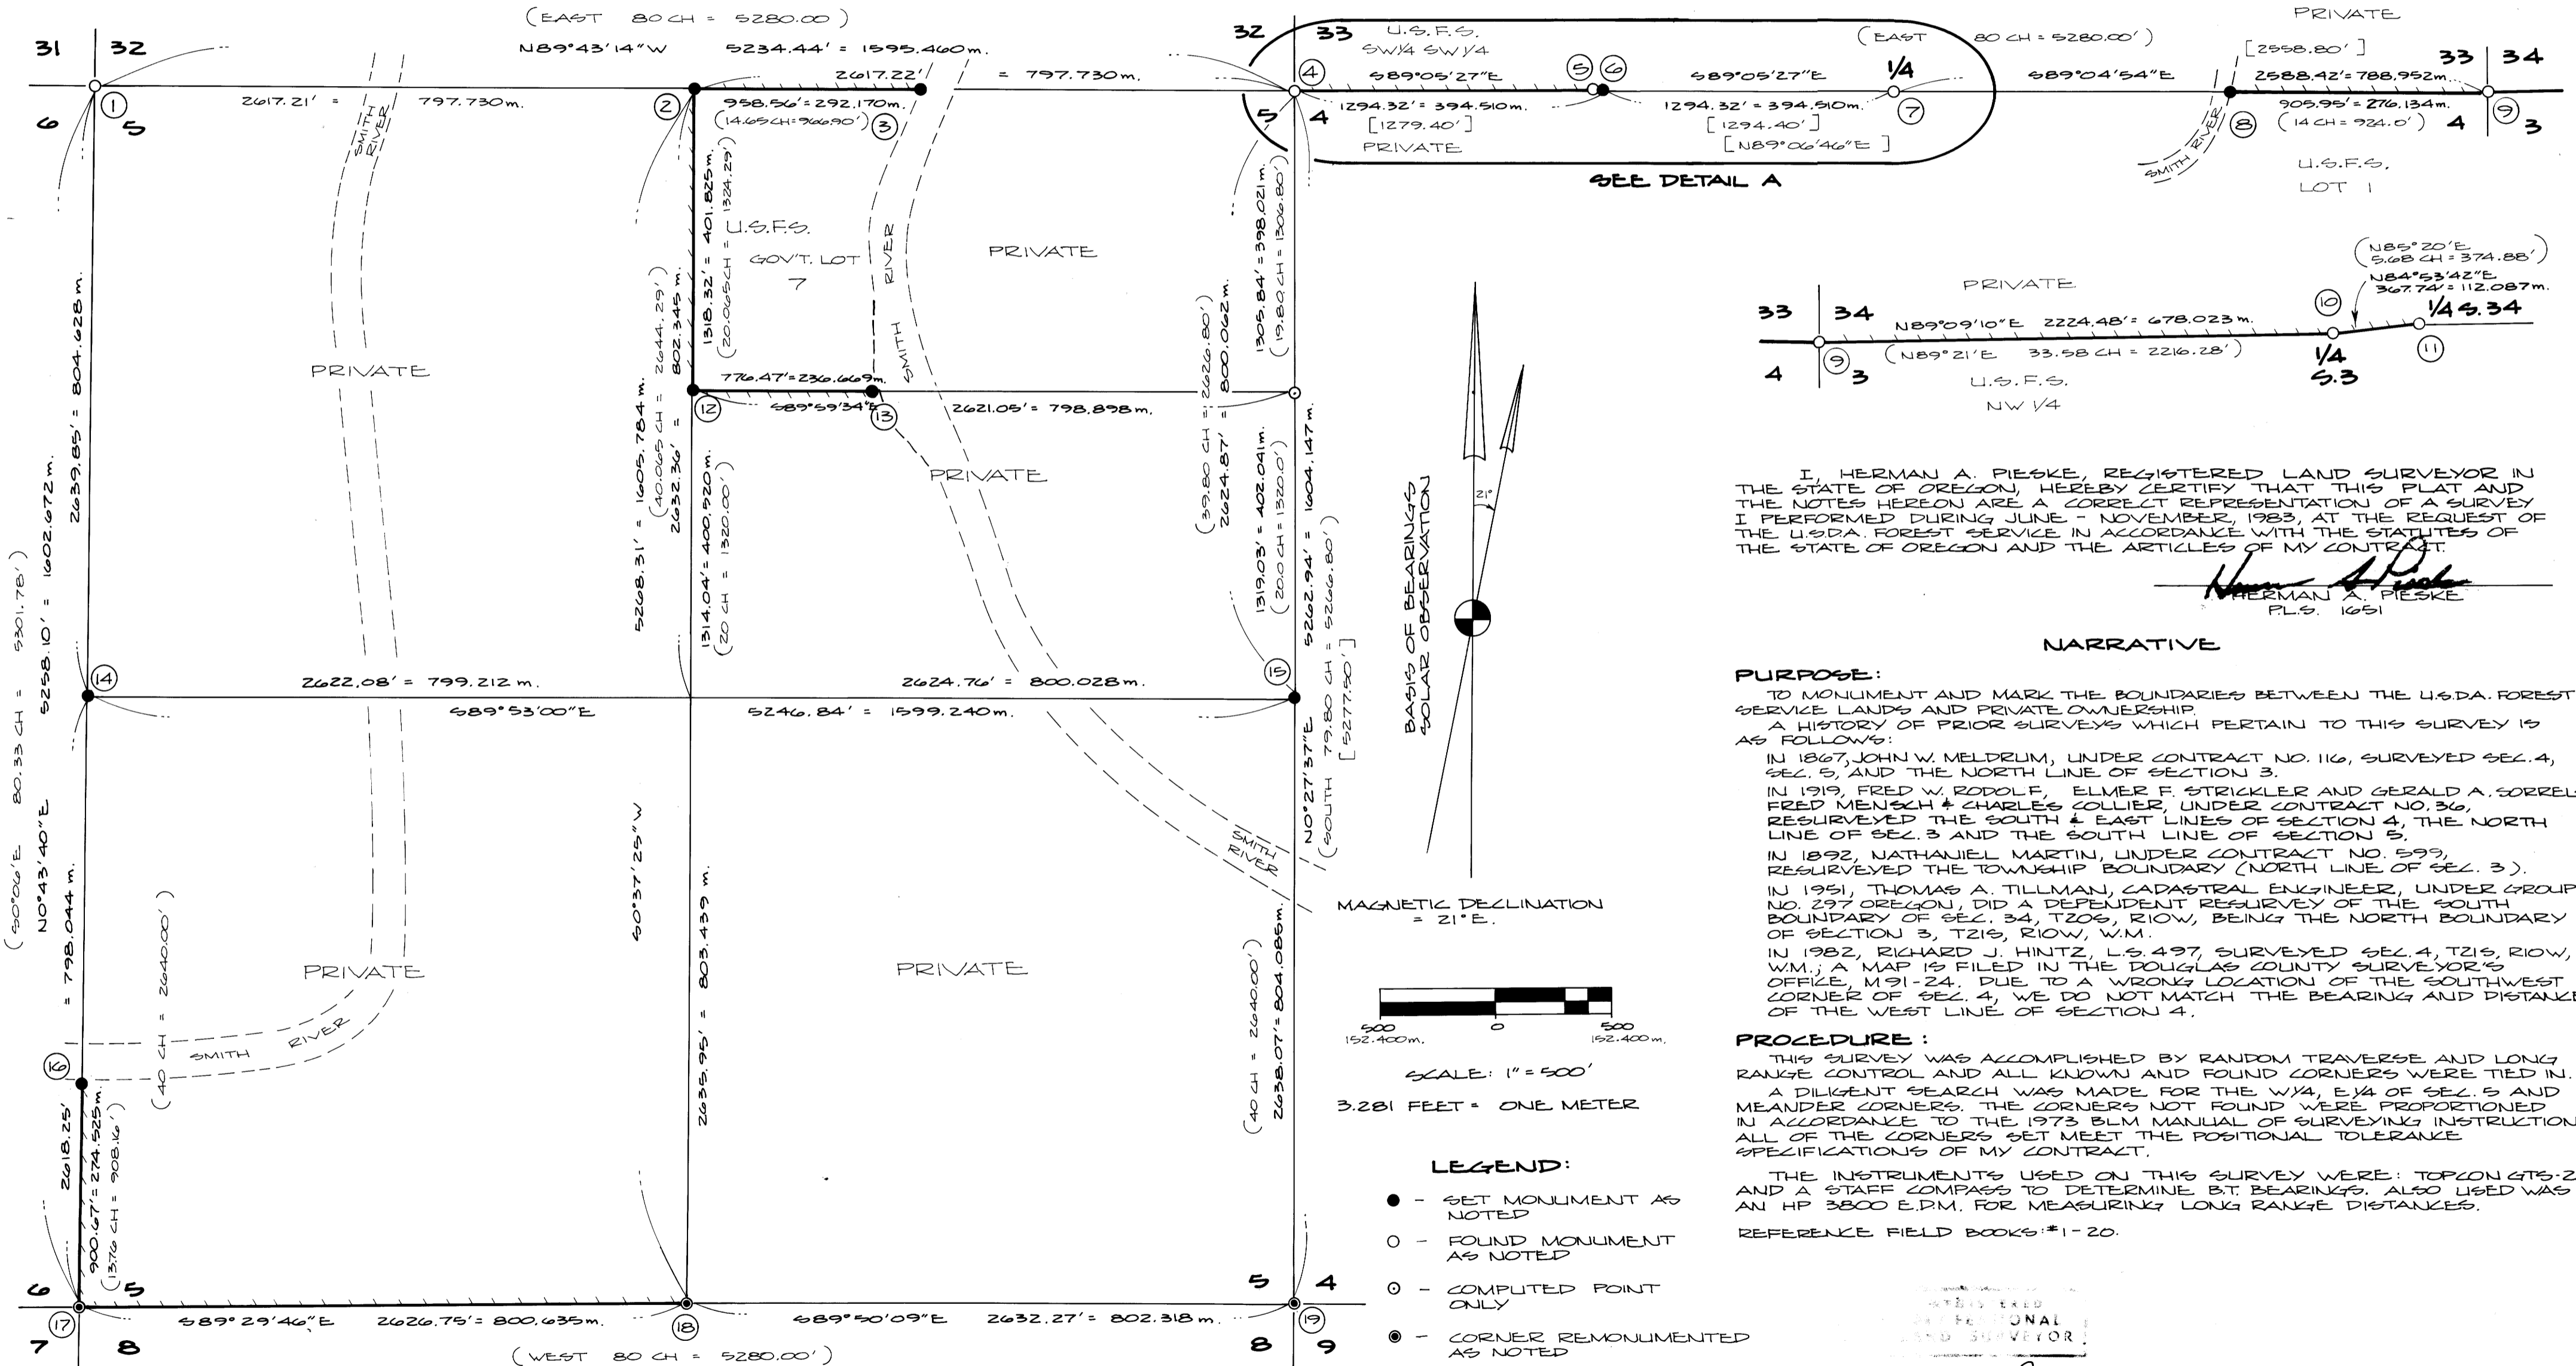

MAGNETIC DECLINATION = 21° E.

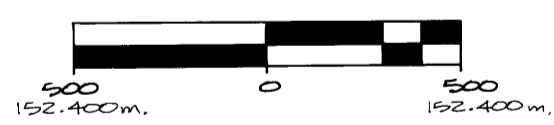

3.281 FEET = ONE METER

LEGEND:

- - SET MONUMENT AS NOTED
- - FOUND MONUMENT AS NOTED
- - COMPUTED POINT ONLY
- ⊙ - CORNER REMONUMENTED AS NOTED

I, HERMAN A. PIESKE, REGISTERED LAND SURVEYOR IN THE STATE OF OREGON, HEREBY CERTIFY THAT THIS PLAT AND THE NOTES HEREON ARE A CORRECT REPRESENTATION OF A SURVEY I PERFORMED DURING JUNE - NOVEMBER, 1983, AT THE REQUEST OF THE U.S.D.A. FOREST SERVICE IN ACCORDANCE WITH THE STATUTES OF THE STATE OF OREGON AND THE ARTICLES OF MY CONTRACT.

Herman A. Pieske
HERMAN A. PIESKE
P.L.S. 1051

NARRATIVE

PURPOSE:
TO MONUMENT AND MARK THE BOUNDARIES BETWEEN THE U.S.D.A. FOREST SERVICE LANDS AND PRIVATE OWNERSHIP.
A HISTORY OF PRIOR SURVEYS WHICH PERTAIN TO THIS SURVEY IS AS FOLLOWS:
IN 1867, JOHN W. MELDRUM, UNDER CONTRACT NO. 116, SURVEYED SEC. 4, SEC. 5, AND THE NORTH LINE OF SECTION 3.
IN 1919, FRED W. RODOLF, ELMER F. STRICKLER AND GERALD A. SORRELS, FRED MENSCH & CHARLES COLLIER, UNDER CONTRACT NO. 36, RESURVEYED THE SOUTH & EAST LINES OF SECTION 4, THE NORTH LINE OF SEC. 3 AND THE SOUTH LINE OF SECTION 5.
IN 1892, NATHANIEL MARTIN, UNDER CONTRACT NO. 599, RESURVEYED THE TOWNSHIP BOUNDARY (NORTH LINE OF SEC. 3).
IN 1951, THOMAS A. TILLMAN, CADASTRAL ENGINEER, UNDER GROUP NO. 297 OREGON, DID A DEPENDENT RESURVEY OF THE SOUTH BOUNDARY OF SEC. 34, T20S, R10W, BEING THE NORTH BOUNDARY OF SECTION 3, T21S, R10W, W.M.
IN 1982, RICHARD J. HINTZ, L.S. 497, SURVEYED SEC. 4, T21S, R10W, W.M.; A MAP IS FILED IN THE DOUGLAS COUNTY SURVEYOR'S OFFICE, M91-24. DUE TO A WRONG LOCATION OF THE SOUTHWEST CORNER OF SEC. 4, WE DO NOT MATCH THE BEARING AND DISTANCE OF THE WEST LINE OF SECTION 4.

PROCEDURE:
THIS SURVEY WAS ACCOMPLISHED BY RANDOM TRAVERSE AND LONG RANGE CONTROL AND ALL KNOWN AND FOUND CORNERS WERE TIED IN.
A DILIGENT SEARCH WAS MADE FOR THE W/4, E/4 OF SEC. 5 AND MEANDER CORNERS. THE CORNERS NOT FOUND WERE PROPORTIONED IN ACCORDANCE TO THE 1973 BLM MANUAL OF SURVEYING INSTRUCTIONS. ALL OF THE CORNERS SET MEET THE POSITIONAL TOLERANCE SPECIFICATIONS OF MY CONTRACT.
THE INSTRUMENTS USED ON THIS SURVEY WERE: TOPCON GTS-2 AND A STAFF COMPASS TO DETERMINE B.T. BEARINGS. ALSO USED WAS AN HP 3800 E.D.M. FOR MEASURING LONG RANGE DISTANCES.
REFERENCE FIELD BOOKS: #1-20.

Herman A. Pieske

PREPARED BY:
AA SURVEYING SERVICE, INC., P.O. BOX 130, ROSEBURG, OREGON 97470

FILE M 95-59A

M 95-59A

COUNTY SURVEYORS FILE DATA
DO NOT REMOVE FROM OFFICE

RECORD OF SURVEY

COOKED WASSEN CADASTRAL SURVEY

FOR THE U.S.D.A. FOREST SERVICE

SILUSLAW NATIONAL FOREST

SECTIONS 3, 4 & 5, T21S, R10W, W.M.
DOUGLAS COUNTY, OREGON
NOVEMBER 1983

1
85
2

M 95-59 B

1 SECTION CORNER 5-6-31-32


FOUND 1/2" IRON PIPE WITH 2 1/2" BRASS CAP SET IN CONC., MKD. AS SHOWN.

B.T.'S FOUND:

- 21" RED CEDAR BEARS N6°W 28.8 FT., WITH SCRIBED MARKS "BT S31" VISIBLE ON PARTIALLY HEALED FACE
- 27" D. FIR BEARS S43°E 85.0 FT., WITH HEALED FACE

B.T.'S SET:

- 13" D. FIR BEARS N55°E 80.7 FT., BLAZED AND SCRIBED "T20S R10W S32 BT"
- 19" BIG LEAF MAPLE BEARS S81°W 73.3 FT., BARK SCRIBED "T21S R10W S6 BT"

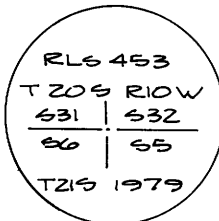


2 1/4 CORNER SECTIONS 5-32

SET 2 1/2" x 30" ALUM. PIPE, 24" IN THE GROUND, WITH 3/4" CAP MKD. AS SHOWN.

B.T.'S SET:

- 28" HEMLOCK BEARS N1°E 57.2 FT., SCRIBED "1/4 S 32 BT"
- 40" HEMLOCK BEARS S2°W 59.4 FT., SCRIBED "1/4 S 5 BT"

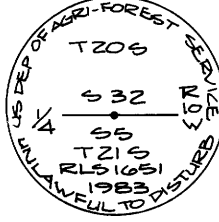


3 MEANDER CORNER SECTIONS 5-32

SET 2 1/2" x 30" ALUM. PIPE, 28" IN THE GROUND, WITH 3/4" ALUM. CAP MKD. AS SHOWN.

B.T.'S SET:

- 14" BIG LEAF MAPLE BEARS N18°E 31.8 FT., BLAZED AND SCRIBED "MC T21S R10W S32 BT"
- 22" BIG LEAF MAPLE BEARS S32°W 72.2 FT., BLAZED AND SCRIBED "MC T21S R10W S5 BT"

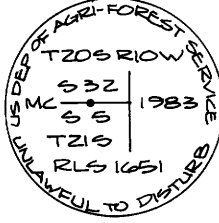


4 SECTION CORNER 4-5-32-33

FOUND 1" IRON PIPE WITH 2 1/2" BRASS CAP MKD. AS SHOWN.

B.T.'S FOUND:

- 20" FIR BEARS N3°E 83.6 FT., SHOWS VISIBLE SCRIBING
- FIR SNAG BEARS N29°E 23.6 FT.
- 7" FIR BEARS S1°E 16.4 FT., SHOWS VISIBLE SCRIBING
- 14" ALDER BEARS S72°W 18.2 FT., SHOWS VISIBLE SCRIBING
- 26" CEDAR BEARS N71°W 31.5 FT.
- 26" FIR STUMP BEARS N32 1/2°W 93.4 FT., SHOWS VISIBLE SCRIBING "BT"
- 38" FIR STUMP BEARS S72 1/2°W 18.0 FT. SHOWS OPEN FACE.

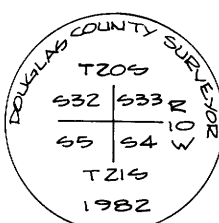

5 W 1/16 CORNER SECTIONS 4-33

FOUND WITNESS CORNER: SPIKE IN ASPHALT BEARS N89°05'27"W 15.00 FT. FROM TRUE CORNER LOCATION, FROM WHICH


B.T.'S FOUND:

- 18" ALDER BEARS N50°W 67.8 FT., SHOWS MARKS "WC BT"
- 12" ALDER BEARS S2°E 27.1 FT., SHOWS "WC BT" IN BARK

6 SET 2 1/2" x 30" ALUM. PIPE, 28" IN THE GROUND, IN MOUND OF STONES, WITH 3/4" ALUM. CAP MKD. AS SHOWN.

B.T.'S SET:

- 12" MAPLE BEARS N78°W 103.37 FT., BLAZED AND SCRIBED "W 1/16 S33 BT"
- 15" ALDER BEARS S19°E 19.4 FT., BARK SCRIBED "W 1/16 S4 BT"

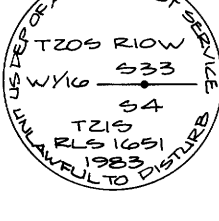

7 1/4 CORNER SECTIONS 4-33

FOUND REFERENCE MONUMENT: 1" IRON PIPE WITH 2 1/2" BRASS CAP MKD. AS SHOWN. BEARS SOUTH 2.0 FT. FROM TRUE CORNER LOCATION.

B.T.'S FOUND:

- 72" MAPLE BEARS S57°W 323.0 FT., SHOWS "1/4 S4 BT" IN OPEN FACE
- 32" D. FIR STUMP BEARS N65°E 265.3 FT., SHOWS "1/4 S33 BT" IN OPEN FACE



8 MEANDER CORNER SECTIONS 4-33


MEANDER CORNER FALLS IN A CREEK OF CHANNEL NEAR RIVER, IN UNSTABLE GROUND.

ON LINE 180 FT. FROM MEANDER CORNER:

SET WITNESS CORNER, 2 1/2" x 30" ALUM. PIPE, 27" IN THE GROUND WITH A 3/4" ALUM. CAP MKD. AS SHOWN.

B.T.'S SET:

- 24" ALDER BEARS N1°E 24.9 FT., BARK SCRIBED "X BT"
- 18" MAPLE BEARS S32°E 10.5 FT., WITH "X" CHOPPED IN AT BREAST HEIGHT. BLAZED AND SCRIBED "BT" AT BASE.

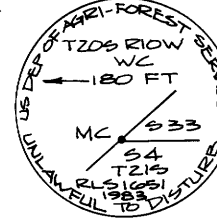

9 SECTION CORNER 3-4-33-34


FOUND 2" IRON PIPE LOOSELY SET 18" ABOVE GROUND WITH 3" BRASS CAP MKD. AS SHOWN, FIRMED UP.

B.T.'S FOUND:

- 36" D. FIR BEARS N67°E (75° RECORD) 148.49 FT., HEALED
- 35" HEMLOCK BEARS N84°W 64.3 FT., SCRIBES VISIBLE "R10W S33 BT US"
- 36" D. FIR BEARS S59°W 62.7 FT., HEALED BLAZE

B.T. SET:

- 36" BIG LEAF MAPLE BEARS S19°E 27.8 FT., BLAZED AND SCRIBED "T21S R10W S3 BT"

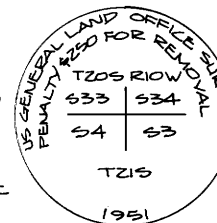


10 N 1/4 CORNER SECTION 3

FOUND 1" IRON PIPE WITH 2 1/2" BRASS CAP, 18" ABOVE GROUND, MKD. AS SHOWN.

TWO RUSTY 1" IRON PIPES APPROXIMATELY 2" EAST AND WEST FROM CAP

B.T.'S FOUND:

- 14" BIG LEAF MAPLE BEARS S22°E 12.9 FT., WITH HEALED FACE
- 14" D. FIR BEARS S36°W 20.2 FT., WITH HEALED FACE

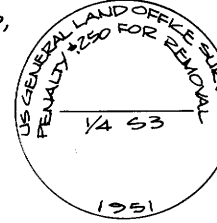

11 S 1/4 CORNER SECTION 34

FOUND 1" IRON PIPE WITH 2 1/2" BRASS CAP, 12" ABOVE GROUND, MKD. AS SHOWN.

B.T.'S FOUND:

- 32" D. FIR BEARS N5°W 43.6 FT., SHOWS HEALED FACE
- 34" D. FIR BEARS N12°E 63.7 FT., SHOWS HEALED FACE




12 CN 1/16 CORNER SECTION 5

SET 2 1/2" x 30" ALUM. PIPE, 26" IN THE GROUND, WITH 3/4" ALUM. CAP MKD. AS SHOWN.

B.T.'S SET:

- 14" D. FIR BEARS S39°E 64.6 FT., BLAZED AND SCRIBED "CN 1/16 S5 BT"
- 8" D. FIR BEARS N47°E 22.7 FT., BLAZED AND SCRIBED "CN 1/16 S5 BT"

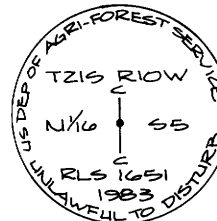


13 MEANDER CORNER SECTION 5

SET 2 1/2" x 30" ALUM. PIPE, 26" IN THE GROUND, WITH 3/4" CAP MKD. AS SHOWN.

B.T.'S SET:

- 26" CEDAR BEARS N32°W 48.0 FT., FACED AND SCRIBED "WP S5 BT"
- 22" D. FIR BEARS S14°W 77.2 FT., FACED AND SCRIBED "WP S5 BT"

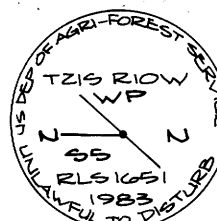


14 1/4 CORNER SECTIONS 5-6

SET 2 1/2" x 30" ALUM. PIPE, 26" IN THE GROUND, WITH 3/4" ALUM. CAP MKD. AS SHOWN.

B.T.'S SET:

- 15" D. FIR BEARS S25°W 19.9 FT., BLAZED AND SCRIBED "1/4 S6 BT"
- 9" D. FIR BEARS S48°E 14.0 FT., BLAZED AND SCRIBED "1/4 S5 BT"

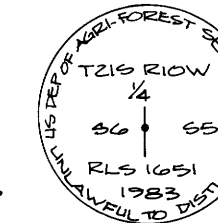


15 1/4 CORNER SECTIONS 4-5

SET 2 1/2" x 30" ALUM. PIPE, 26" IN THE GROUND, WITH 3/4" ALUM. CAP MKD. AS SHOWN.

B.T.'S SET:

- 6" D. FIR BEARS N72°E 76.6 FT., BLAZED AND SCRIBED "1/4 S4 BT"
- 8" D. FIR BEARS S83°W 30.0 FT., BLAZED AND SCRIBED "1/4 S5 BT"

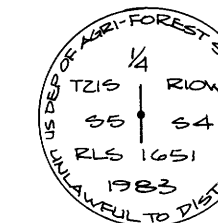


16 WITNESS CORNER MEANDER CORNER SECTIONS 5-6

SET 2 1/2" x 30" ALUM. PIPE, 20" IN THE GROUND, WITH ROCK MOUND AROUND, WITH 3/4" CAP MKD. AS SHOWN. WITNESS CORNER BEARS S0°43'40"W 62 FT. FROM TRUE POSITION.

B.T.'S SET:

- 48" FORKED CEDAR BEARS N87°W 26.5 FT., WITH "X" (1 FT. TALL) CHOPPED IN TREE AT CHEST HEIGHT. "BT" SCRIBED IN LOW FACE.
- 18" CEDAR BEARS N16°E 7.4 FT., WITH "X" (1 FT. TALL) CHOPPED IN TREE AT CHEST HEIGHT. "BT" SCRIBED IN LOW FACE.

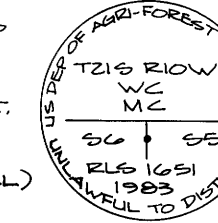

17 SECTION CORNER 5-6-7-8

FOUND 1" IRON PIPE FILLED WITH CONCRETE & RUSTED AND BROKEN OFF, WITH 2 1/2" BRASS CAP MKD. AS SHOWN.


B.T.'S FOUND:

- 36" FIR STUMP BEARS S78°E 27.0 FT. (REC. 44.2 FT.), SHOWS FRAGMENTARY MARKS.
- 16" CEDAR SNAG BEARS S20°W 46.4 FT. (REC. S30°W - 48.8 FT.), SHOWS OPEN FACE, NO MARKS BUT "H" CARVED IN BARK ABOVE FACE.
- 40" FIR STUMP BEARS N32°W 47.6 FT. (REC. 52.8 FT.) SHOWS NO MARKS.
- 40" CEDAR SNAG BEARS N34°E 55.2 FT. (REC. 59.2 FT.), NO VISIBLE MARKS.

SET 2 1/2" x 30" ALUM. PIPE AT POSITION OF FOUND PIPE, 24" IN THE GROUND, WITH MOUND OF STONE, WITH 3/4" ALUM. CAP MKD. AS SHOWN.

B.T.'S SET:

- 10" D. FIR BEARS S48 1/2°W 9.1 FT., BLAZED AND SCRIBED "T21S R10W S7 BT"
- 16" D. FIR BEARS N44°W 24.3 FT., BLAZED AND SCRIBED "T21S R10W S6 BT"
- 8" D. FIR BEARS N44 1/2°E 44.2 FT., BLAZED AND SCRIBED "T21S R10W S5 BT"
- 10" D. FIR BEARS S41°E 18.6 FT., BLAZED AND SCRIBED "T21S R10W S8 BT"

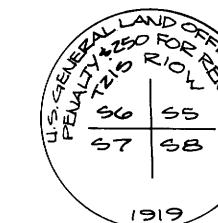

18 1/4 CORNER SECTIONS 5-8

FOUND 2" IRON PIPE RUSTED THROUGH AND BROKEN OFF WITH 2 1/2" BRASS CAP NEXT.


B.T.'S FOUND:

- 28" CEDAR BEARS N2°W 21.8 FT., PARTIALLY HEALED FACE
- 14" BIG LEAF MAPLE ROOT HOLE BEARS S5°W 27.1 FT. (TREE IS DOWNHILL)
- 38" D. FIR BEARS N19°E 33.7 FT., SHOWS GOOD SCAR

SET 2 1/2" x 30" ALUM. PIPE IN POSITION OF FOUND PIPE, WITH LARGE MOUND OF STONES, WITH 3/4" ALUM. CAP MKD. AS SHOWN. BURIED OLD PIPE AND CAP.

B.T.'S SET:

- 7" BIG LEAF MAPLE BEARS S69°W 37.7 FT., BLAZED AND SCRIBED "1/4 S8 BT"

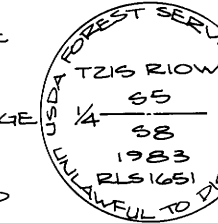

19 SECTION CORNER 4-5-8-9

FOUND 1 1/2" IRON PIPE FILLED WITH CONCRETE AND RUSTED THROUGH WITH 2 1/2" BRASS CAP NEXT TO. FOUND ROCK MOUND AROUND PIPE. BRASS CAP MKD. AS SHOWN.



B.T.'S FOUND:

- 30" ALDER BEARS S60°E 40.3 FT., SHOWS BARK SCRIBING "S9 BT"
- 10" MAPLE BEARS S34°W 13.6 FT., SHOW SCRIBING "S8 BT" ON OPEN FACE
- 30" CEDAR STUMP BEARS N32°W 24.8 FT., VERY ROTTEN, SHOWS AXE MARKS

SET 2 1/2" x 30" ALUM. PIPE AT POSITION OF FOUND PIPE, WITH 3/4" ALUM. CAP MKD. AS SHOWN. BURIED PIPE AND CAP.

B.T.'S SET:

- 13" ALDER BEARS N87°W 21.1 FT., BARK SCRIBED "T21S R10W S5 BT"
- 29" ALDER BEARS N34°E 233.2 FT., BARK SCRIBED "T21S R10W S4 BT"

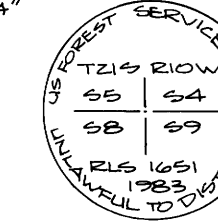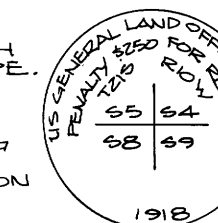

NOTE: EACH NEW BEARING TREE HAS A BRASS WASHER MKD. "RLS 1651" NAILED TO THE LOWER BLAZE.

Handwritten signature: *William A. Peck*

PREPARED BY:

AA SURVEYING SERVICE, INC., P. O. BOX 130, ROSEBURG, OREGON 97470

PAGE 2 OF 2

CONTRACT NO. 53-0470-3-0870N

See map M 95-59 B for approximate location of this survey. See also map M 95-59 B for approximate location of this survey. See also map M 95-59 B for approximate location of this survey.

MAP M 95-59 B

