

COUNTY SURVEYORS FILE DATA
DO NOT REMOVE FROM OFFICE

SUBDIVISION OF SECTION 4, T.27S., R. 6 W.W.M.
DECEMBER, 1983


SURVEYED FOR:
Umpqua Sand and Gravel Inc.
640 Shady Lane
Roseburg, OR. 97470

SURVEYED BY:
Baughman Technical Service Inc
5157 N.umpqua Hwy.
Roseburg, OR. 97470
Phone: 673-0966

FILED
RECEIVED
JAN 10 1984
COUNTY SURVEYOR
DOUGLAS COUNTY, ORE

LEGEND

- FD AS NOTED
- FD 5/8" I.R.
- Set 3/8" x 30" I.R. w/ Plastic Cap MK'd. "BAUGHMAN TECH. SERV."

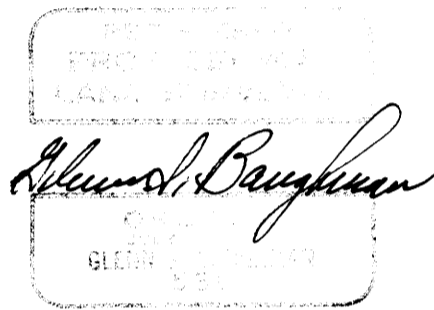

SCALE 1"=1000'

