


58/300  
Map File M.97-48

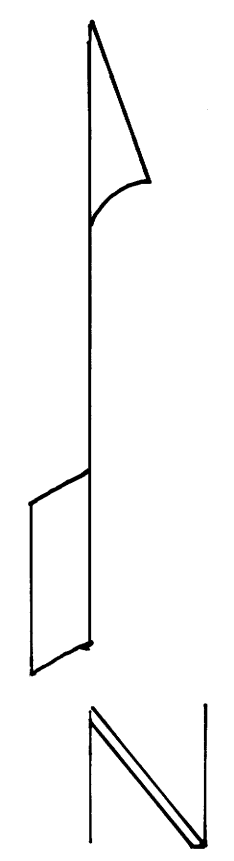

NORTH 1/4 CORNER SECTION 32  
FOUND: USBLM 2 1/2" ALUMINUM CAP (1981)  
14" FIR S 8 W 30 Iks. (1981)  
12" FIR N 1 1/2 E 35 Iks. (1981)  
1/2" GALVANIZED PIPE OF UNKNOWN ORIGIN  
BEARS N 41° 38' 43" E 25.29 ft.  
WITH ASSOCIATED BEARING TREES  
26" CEDAR N 8 1/2 W, 15.8 ft.  
26" FIR S 30 W, 9.6 ft.

NARRATIVE:

THIS SURVEY WAS MADE IN AUGUST, 1984 BY WEYERHAEUSER CO., P.O. BOX 275, SPRINGFIELD, OR. 97477. THE PURPOSE OF THIS SURVEY WAS TO LOCATE AND MARK THE PROPERTY OWNED BY WEYERHAEUSER COMPANY. A WILD TIG THEODOLITE AND WILD DIA-L WERE USED TO PERFORM THIS SURVEY. CLOSED RANDOM TRAVERSE WITH A MINIMUM OF 1/36,989' WAS RUN BETWEEN FOUND CORNERS FOR CONTROL. BEARINGS ARE BASED ON SOLAR OBSERVATIONS. OFFSETS TO THE PROPERTY LINE WERE CALCULATED AND USED TO DETERMINE THE POSITION OF THE TRUE PROPERTY LINE. THE PROPERTY LINE IS MARKED IN THE FIELD BY BLAZING TREES (BLAZES NOTCHED AND PAINTED RED). THE CENTER QUARTER CORNER WAS SET AT THE INTERSECTION POINT OF THE EAST-WEST AND NORTH-SOUTH CENTERLINES. THE CW 1/16 CORNER WAS SET AT THE MID-POINT BETWEEN THE ESTABLISHED CENTER 1/4 AND THE WEST 1/4 CORNERS, ALL ACCORDING TO THE "MANUAL OF INSTRUCTIONS FOR THE SURVEY OF THE PUBLIC LANDS OF THE UNITED STATES" (1973 EDITION). THE CORNERS SET IN THIS SURVEY ARE MONUMENTED WITH 1"x36" GALVANIZED IRON PIPE AND YELLOW PLASTIC CAPS INSCRIBED "WEYER CO.".

CW 1/16 CORNER SECTION 32  
SET: 1"x36" IRON PIPE WITH YELLOW PLASTIC CAP  
14" FIR S 36 E 6.5 ft. TO 'W' NAIL  
14" FIR S 23 W 8.5 ft. TO 'W' NAIL

WEST 1/4 CORNER SECTION 32  
FOUND: DOUGLAS COUNTY BRASS CAP (1964)  
12" FIR N 44 E 24.3 ft. (1964) CSBT  
26" MADRONE N 9 E 35.4 ft. (1964) CSBT  
12" FIR N 28 E 74 Iks. OBT 1855 DOWN AND ROTTEN.

CENTER 1/4 CORNER SECTION 32  
SET: 1"x36" IRON PIPE WITH YELLOW PLASTIC CAP  
34" FIR N 65 1/2 W, 39.1 ft. TO 'W' NAIL  
22" W. FIR S 41 1/2 W, 56.3 ft. TO 'W' NAIL  
FOUND: 1/2" GALVANIZED PIPE OF UNKNOWN ORIGIN  
BEARS N 18° 46' 05" W, 35.75 ft.  
WITH ASSOCIATED BEARING TREE  
36" FIR S 59 W, 31.7 ft.

EAST 1/4 CORNER SECTION 32  
FOUND: USBLM 2 1/2" BRASS CAP (1981)  
18" FIR N 63 1/4 E, 46 Iks. (1981)  
24" FIR N 34 W, 4 Iks. (1981)  
36" OAK N 63 W, 550 Iks. OBT (1855)

LEGEND:

- BASIS OF BEARING - SOLAR OBSERVATION
- SCALE 1" = 400'
- CORNERS FOUND ●
- CORNERS SET ○ - 1"x36" IRON PIPE WITH YELLOW PLASTIC CAP INSCRIBED "WEYER CO."
- ||— PROPERTY LINE BLAZED

NOTE: ALL BEARINGS TO BT'S ARE MAGNETIC VARIATION OF 20° EAST. DISTANCES TO BEARING TREES ARE CENTER MEASURE UNLESS NOTED OTHERWISE.

SOUTH 1/4 CORNER SECTION 32  
FOUND: DOUGLAS COUNTY BRASS CAP (1959)  
24" MADRONE S 54 1/2 E 44.2 ft. (1959) CSBT  
38" FIR N 7 E 19.4 ft. DOWN AND OUT OF PLACE (1959) CSBT  
13" FIR S 71 1/2 E 70.3 ft. (1959) CSBT

FRANK W. WILLIAMS  
PROFESSIONAL SURVEYOR  
JULY 12, 1980  
FRANK W. WILLIAMS  
OREGON

SURVEY OF  
SECTION 32, TRIS, R5W, W.M.  
DOUGLAS COUNTY, OREGON  
FOR  
WEYERHAEUSER CO.  
BY  
WEYERHAEUSER CO.  
P.O. BOX 275  
SPRINGFIELD, OR. 97477  
AUGUST 25, 1984

PROPERTY INFORMATION FILED  
DO NOT REMOVE FROM OFFICE

Map File M.97-48  
58/300