

RECORD OF SURVEY

COOKED WASSEN CADASTRAL SURVEY FOR THE U.S.D.A. FOREST SERVICE SILUSLAW NATIONAL FOREST

SECTION 6, T21S, R10W, W.M.
DOUGLAS COUNTY, OREGON
NOVEMBER 1984

COUNTY SURVEYORS FILE DATA
DO NOT REMOVE FROM OFFICE

REGISTERED
PROFESSIONAL
LAND SURVEYOR

Herman A. Pieske

OREGON
JULY 14, 1978
HERMAN A. PIESKE
1651

FILED
RECORDED *JP*

COUNTY SURVEYOR
DOUGLAS COUNTY, OREGON
88

Herman A. Pieske
HERMAN A. PIESKE
P.L.S. 1651

I, HERMAN A. PIESKE, REGISTERED LAND SURVEYOR IN THE STATE OF OREGON, HEREBY CERTIFY THAT THIS PLAT AND THE NOTES HEREON ARE A CORRECT REPRESENTATION OF A SURVEY I PERFORMED DURING JULINE, 1983-NOVEMBER, 1984, AT THE REQUEST OF THE U.S.D.A. FOREST SERVICE IN ACCORDANCE WITH THE STATUTES OF THE STATE OF OREGON AND THE ARTICLES OF MY CONTRACT.

NARRATIVE:

PURPOSE:

TO MONUMENT AND MARK THE BOUNDARIES BETWEEN THE SILUSLAW NATIONAL FOREST LANDS AND PRIVATE OWNERSHIP.

HISTORY:

A HISTORY OF PRIOR SURVEYS WHICH PERTAIN TO THIS SURVEY IS AS FOLLOWS:

IN 1867, JOHN W. MELDRUM, UNDER CONTRACT NO. 202, SURVEYED SECTION 6.

IN 1919, FRED W. RUDOLF, ELMER F. STRICKLER AND GERALD A. BORRELS, UNDER CONTRACT NO. 36, RESURVEYED THE SOUTH BOUNDARY OF SECTION 6.

IN 1983, AA SURVEYING SERVICE, INC., UNDER CONTRACT NO. 53-04TO-3-0870N, SURVEYED THE EAST BOUNDARY OF SECTION 6 AND FILED THE MAP IN THE DOUGLAS COUNTY SURVEYOR'S OFFICE PER M95-59.

PROCEDURE:

THIS SURVEY WAS ACCOMPLISHED BY RANDOM TRAVERSE AND LONG RANGE CONTROL; WITH ALL KNOWN AND FOUND CORNERS TIED IN. I FOUND AND REMONUMENTED THE FOLLOWING CORNERS: THE SOUTH ONE-QUARTER CORNER OF SECTION 6.

I MADE A DILIGENT SEARCH FOR ALL OF THE CORNERS MENTIONED BELOW, AS BEING SET BY PROPORTIONAL METHODS.

THE FOLLOWING CORNERS WERE SET BY PROPORTION: MEANDER CORNER BETWEEN SECTIONS 6 AND 31; NORTH ONE-QUARTER CORNER; N¹/₁₆, S¹/₁₆ AND W¹/₄ CORNERS ON THE RANGE LINE; THE W¹/₁₆ CORNER FOR SECTION 6 ONLY AND THE W¹/₁₆ CORNER FOR SECTION 7 ONLY ON THE SOUTH LINE OF SEC. 6.


THE REASON THAT THE W¹/₁₆ FOR SECTION 6 ONLY AND THE W¹/₁₆ FOR SECTION 7 ONLY ARE OFFSET IS: SECTION 6 WAS SURVEYED IN 1874 AND SECTION 7 IN 1919. THE LINE BETWEEN SECTION 6 AND SECTION 7 DIFFERED BETWEEN SURVEYS (AS INDICATED ON THE ANNEXED MAP); THEREFORE THE SECTIONS MUST BE SUBDIVIDED ON THEIR OWN DATA.

THE CORNERS REMONUMENTED AND PROPORTIONED WERE DONE ACCORDING TO THE 1973 BLM MANUAL OF SURVEYING INSTRUCTIONS. ALL OF THE CORNERS SET MEET THE POSITIONAL TOLERANCE SPECIFICATIONS OF MY CONTRACT.

THE INSTRUMENTS USED ON THIS SURVEY WERE TOPCON GTS-1, GTS-2, DICM-2 E.D.M., LEITZ TM 20-C, WILD T-2 AND HP 3800 E.D.M.

REFERENCE FIELD BOOKS: #1 - #37.

MAP FILE M 97-76A

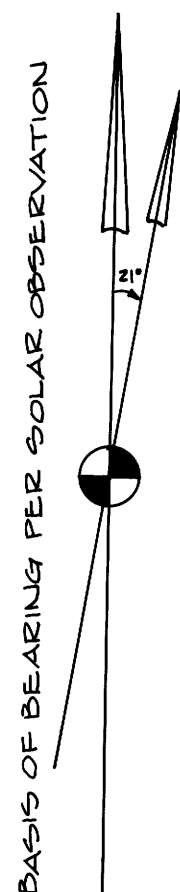


MAGNETIC DECLINATION = 21°E

LEGEND:



- - FOUND MONUMENT AS NOTED
- - SET MONUMENT AS NOTED
- ⊙ - CORNER REMONUMENTED AS NOTED

NOTES:

1. BASIS OF BEARINGS AND BEARINGS CHECKS ARE FROM SOLAR OBSERVATIONS.
2. () - INDICATES DATA OF RECORD PER G.L.O. RESURVEY IN 1919, CONTRACT NO. 36
3. () - INDICATES DATA OF RECORD PER G.L.O. SURVEY IN 1867, CONTRACT NO. 202
4. [] - INDICATES DATA OF RECORD PER G.L.O. SUPPLEMENTAL PLAT, 1930
5. --- INDICATES LINES POSTED THIS SURVEY WITH 6 FT. ORANGE FIBERGLASS POSTS
6. XX - INDICATES LINE PREVIOUSLY POSTED
7. S.N.F. - SILUSLAW NATIONAL FOREST

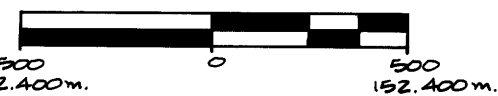

SCALE: 1" = 500'
3,280.83 FEET = ONE METER

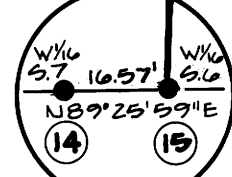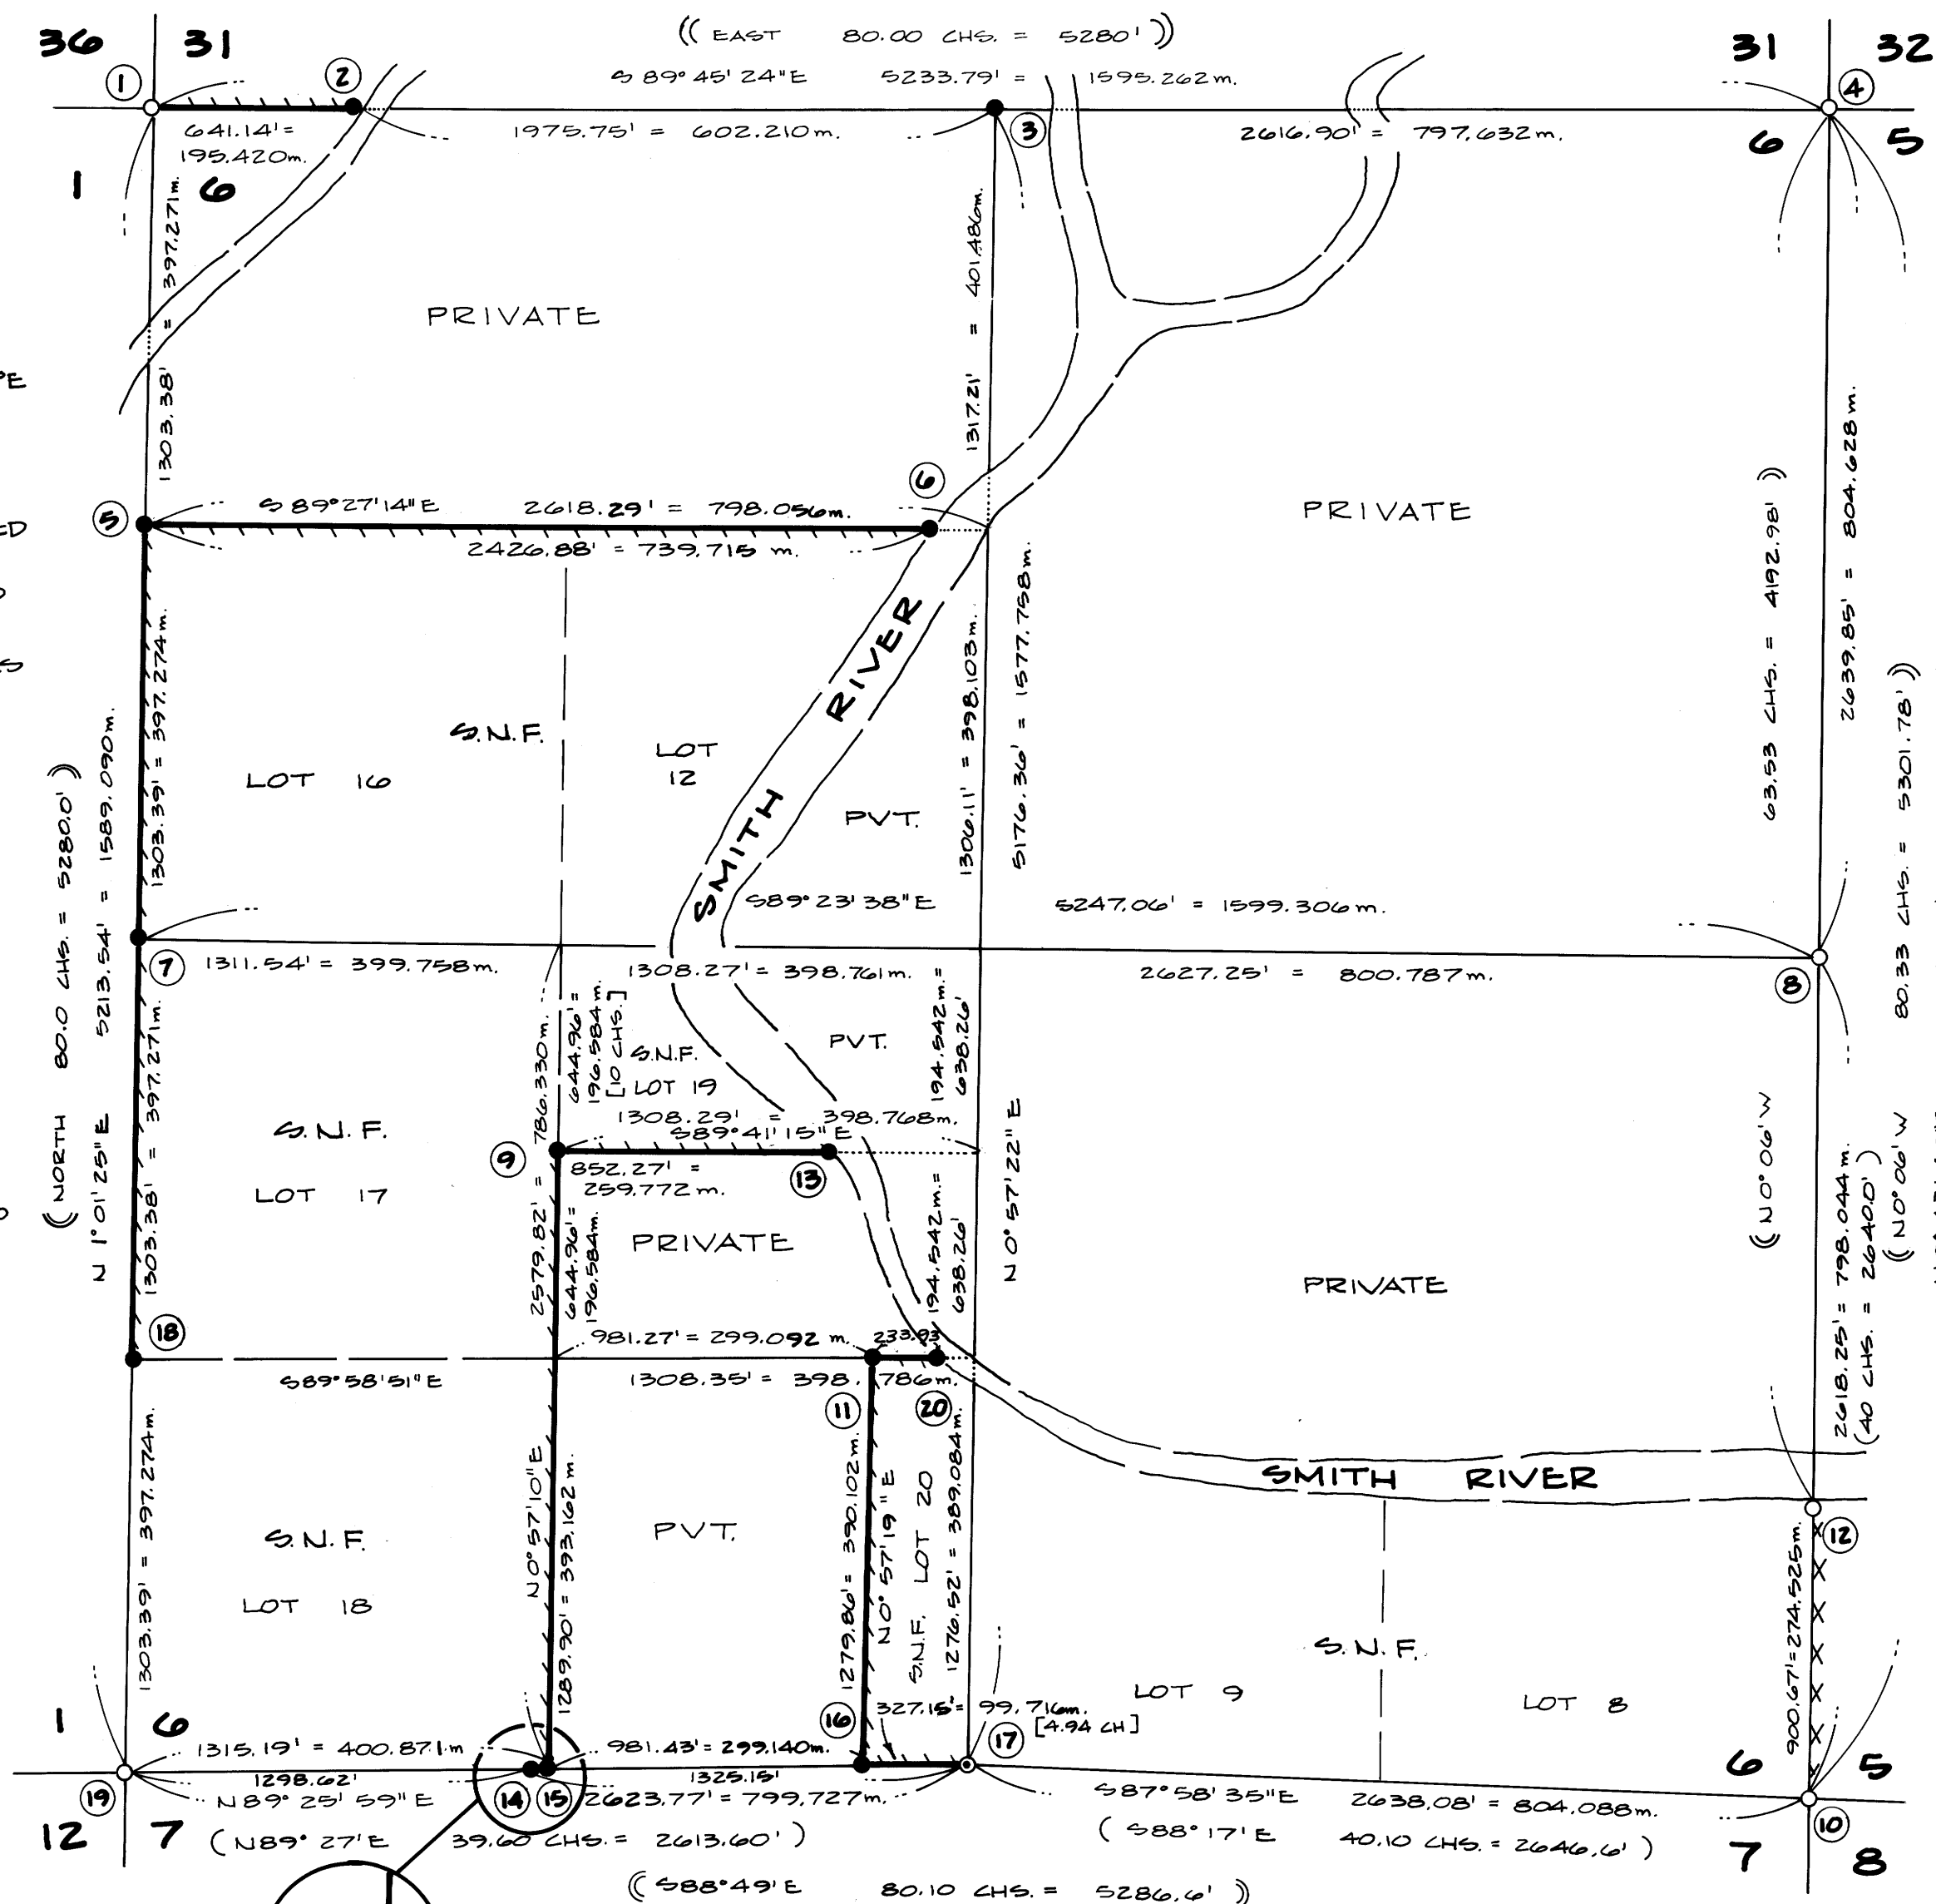

PREPARED BY:

AA SURVEYING SERVICE, INC., P.O. BOX 130, ROSEBURG, OREGON 97470

MAP FILE M 97-76A

RECORD OF SURVEY
COOKED WASSER CADASTRAL SURVEY
FOR THE U.S.D.A. FOREST SERVICE
SILUSLAW NATIONAL FOREST

SECTION 6, TZ1S, R10W, W.M.
 DOUGLAS COUNTY, OREGON
 NOVEMBER 1984

COUNTY SURVEYORS FILE DATA
 DO NOT REMOVE FROM OFFICE


FILED
 11/28
 COUNTY CLERK
 DOUGLAS COUNTY, OREGON

88
 89
 M 97-768

① **SECTION CORNER 1-6-31-36**

FOUND 1" IRON PIPE WITH 2 1/2" BRASS CAP MKD AS SHOWN, WITH 2" (O.P.) IRON PIPE NEXT TO IT.


- B.T.'S FOUND:
- 32" MAPLE (3 MAIN TRUNKS) BEARS N14°W 12.2 FT, GOOD SCAR
 - 18" D FIR BEARS N80°E 84.0 FT, GOOD SCAR
 - 33" D FIR BEARS S74°E 43.0 FT, GOOD SCAR
 - 19" MAPLE WINDFALL BEARS S28°W 10.7 FT, GOOD SCAR

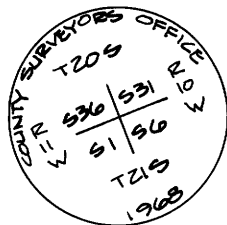

② **MEANDER CORNER SECTIONS 6-31**

SET 2 1/2" x 30" ALUM. PIPE, 27" IN THE GROUND, WITH 3/4" ALUM. CAP MKD AS SHOWN. CONSTRUCTED MOUND OF STONES AROUND PIPE.

- NEW B.T.'S SET:
- 18" ALDER BEARS S25°W 95.5 FT, BARK SCRIBED "MC S6 BT" TZ1S R10W
 - 20" MAPLE BEARS N53°E 56.2 FT, BLAZED AND SCRIBED "MC S31 BT" TZ0S R10W

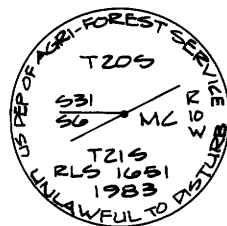

③ **1/4 CORNER SECTIONS 6-31**

SET 2 1/2" x 30" ALUM. PIPE WITH 3/4" ALUM. CAP MKD AS SHOWN. SET PIPE AND CAP 12" BELOW GROUND IN PASTURE.


- NEW B.T.'S SET:
- 10" ALDER BEARS N85°47'E 170.7 FT, BARK SCRIBED "1/4 S31 BT"
 - 12" ALDER BEARS S29°10'W 264.2 FT, BARK SCRIBED "1/4 S6 BT"



④ **SECTION CORNER 5-6-31-32**

FOUND 1 1/2" IRON PIPE WITH 2 1/2" BRASS CAP MKD AS SHOWN, SET IN CONCRETE.


- B.T.'S FOUND:
- 21" RED CEDAR BEARS N6°W 28.8 FT, SCRIBE "BT S31" VISIBLE ON PARTIALLY HEALED FACE
 - 27" D FIR BEARS S43°E 85.0 FT, HEALED FACE
 - 13" D FIR BEARS N55°E 80.7 FT, BLAZED AND SCRIBED "TZ0S R10W S32 BT"
 - 19" BIGLEAF MAPLE BEARS S81°W 73.3 FT, BARK SCRIBED "TZ1S R10W S6 BT"

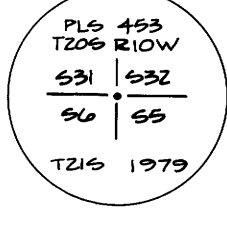

⑤ **N 1/16 CORNER SECTIONS 1-6**

SET 2 1/2" x 30" ALUM. PIPE, 29" IN THE GROUND, WITH 3/4" ALUM. CAP MKD AS SHOWN. FOUND 1/4" IRON ROD WHICH BEARS S75°W 8.45 FT. FROM SET MONUMENT, (ORIGIN UNKNOWN).


- NEW B.T.'S SET:
- 10" CEDAR BEARS S76°E 84.4 FT, SCRIBED "N 1/16 S6 BT" IN DOUBLE BLAZE
 - 12" ALDER BEARS S52°E 46.4 FT, SCRIBED "N 1/16 S6 BT" IN BARK
 - 36" MAPLE BEARS N30°W 62.5 FT, SCRIBED "N 1/16 S1 BT"

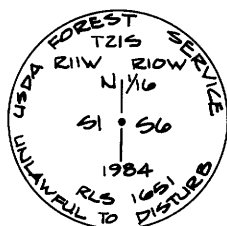

⑥ **W.P. CORNER SECTION 6**

SET 2 1/2" x 30" ALUM. PIPE, 28" IN THE GROUND, WITH 3/4" ALUM. CAP MKD AS SHOWN.

- NEW B.T.'S SET:
- 12" MAPLE BEARS N17°30'E 63.9 FT, SCRIBED "WP S6 BT"
 - 46" MAPLE BEARS N59°30'W 40.6 FT, SCRIBED "WP S6 BT"

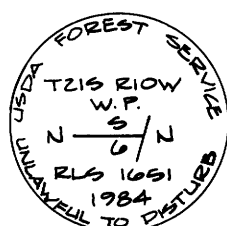

⑦ **1/4 CORNER SECTIONS 1-6**

SET AT PROPER POSITION 2 1/2" x 30" ALUM. PIPE, 28" IN THE GROUND, WITH 3/4" ALUM. CAP MKD AS SHOWN.


- NEW B.T.'S SET:
- 36" HEMLOCK BEARS N19°E 84.8 FT, SCRIBED "1/4 S6 BT" IN DOUBLE BLAZE
 - 27" CEDAR BEARS N97°E 67.2 FT, SCRIBED "1/4 S6 BT" IN DOUBLE BLAZE
 - 32" CEDAR BEARS N1°W 48.6 FT, SCRIBED "1/4 S1 BT"



⑧ **1/4 CORNER SECTIONS 5-6**

FOUND 2 1/2" ALUM. PIPE, 26" IN THE GROUND, WITH 3/4" ALUM. CAP MKD AS SHOWN.


- B.T.'S FOUND:
- 15" D FIR BEARS S25°W 19.9 FT, BLAZED AND SCRIBED "1/4 S6 BT"
 - 9" D FIR BEARS S48°E 14.0 FT, BLAZED AND SCRIBED "1/4 S5 BT"

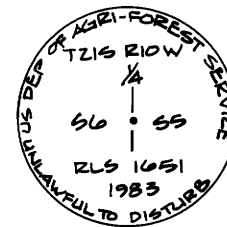

⑨ **C.N.-SW 1/4 CORNER SECTION 6**

SET AT PROPER POSITION 2 1/2" x 30" ALUM. PIPE, 18" IN THE GROUND, WITH 3/4" ALUM. CAP MKD AS SHOWN, WITH MOUND OF STONE.


- NEW B.T.'S SET:
- 32" MAPLE BEARS N6°W 27.6 FT, SCRIBED "CNSW 1/4 S6 BT"
 - 26" ALDER BEARS N44°W 9.8 FT, SCRIBED "CNSW 1/4 S6 BT"

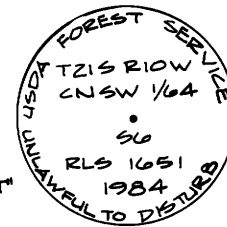

⑩ **SECTION CORNER 5-6-7-8**

FOUND 2 1/2" ALUM. PIPE, 6" ABOVE GROUND, WITH 3/4" ALUM. CAP MKD AS SHOWN, WITH 1 1/2" IRON PIPE BURIED ALONGSIDE.


- B.T.'S FOUND:
- 36" FIR STUMP BEARS S78°E 27.0 FT. (REC. 44.2 FT.), SHOWS FRAGMENTARY MARKS
 - 16" CEDAR SNAG BEARS S20°W 46.4 FT. (REC. S30°W 48.8 FT.), OPEN FACE, NO MARKS, "H" CARVED IN BARK ABOVE FACE
 - 40" FIR STUMP BEARS N32°W 47.6 FT. (REC. 52.8 FT.), NO MARKS
 - 40" CEDAR SNAG BEARS N34°E 55.2 FT. (REC. 59.2 FT.), NO VISIBLE MARKS
 - 10" D FIR BEARS S48 1/2°W 9.1 FT, SCRIBED "TZ1S R10W S7 BT"
 - 16" D FIR BEARS N44°W 24.3 FT, SCRIBED "TZ1S R10W S6 BT"
 - 8" D FIR BEARS N44 1/2°E 44.2 FT, SCRIBED "TZ1S R10W S5 BT"
 - 10" D FIR BEARS S41°E 18.6 FT, SCRIBED "TZ1S R10W S8 BT"

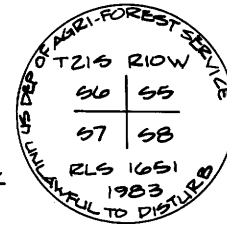

⑪ **C-E-E-SW 1/256 CORNER SECTION 6**

SET AT PROPER LOCATION 2 1/2" x 30" ALUM. PIPE, 18" IN THE GROUND, WITH 3/4" ALUM. CAP MKD AS SHOWN.


- NEW B.T.'S SET:
- 16" ALDER BEARS S7°W 5.6 FT, SCRIBED "CEESW 1/256 S6 BT"
 - 16" CEDAR BEARS N50°E 42.8 FT, SCRIBED "CEESW 1/256 S6 BT"

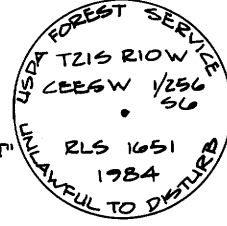

⑫ **W.C. MEANDER CORNER SECTIONS 5-6**

FOUND 2 1/2" ALUM. PIPE, 10" ABOVE GROUND, WITH 3/4" CAP MKD AS SHOWN, WITH EDGE MOUND. WITNESS CORNER BEARS 50°43'40" W 62 FT. FROM TRUE POSITION.


- B.T.'S FOUND:
- 48" FORKED CEDAR BEARS N87°W 26.5 FT, "X" (1 FT TALL) CHOPPED IN TREE AT CHEST HEIGHT
 - 18" CEDAR BEARS N16°E 7.4 FT, "X" CHOPPED IN TREE AT CHEST HEIGHT

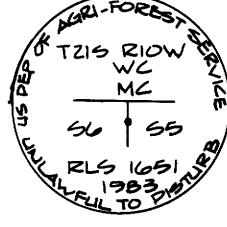

⑬ **W.P. SECTION 6**

SET AT PROPER POSITION ON WEST BANK OF SMITH RIVER ON SOUTH LINE OF LOT 19, 2 1/2" x 30" ALUM. PIPE, 27" IN THE GROUND, WITH 3/4" ALUM. CAP MKD AS SHOWN.


- NEW B.T.'S SET:
- 8" CEDAR BEARS S14°W 56.9 FT, SCRIBED "WP S6 BT"
 - 30" CEDAR BEARS N25°W 52.1 FT, SCRIBED "WP S6 BT"

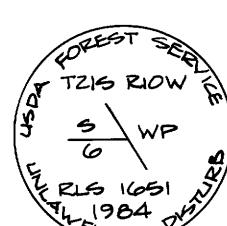

⑭ **W 1/16 CORNER SECTION 7**

SET 2 1/2" x 30" ALUM. PIPE, 28" IN THE GROUND, WITH 3/4" ALUM. CAP, WITH MOUND OF STONE.


- NEW B.T.'S SET:
- 24" D FIR BEARS S11°W 42.4 FT, SCRIBED "W 1/16 S7 BT"
 - 8" ALDER BEARS S72°E 19.1 FT, SCRIBED "W 1/16 S7 BT"

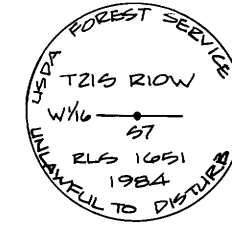

⑮ **W 1/16 CORNER SECTION 6**

SET 2 1/2" x 30" ALUM. PIPE, 26" IN THE GROUND, WITH 3/4" ALUM. CAP MKD AS SHOWN, WITH MOUND OF STONE.


- NEW B.T.'S SET:
- 36" D FIR BEARS N25°W 26.3 FT, SCRIBED "W 1/16 S6 BT"
 - 21" D FIR BEARS N60°E 30.7 FT, SCRIBED "W 1/16 S6 BT"

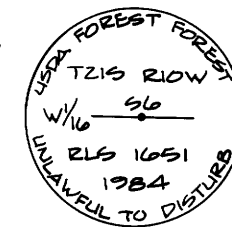

⑯ **E-E-W 1/256 CORNER SECTION 6 ONLY**

SET 2 1/2" x 30" ALUM. PIPE, 27" IN THE GROUND, WITH 3/4" ALUM. CAP MKD AS SHOWN.

- NEW B.T.'S SET:
- 30" CEDAR BEARS S32°W 59.9 FT, SCRIBED "EEW 1/256 S7 BT"
 - 8" ALDER BEARS N42°W 23.1 FT, SCRIBED "EEW 1/256 S6 BT"

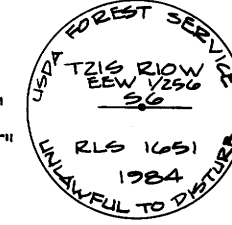


⑰ **1/4 CORNER SECTIONS 6-7**

FOUND 1" IRON PIPE, CAP BROKEN OFF LYING ALONGSIDE, MKD AS SHOWN.

- B.T.'S FOUND:
- 36" ORIGINAL FIR STUMP, BADLY ROTTED, BEARS S60°W 4.2 FT, NO FACE VISIBLE
 - 42" FIR STUMP, BADLY ROTTED, BEARS N30°W 11.1 FT, VISIBLE SCRIBES "1/4 S6"

SET 2 1/2" x 30" ALUM. PIPE, 24" IN THE GROUND, WITH 3/4" ALUM. CAP MKD AS SHOWN. BURIED G.L.O. CAP ALONGSIDE.


- NEW B.T.'S SET:
- 16" FORKED D FIR BEARS N36°W 15.3 FT. (B' FORK TO WEST) FACED AND SCRIBED "1/4 S6 BT"
 - 28" D FIR BEARS S29°W 17.5 FT, FACED AND SCRIBED "1/4 S7 BT"

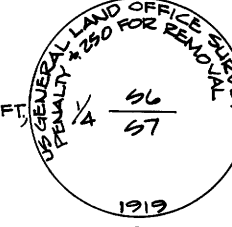

⑱ **S 1/16 CORNER SECTIONS 1-6**

SET 2 1/2" x 30" ALUM. PIPE, 26" IN THE GROUND, IN LARGE MOUND OF STONE, WITH 3/4" ALUM. CAP MKD AS SHOWN.


- NEW B.T.'S SET:
- 14" D FIR BEARS S23°W 15.2 FT, SCRIBED "S 1/16 S1 BT"
 - 9" ALDER BEARS S55°E 26.3 FT, SCRIBED "S 1/16 S6 BT"

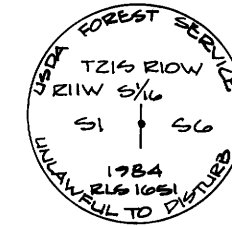

⑲ **SECTION CORNER 1-6-7-12**

FOUND 3/4" REBAR WITH 2" ALUM. CAP MKD AS SHOWN.


- FOUND B.T.'S:
- 12" ALDER BEARS S45°E 10.5 FT, BARK SCRIBED "S7 TZ1S R10W BT"
 - 8" HEMLOCK BEARS N89°W 47.9 FT, BARK SCRIBED "S1 TZ1S R11W BT"
 - 15" ROTTED CEDAR SNAG BEARS S81°E 43.6 FT, NO SCRIBES VISIBLE
 - 45" CEDAR BEARS S4°E 44.10 FT, SCRIBED "S7 BT"
 - 6" D FIR BEARS N40°E 40.6 FT, SCRIBED "S6 BT"

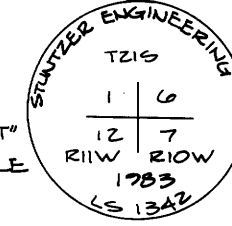

⑳ **W.P. SECTION 6**

SET 2 1/2" x 30" ALUM. PIPE, 27" IN THE GROUND, WITH STONE MOUND, WITH 3/4" ALUM. CAP MKD AS SHOWN.

- NEW B.T.'S SET:
- 16" CEDAR BEARS N88°W 12.7 FT, BLAZED AND SCRIBED "WP S6 BT"
 - 24" MAPLE BEARS S46°E 55.25 FT, BLAZED AND SCRIBED "WP S6 BT"

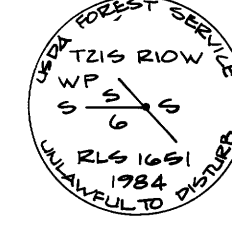

NOTE: EACH NEW BEARING TREE HAS A BRASS WASHER MKD. "RLS 1651" NAILED TO THE LOWER BLAZE.

REGISTERED
 PROFESSIONAL
 LAND SURVEYOR

 OREGON
 JULY 14, 1978
 HERMAN A. PIESKE
 1651

PREPARED BY:

AA SURVEYING SERVICE, INC., P.O. BOX 130, ROSEBURG, OREGON 97470

MAP FILE M 97-768