

COUNTY SURVEYORS FILE DATA
DO NOT REMOVE FROM OFFICE

SURVEY TO SET PROPERTY CORNER
Lot 6 Block 2 "Three Pines"
in the W1/2 Section 17, T.27S. R.5W. W.M.
MAY 1985

FILED CMO
RECEIVED *L*
MAY 14 1985

COUNTY SURVEYOR
DOUGLAS COUNTY, ORE.
CMO

FOR: Walter Degener

BY: AA Surveying Service, Inc.
P.O. Box 130
Roseburg, Oregon 97470

SCHICK ST.

3/4" I.P.

(100.0')
99.14'

3/4" I.P.

(100.0')
99.14'

3/4" I.P.

(100.0')
100.61'

3/4" I.P.

(150.0')
149.77'


(130.0')
129.80'

1/2" I.P.

(130.0')
129.60'

RIFLE RANGE ROAD

(PLAT REC. N 0° 28' E)

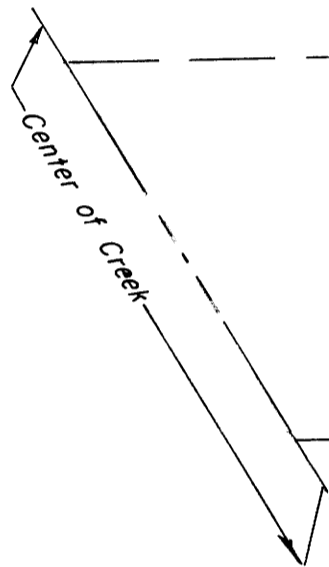

SCALE: 1" = 50'

LEGEND

- — Found mon. as noted
- — Set 5/8" I.R. w/plastic cap marked "A A SURVEYING INC" (24" LENGTH)

NARRATIVE

I found the monuments as indicated hereon and proportioned the lot corner common to Lots 5 & 6 and set a monument as shown.

Instrument Used: TopCon GTS-2 Total Station

REGISTERED PROFESSIONAL LAND SURVEYOR

Eugene Bloom

OREGON
EUGENE A. BLOOM
1992

BASIS OF BEARINGS
PER M53-47, M49-67, M88-31