


MAP FILE M99-41A

FILED CMO  
RECEIVED  
SEP 18 1985

COUNTY SURVEYOR  
DOUGLAS COUNTY, ORE.  
CMO

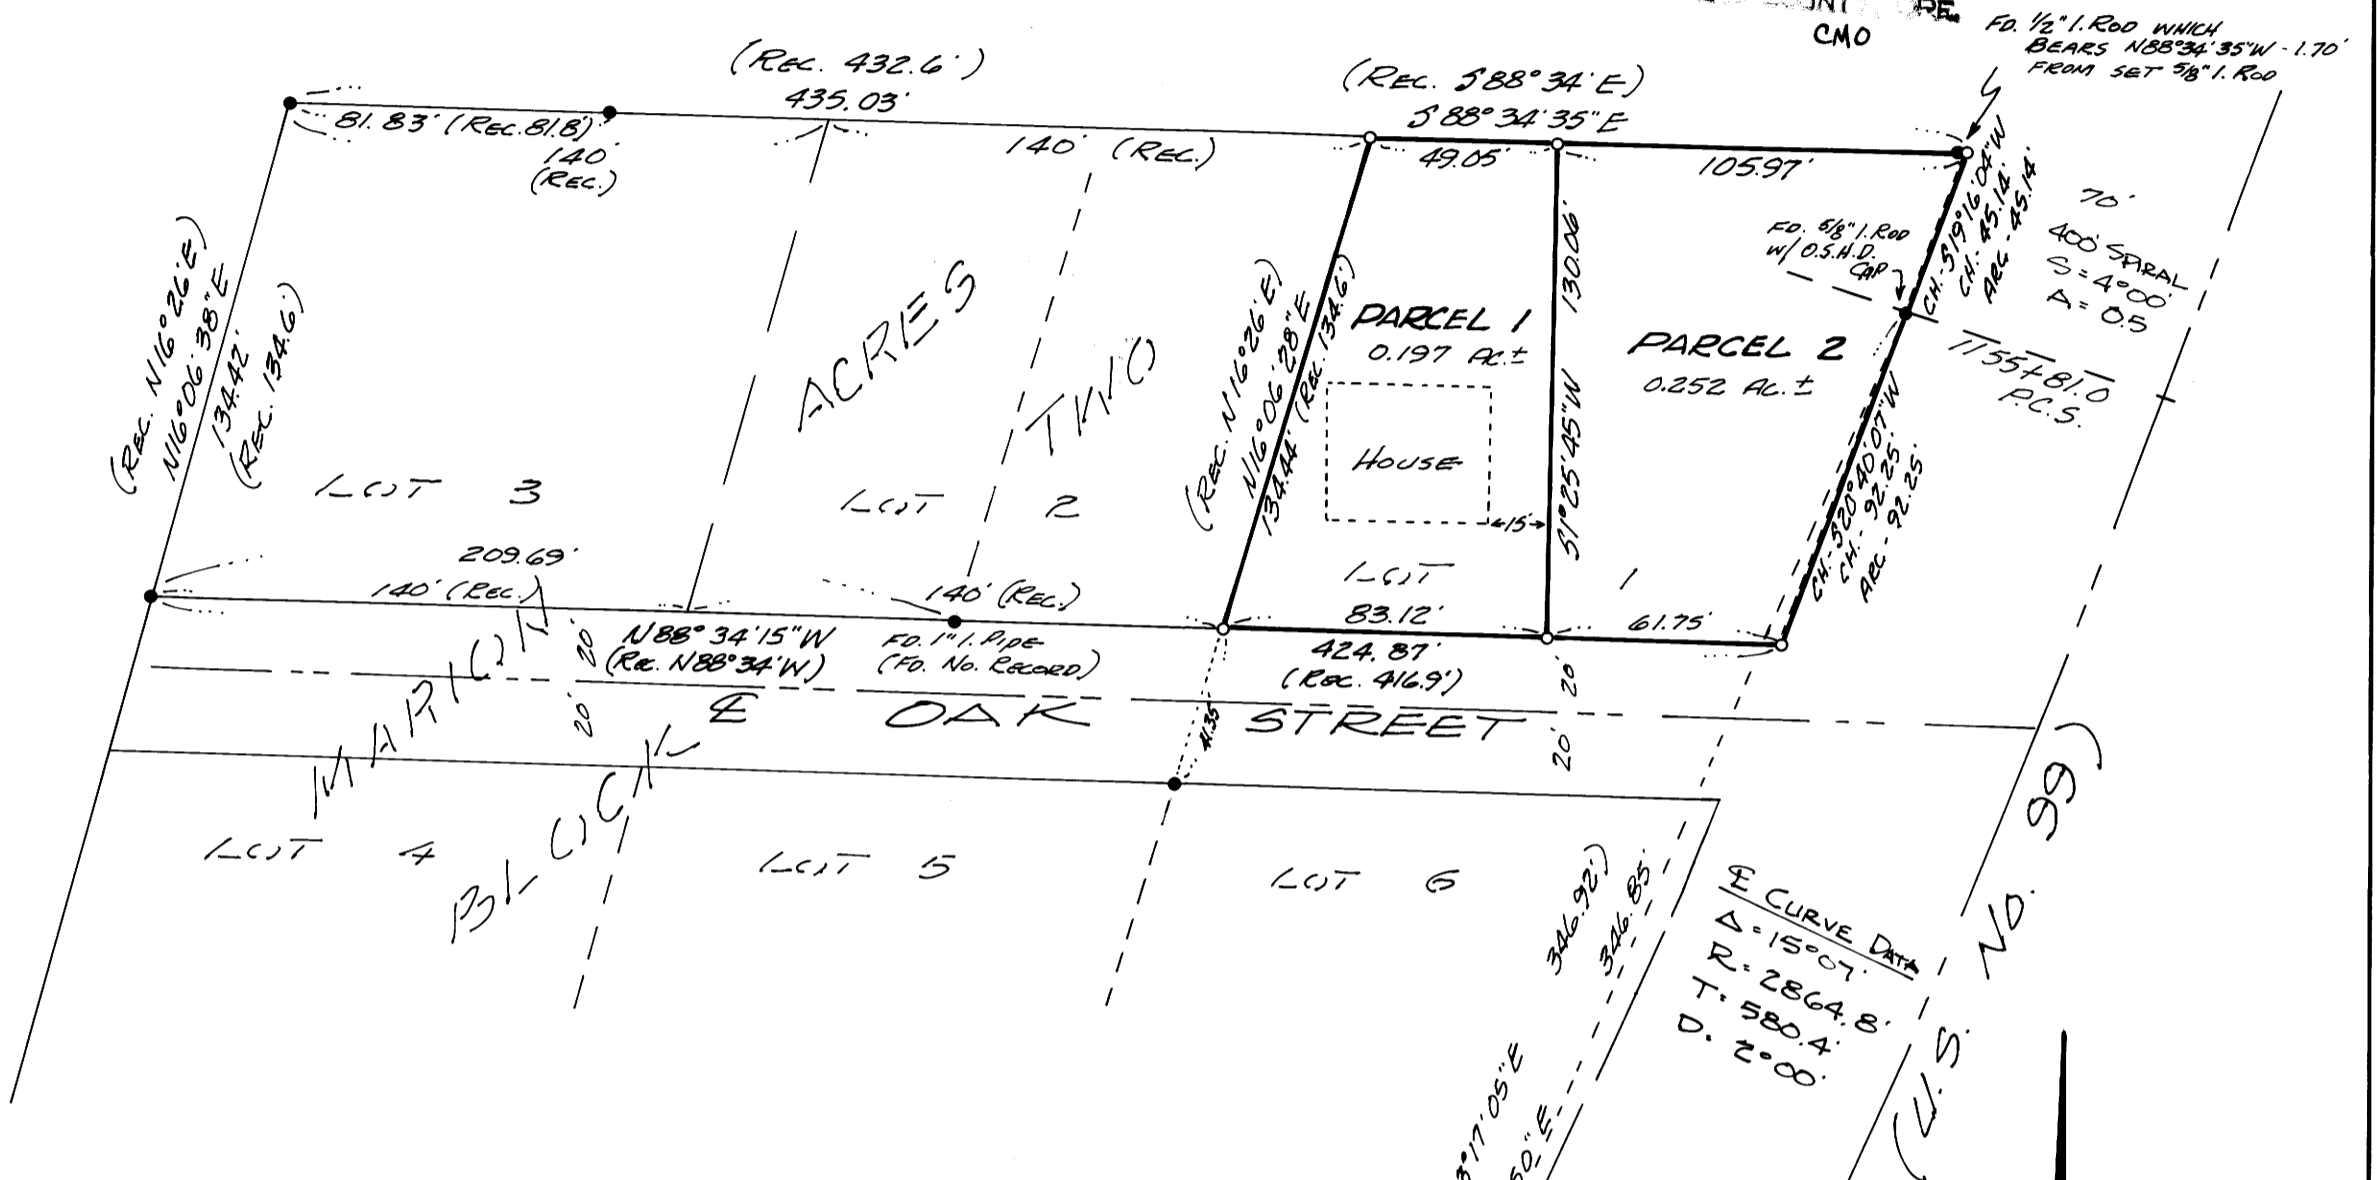

A MINOR LAND PARTITION IN THE S.W. 1/4 OF SECTION 21, T28S, R6W, W.M.

For: Casey & Pauline Gordon  
Star Rte. Box 607-F  
Winston, Oregon 97496  
Phone: 679-5617

By: Romey Ware  
2771 N.W. Garden Valley Rd.  
Roseburg, Oregon 97470  
Phone: 672-0649

Tax Lot No. 100  
Tax Acct. No. 65803.1  
Deed: Instrument No. 281619  
Sewer: City of Winston  
Water: Winston-Dillard Water District

- — Found 1" iron pipe unless noted otherwise.
- — Set 5/8" x 30" iron rod w/ cap stamped "R.E. Ware L.S. 1005"

Scale: 1" = 50'

Date: August 30, 1985

REGISTERED  
PROFESSIONAL  
AND SURVEYOR  
*Romey E. Ware*  
OREGON  
NOV 16 1973  
M-NSO E WARE  
1005