

**COUNTY SURVEYORS FILE DATA
DO NOT REMOVE FROM OFFICE**

SURVEY

for
WILLAMETTE INDUSTRIES, INC.
of the

West Line of Section 10 T21S, R4W W.M.
Douglas County, Oregon

Scale 1"=1000'


JUNE 16, 1986

NARRATIVE

THE PURPOSE OF THIS SURVEY WAS TO ESTABLISH THE BOUNDARY ALONG THE WEST LINE OF SECTION 10.

THE NORTHWEST AND SOUTHWEST SECTION CORNERS WERE USED FOR CONTROL. THE WEST QUARTER CORNER OF SECTION 10 WAS SEARCHED FOR BUT NO EVIDENCE WAS FOUND. ITS POSITION WAS REESTABLISHED BY SINGLE PROPORTION. BEARINGS WERE BASED UPON A SOLAR OBSERVATION BY THE HOUR ANGLE METHOD NEAR THE NORTHWEST SECTION CORNER JUNE 12, 1986.

A WILD T-16 THEODOLITE AND DIAL DISTANCE METER WERE USED TO MEASURE ANGLES AND DISTANCES. BEARING TREES WERE REFERENCED WITH A HAND COMPASS (DECLINATION SET AT 20° EAST) AND 50 FOOT TAPE. PROPERTY LINE WAS ESTABLISHED BY OFFSETTING FROM TRAVERSE POINTS TO TRUE LINE WITH A HAND COMPASS AND 50 FOOT TAPE.

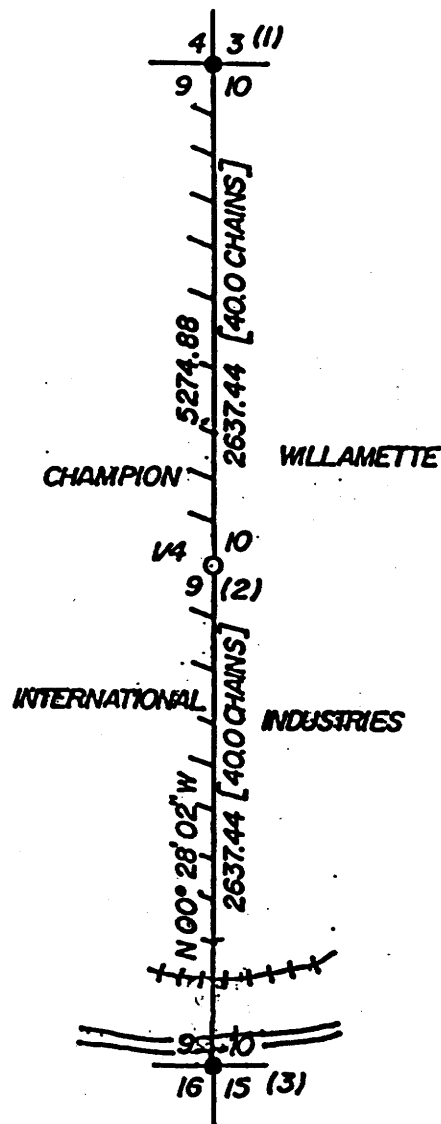

CORNER NOTES

(1) FOUND: 1969 DOUGLAS COUNTY BRASS CAP.

1969 BEARING TREES:
8" CHINQUAPIN S60°W 22.0 FT.- NOW AN 1.1" GREEN TREE, PARTIALLY HEALED FACE, SOME SCRIBES VISIBLE.
8" CHINQUAPIN N54°W 30.4 FT.- NOW AN 11" GREEN TREE, PARTIALLY HEALED FACE, SCRIBES VISIBLE.
8" DOUGLAS FIR N84°E 37.2 FT.- NOW AN 18" GREEN TREE, HEALED FACE, DOUGLAS COUNTY BEARING TREE TAGS ON ALL 1969 BEARING TREES.

ORIGINAL BEARING TREES:
8" CEDAR N68°W 2.0 FT.- NOW 3 1/2 FT. TALL STUMP "BT" SCRIBE VISIBLE.
10" DOUGLAS FIR S12°W 24.4 FT.- NOW HALF OF A 60" SNAG 25 FT. TALL, WITH A WEYERHAEUSER BEARING TREE TAG, NO MARKS VISIBLE.
ALSO FOUND: WEST 24.6 FT. HALF OF A 30" INCENSE CEDAR, 7 FT. TALL, CRUISER MARKS AND WEYERHAEUSER BEARING TREE TAG.

(2) SET BY PROPORTION, ORIGINAL NOT FOUND.

SET: 5/8" X 30" IRON ROD 26" IN GROUND WITH 1 1/4" PLASTIC CAP. STAMPED, "WILLAMETTE INDUSTRIES, INC."
BEARING TREES:
6" DOUGLAS FIR N84°W 10.5 FT. TO FACE MKD. 1/4S9BT.
12" DOUGLAS FIR S66°E 15.9 FT. TO FACE MKD 1/4S10BT.
PAINTED FACES ORANGE. PLACED WILLAMETTE IND. YELLOW BEARING TREE TAGS ON BOTH TREES. SET WHITE FIBERGLASS POST 1.0 FT. SOUTH OF CORNER.

(3) FOUND: 1981 DOUGLAS COUNTY BRASS CAP.

1981 BEARING TREES:
14" MAPLE N73 1/2°E 305.5 FT.- SCRIBES VISIBLE.
21" FIR S60°E 288.3 FT.- SCRIBES VISIBLE.
8" FIR S06°W 275.0 FT.- SCRIBES VISIBLE.
14" FIR S81°W 398.8 FT.- SCRIBES VISIBLE.
DOUGLAS COUNTY YELLOW BEARING TREE TAGS ON ALL TREES.


FILED TF

JUL 10 1986 TF

COUNTY SURVEYOR
DOUGLAS COUNTY, ORE. TF

LEGEND

- ||||| = PROPERTY BOUNDARY WITH BLAZES, BLUE RIBBON
- = MONUMENT FOUND
- = MONUMENT SET
- [] = RECORD DATA FROM ORIGINAL SURVEY OF 1855.
- ++++ = SOUTHERN PACIFIC RAILROAD
- ==== = INTERSTATE 5

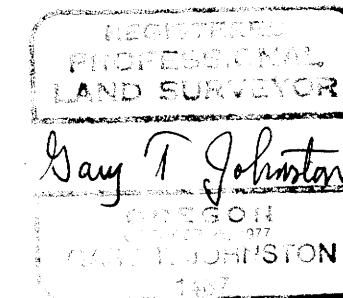

GARY T. JOHNSTON
WILLAMETTE INDUSTRIES, INC.
P.O. BOX 488
DALLAS, OREGON 97338

MAP FILE M102-14

MAP FILE M102-14