

COUNTY SURVEYORS FILE DATA  
DO NOT REMOVE FROM OFFICE

# A SURVEY FOR BILL STILES IN SE 1/4 SEC. 19 & NE 1/4 SEC. 30, T26S, R5W, W.M. DOUGLAS COUNTY, OREGON

FILED

*dh*

FEB 4 1987 TF

COUNTY SURVEYOR  
DOUGLAS COUNTY, ORE. TF


NARRATIVE: SURVEY TO WRITE  
LEGAL DESCRIPTION  
FOR WATER RIGHTS  
AND MARK THE LINE  
BETWEEN LOTS 9 & 10.  
OAK KNOLLS ESTATES  
SUBD.

FIELD CREW: JIM ARTMAN  
BOB BROWNING

EQUIP: WILD T1 + RED I DISTANCE METER

COMPS: GREG LANG

DRAFTING: DON STULL

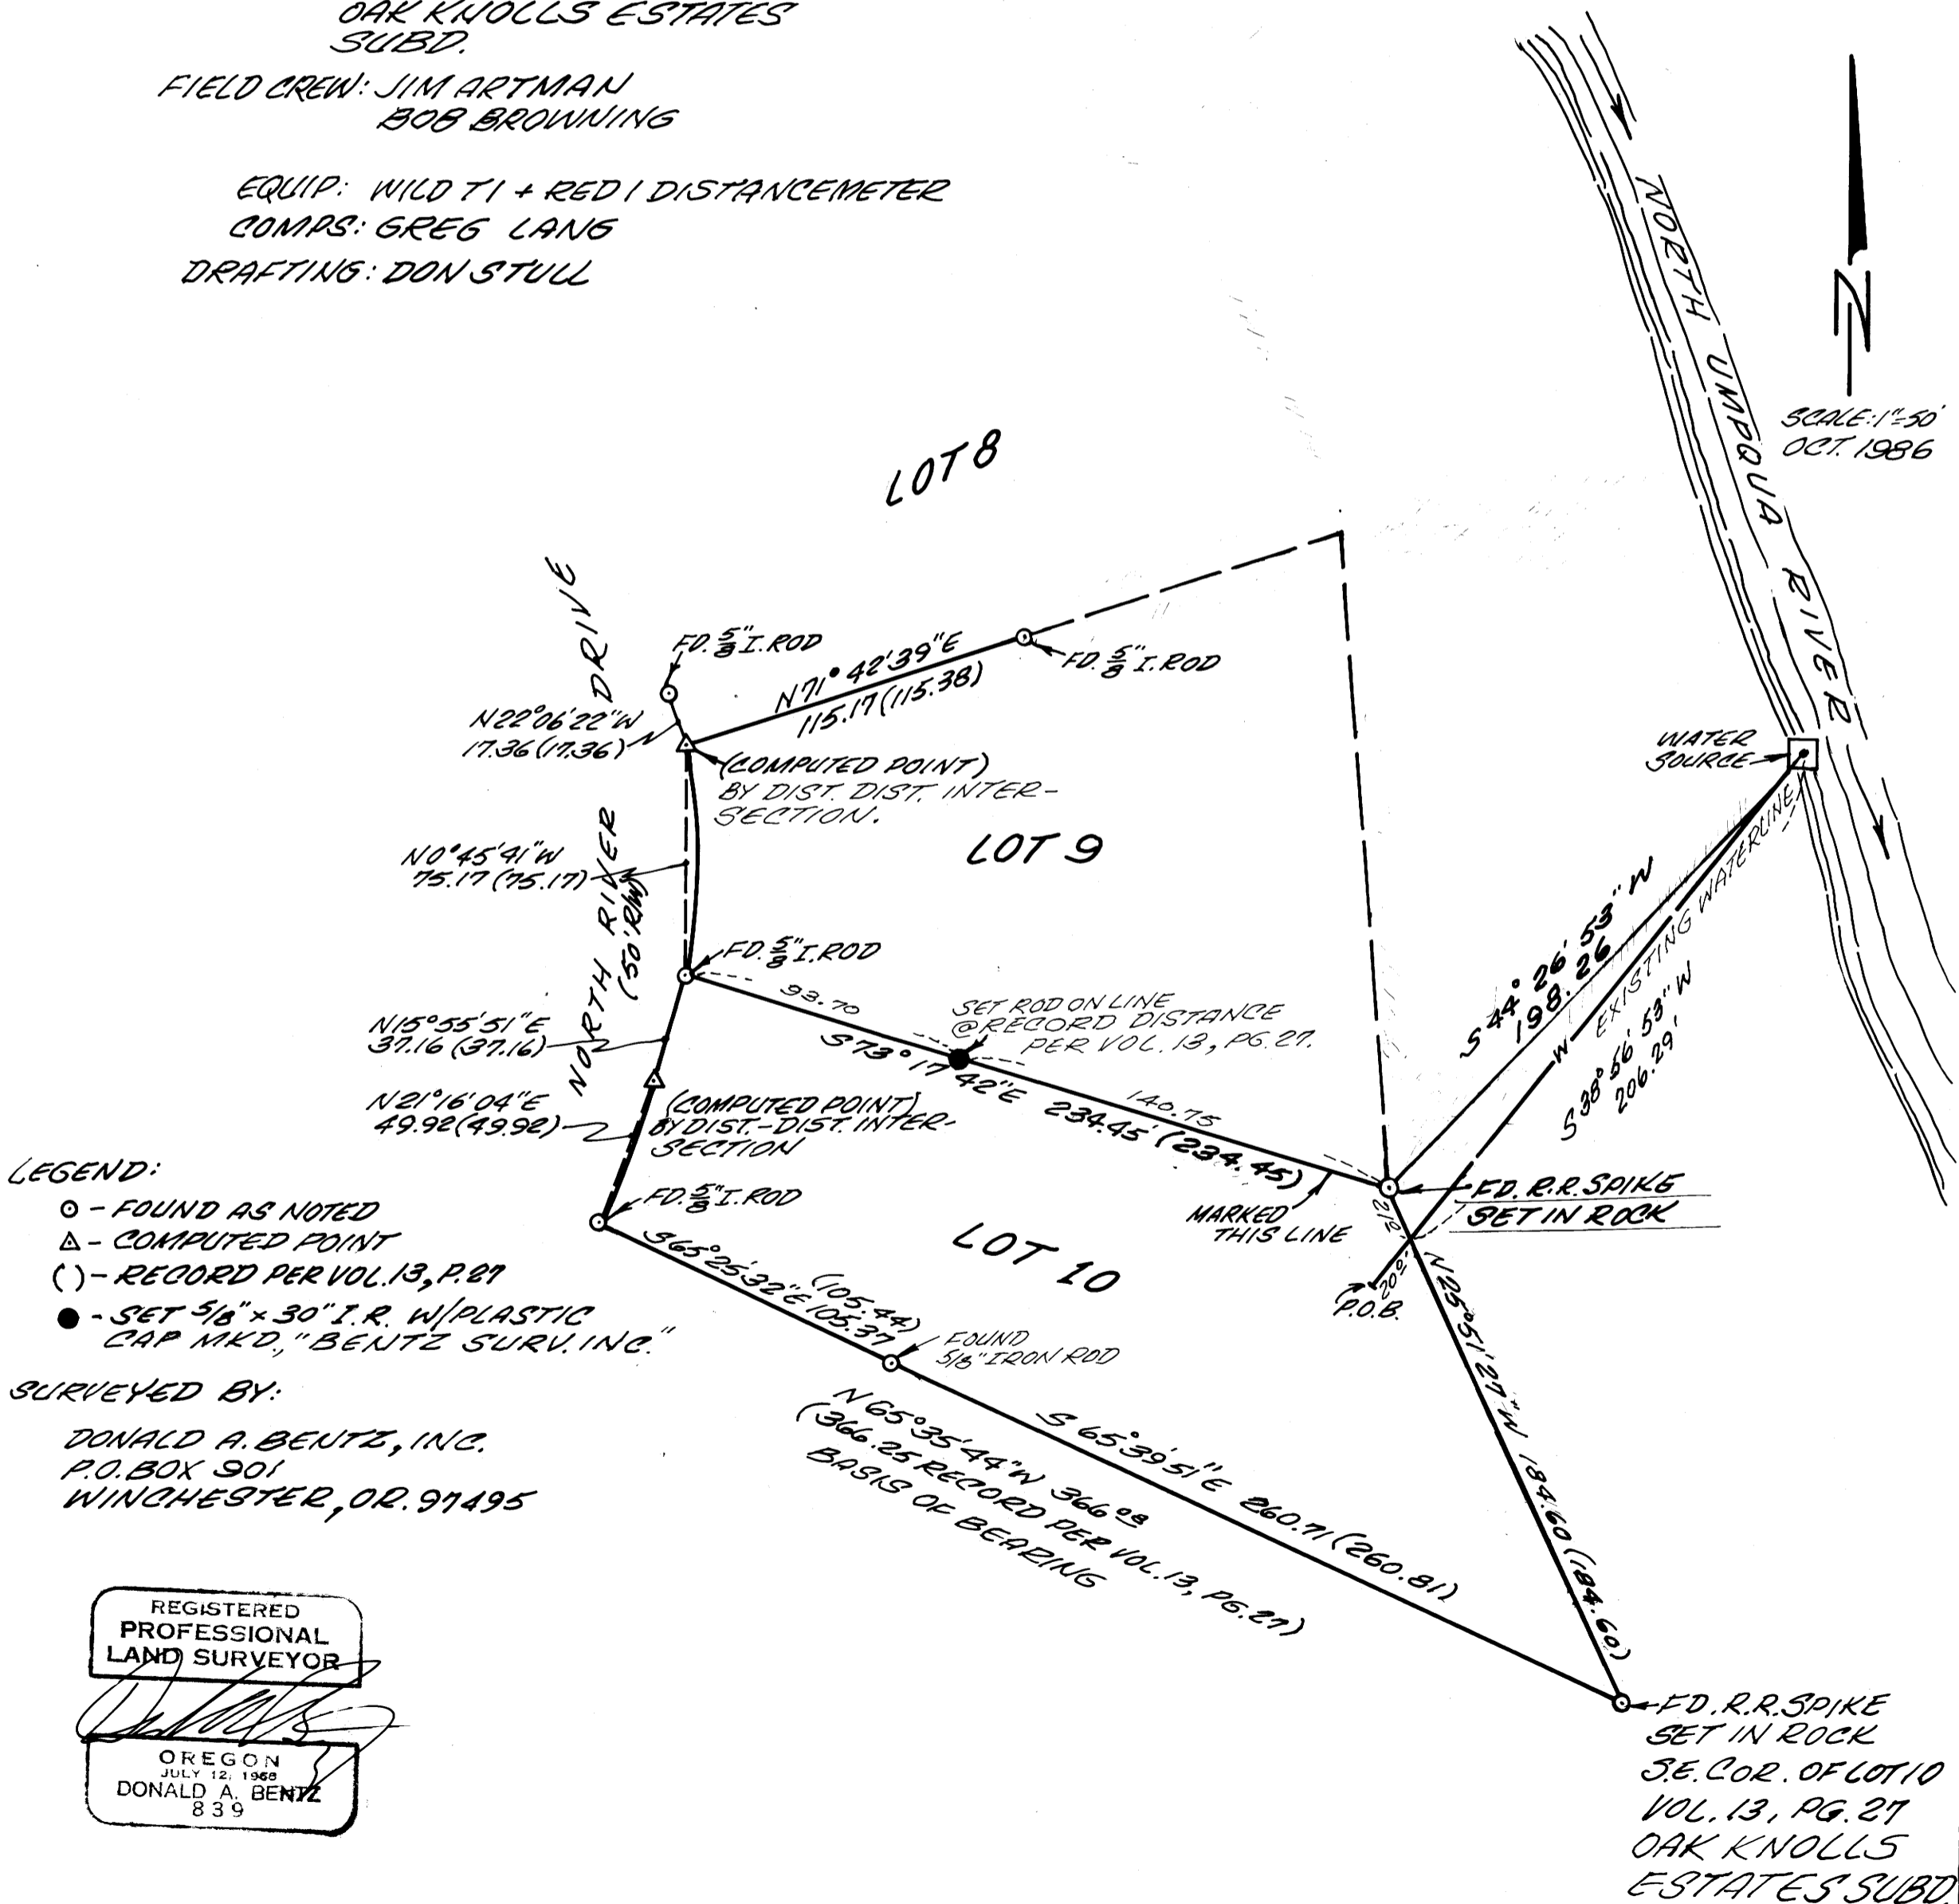

LEGEND:

- $\circ$  - FOUND AS NOTED
- $\Delta$  - COMPUTED POINT
- ( ) - RECORD PER VOL. 13, P. 27
- $\bullet$  - SET  $\frac{5}{8} \times 30$  I.R. W/PLASTIC CAP MKD, "BENTZ SURV. INC."

SURVEYED BY:

DONALD A. BENTZ, INC.  
P.O. BOX 901  
WINCHESTER, OR. 971495

REGISTERED  
PROFESSIONAL  
LAND SURVEYOR

OREGON  
JULY 12, 1968  
DONALD A. BENTZ  
839