


FILED

FEB 13 1987 TF

COUNTY SURVEYOR
DOUGLAS COUNTY, OREGON TF

U.S. FILE
Map File M103-36

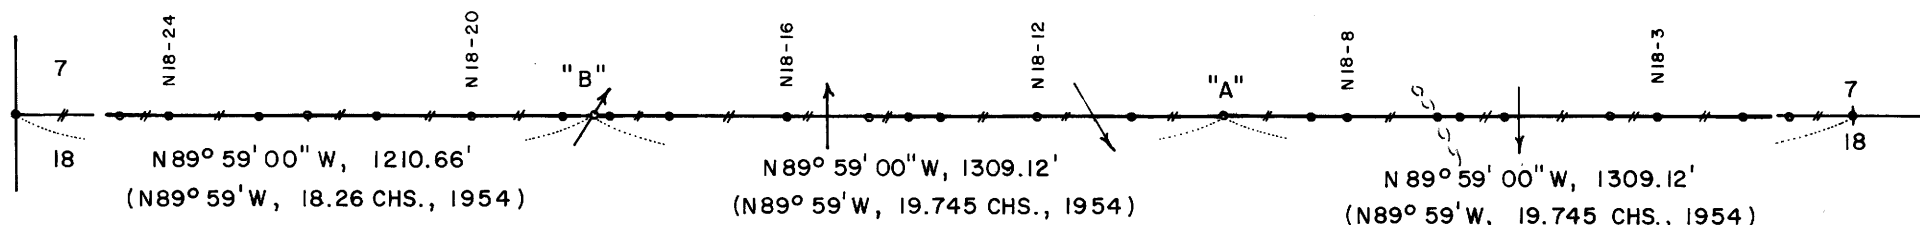

SURVEY OF
SECTION 18, T20S, R8W, W.M.
DOUGLAS COUNTY, OREGON
FOR
INTERNATIONAL PAPER COMPANY
BY

ROBERTS SURVEYING INC.
29 WEST 29TH STREET
EUGENE, OREGON 97405
DECEMBER 30, 1986

N.W. CORNER SECTION 18

FD. 1954 G.L.O. BRASS CAP LYING HORIZONTALLY UNDER
20" CEDAR WINDFALL. RESET BRASS CAP FROM B.T.'S
AND BURIED PURPLE MAGNETIC MARKER UNDER 36" PIPE.
34" HEMLOCK, N84°E, 32.3' (SCAR VIS.), 1954 B.T.
48" HEMLOCK, S39½°E, 72.6' (SCAR VIS.), 1967 B.T.

"A" N.E. CORNER LOT 2

SET 1 1/4" x 36" IRON PIPE AND BRASS CAP
(BURIED PURPLE M.M. UNDER 36" PIPE)
22" MAPLE, N49°W, 36.3' (SCRIBED/PAINTED RED)
24" MAPLE, S40°W, 11.0' (SCRIBED/PAINTED RED)

NORTH 1/4 CORNER SECTION 18

FD. 1954 G.L.O. BRASS CAP.
18" HEMLOCK, N15°E, 20.1' (SCAR VIS.), 1954 B.T.
24" HEMLOCK, S61°E, 25.4' (SCAR VIS.), 1954 B.T.

"B" N.W. CORNER LOT 2

SET 1 1/4" x 36" IRON PIPE AND BRASS CAP FOR
WITNESS CORNER TO N.W. CORNER LOT 2.
(TRUE LOT CORNER BEARS N89°59'00"W, 40.00')
(BURIED PURPLE M.M. UNDER 36" PIPE)
7" HEMLOCK, S46°W, 20.8' (SCRIBED/PAINTED RED)
11" ALDER, N34°W, 7.4' (SCRIBED/PAINTED RED)



NARRATIVE

THE PURPOSE OF THIS SURVEY IS TO POST AND BLAZE THE WEST 1/2 OF THE NORTH LINE OF SECTION 18. A CLOSED MEANDER TRANSIT AND E.D.M. TRAVERSE WAS RUN BETWEEN THE NORTH 1/4 CORNER AND THE N.W. CORNER OF SECTION 18 AND USED FOR CONTROL. LOT CORNERS "A" AND "B" WERE SET BY SINGLE PROPORTIONATE MEASURE AS SHOWN. A CLOSED MEANDER TRANSIT AND E.D.M. TRAVERSE WAS RUN ALONG ALL BLAZED AND POSTED PROPERTY LINES. OFFSETS WERE COMPUTED FROM THIS MEANDER TRAVERSE TO THE TRUE PROPERTY LINE. PROPERTY LINES WERE MARKED WITH RED PAINTED BLAZES, RED RIBBON, YELLOW INTERNATIONAL PAPER COMPANY PROPERTY LINE SIGNS, FLUORESCENT ORANGE MAGNETIC MARKERS AND 1/2" x 60" IRON REBAR WITH ALUMINUM CAPS, LOCATED AS SHOWN. IRON REBAR AND BURIED MAGNETIC MARKERS ARE REFERENCED BY A 4" x 6" ALUMINUM INTERNATIONAL PAPER BOUNDARY LINE TAG NAILED TO A NEARBY TREE. TAG NOTES BEARING AND DISTANCE FROM TREE TO IRON ROD OR MAGNETIC MARKER.

LEGEND

- CORNERS FOUND AND USED FOR CONTROL.
- o CORNERS SET, 1 1/4" x 36" IRON PIPES AND BRASS CAPS. CAPS STAMPED S-T-R, DATE AND P.L.S. NO. 1039.
- LINES MARKED AND BLAZED THIS SURVEY.
- () DATA OF RECORD, 1884 G.L.O. SURVEY AND 1954 B.L.M. SURVEY.
- (M.M.) INDICATES LOCATION OF BURIED MAGNETIC MARKERS. MARKERS ARE FLUORESCENT ORANGE IN COLOR AND ARE BURIED, 12" TO 18" DEEP, ALONG LINE AS SHOWN.
- DISTANCE TO B.T.'S ARE CENTER MEASURE.
- ALL NEW B.T.'S ARE SCRIBED AND HAVE A BRASS WASHER STAMPED "P.L.S." NAILED TO LOWER BLAZE. SCRIBED BLAZES ARE PAINTED RED.
- ALL NEW B.T.'S HAVE A 6" STEEL SPIKE DRIVEN INTO THE CENTER OF THE TREE TO SERVE AS A CHAINING POINT FOR MEASURED DISTANCES.
- SCALE 1" = 400'

LOCATION	OF	MAGNETIC	MARKERS
N. 1/4 COR.	0'	WEST	(FC. POST)
N18-1	129'	WEST	(M.M.)
N18-2	225'	WEST	(M.M. & REBAR)
N18-3	405'	WEST	(M.M.)
N18-4	502'	WEST	(M.M. & REBAR)
N18-5	724'	WEST	(M.M.)
N18-6	821'	WEST	(M.M.)
N18-7	856'	WEST	(M.M. & REBAR)
N18-8	1051'	WEST	(M.M.)
N18-9	1126'	WEST	(M.M. & REBAR)
LOT COR.	1309'	WEST	(M.M. & FC. POST)
N18-11	1497'	WEST	(M.M. & REBAR)
N18-12	1698'	WEST	(M.M.)
N18-13	1895'	WEST	(M.M. & REBAR)
N18-14	1965'	WEST	(M.M.)
N18-15	2044'	WEST	(M.M. & REBAR)
N18-16	2218'	WEST	(M.M.)
N18-17	2460'	WEST	(M.M. & REBAR)
N18-18	2580'	WEST	(M.M. & REBAR)
LOT COR.	2618'	WEST	(FC. POST)
N18-19	2684'	WEST	(M.M.)
N18-20	2877'	WEST	(M.M. & REBAR)
N18-21	3075'	WEST	(M.M.)
N18-22	3221'	WEST	(M.M. & REBAR)
N18-23	3316'	WEST	(M.M.)
N18-24	3504'	WEST	(M.M. & REBAR)
N18-25	3601'	WEST	(M.M.)
N.W. COR.	3829'	WEST	(M.M. & FC. POST)

REGISTERED
PROFESSIONAL
LAND SURVEYOR

Les Roberts

OREGON
L. D. ROBERTS
1039

DO NOT REMOVE FROM OFFICE

U.S. FILE
Map File M103-36