

PROPERTY SURVEY

COUNTY SURVEYORS FILE DATA
DO NOT REMOVE FROM OFFICE

A PORTION OF THE S.W. 1/4 OF THE S.W. 1/4 AND THE SE. 1/4 OF THE S.W. 1/4 OF SECTION 34
TOWNSHIP 21 SOUTH • RANGE 12 W.W.M. • DOUGLAS COUNTY • OREGON

FILED

28
MAR 6 1987 TF



COUNTY SURVEYOR
DOUGLAS COUNTY, ORE
TF

FOR -
REEDSPORT ASSEMBLY OF GOD
509 NORTH 19TH STREET
REEDSPORT, OREGON
503-271-3379 97467

PREPARED BY -
KOOS ENGINEERING
1810 MONROE
NORTH BEND, OREGON
503-756-4419 97459

LEGEND

- FOUND MONUMENT (AS NOTED)
- SET 5/8" x 30" IRON ROD W/CAP #1331
- (R) INDICATES INFORMATION OF RECORD
- (M) INDICATES INFORMATION MEASURED IN FIELD

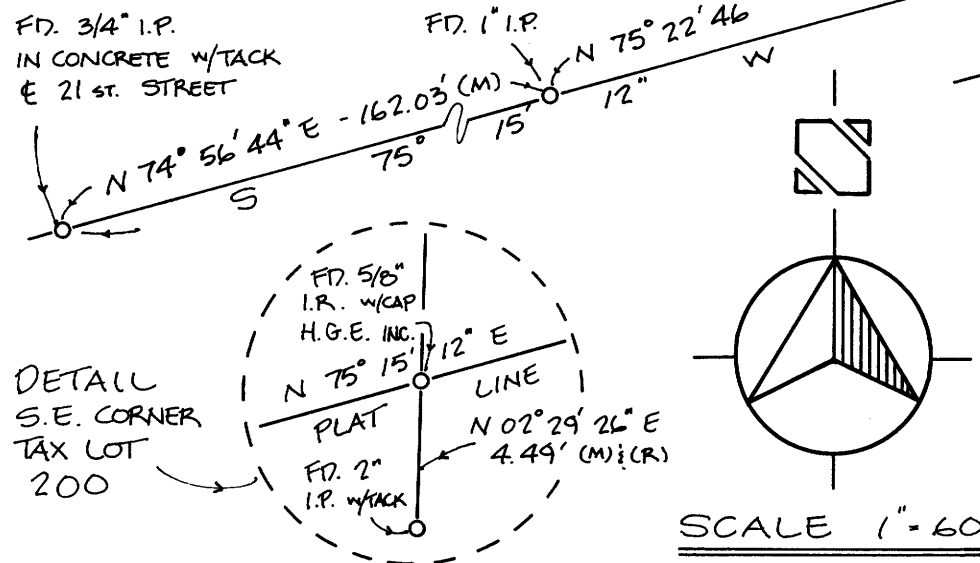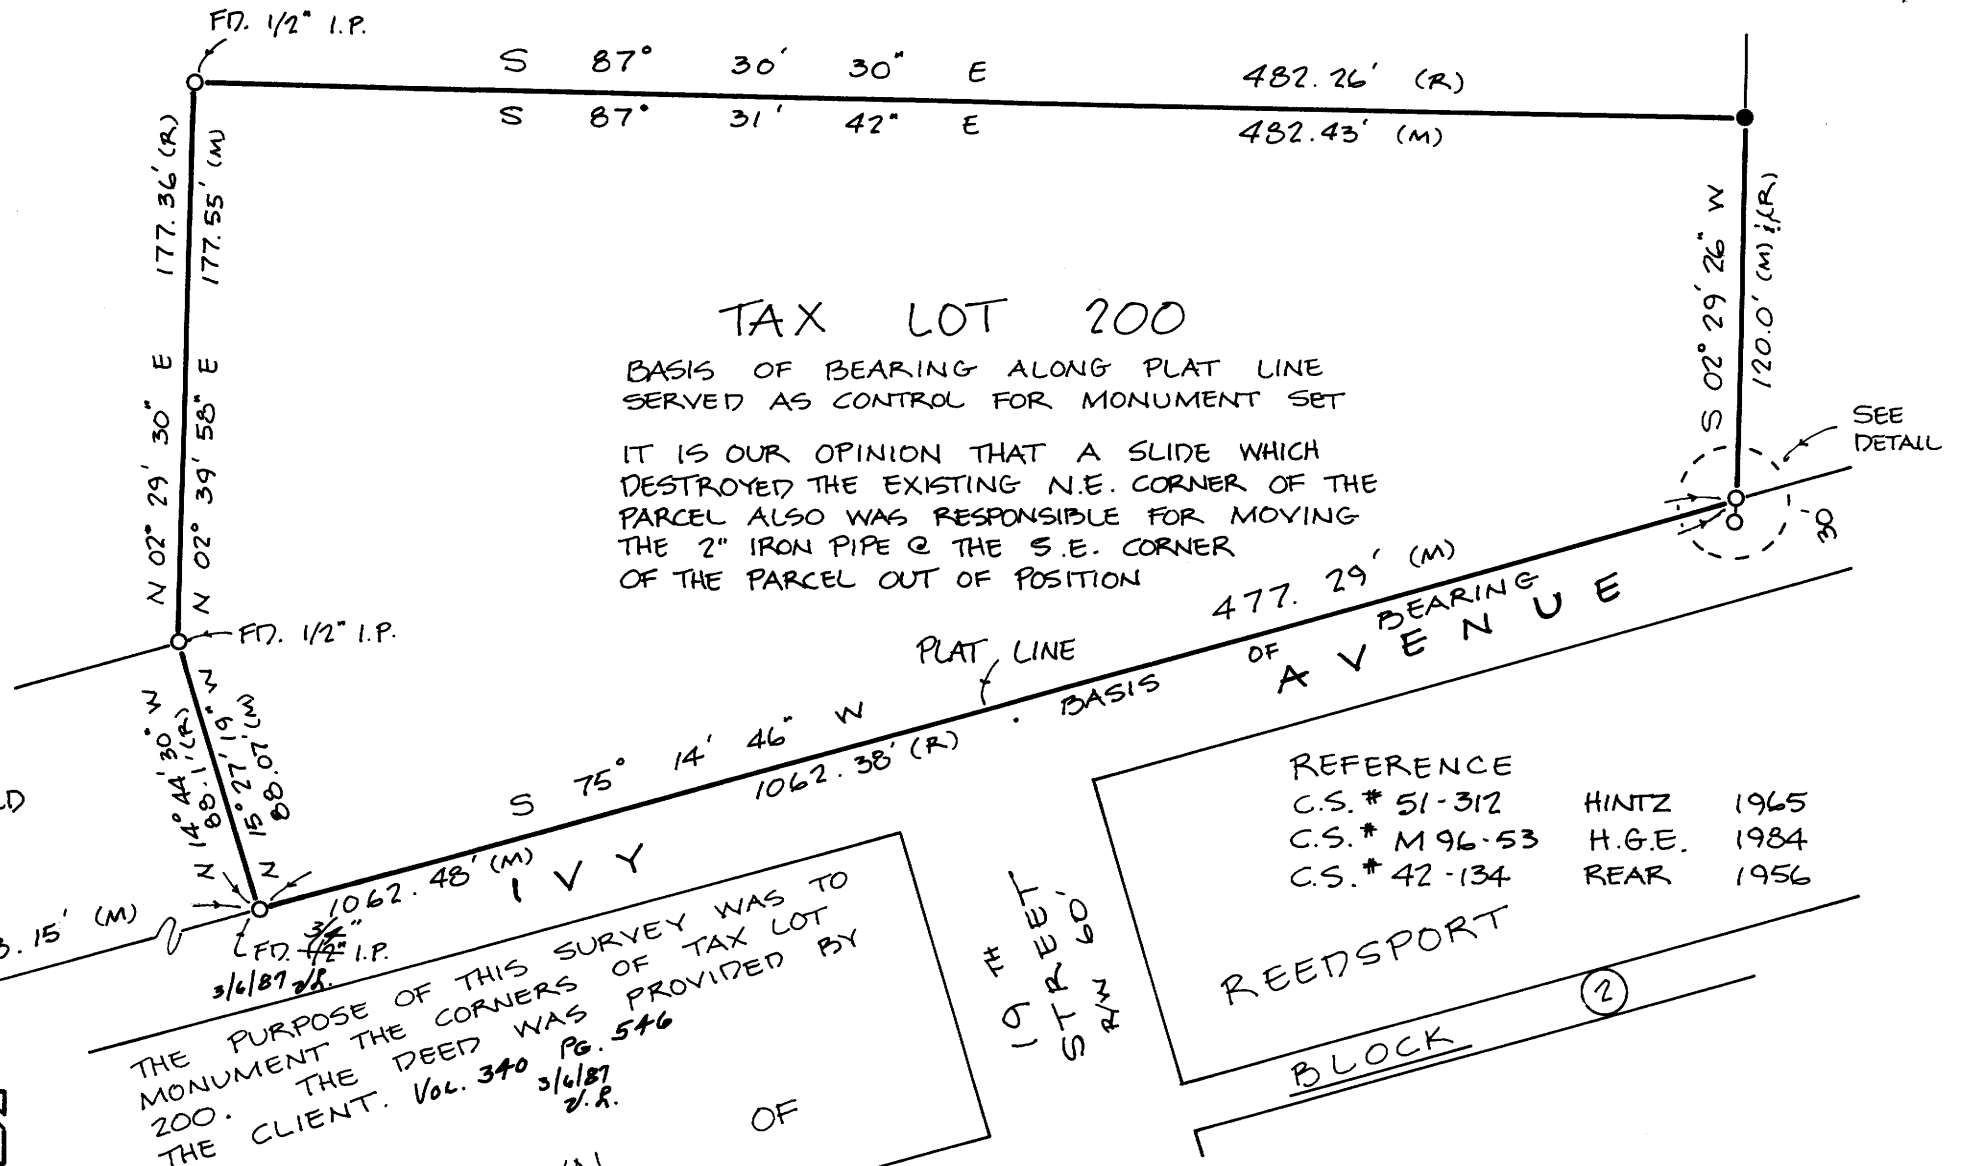

THE PURPOSE OF THIS SURVEY WAS TO MONUMENT THE CORNERS OF TAX LOT 200. THE DEED WAS PROVIDED BY THE CLIENT. Vol. 340 Pg. 546 3/6/87 Z.R.

KE
KOOS ENGINEERING
1810 MONROE
NORTH BEND, OREGON

	PROPERTY SURVEY FOR ASSEMBLY OF GOD REEDSPORT OREGON
	S.W. 1/4 OF SECTION 34 T. 21 S. R. 12 W.W.M. CITY OF REEDSPORT DOUGLAS COUNTY, OREGON
	FEBRUARY 24, 1987

MAP FILE M/103-76

MAP FILE M/103-76