


Wire Fenceline Position

Dist. along Prop. Line from S.W. Cor.	Fence Location
521.0'	fence intersects prop. line
643.3'	10.6' East
792.4'	8.0' East
909.1'	17.3' East
1,060.5'	19.4' East
1,121.4'	17.3' East
1,156.9'	15.4' East
1,298.0'	fence intersects prop. line

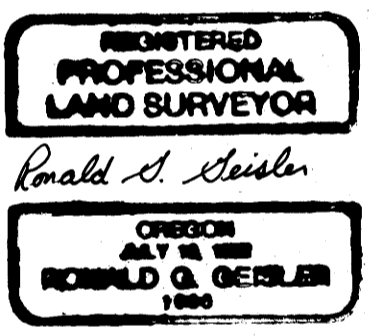


① 1/4 CORNER S1/S6
 Found a 1958 C.S. BCIP, also stamped "U.S. B.L.M. 1962", and the following accessories:
 2' tall rotted fir snag bears S83°E, 5.3'. No marks visible. (original)
 25" fir bears N37°W, 7.3'. Opened face. (original)
 26" fir bears N33°W, 17.0'. Closed face. (1958)
 20" fir bears S55-3/4°E, 16.0'. Closed face. (1958)
 22" fir bears S71°E, 61.4'. Closed face. (1962)
 41" fir bears S12°W, 87.1'. Closed face. (1962)

⑤ W1/16 CORNER S6/S7
 Found a 1962 1" x 1" "T" iron, and the following accessories:
 19" fir stump bears S08°W, 12.0' (1962)
 18" fir stump bears S40°W, 27.0' (1962)
 Bark scribing visible on both BT's. Each BT has a 1" washer marked, "Wilford N. Haines, 239, Drain, Or."

LEGEND

- ◊ Corner found and used for control
- ==== Property line posted
- ***** Wire fence
- □ 1855 G.L.O. record course
- () 1962 record course by Haines (M24-30)
- (()) 1962 B.L.M. record course

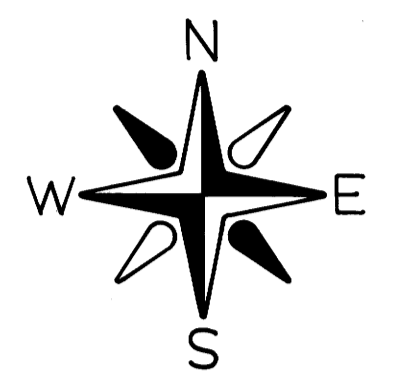

SCALE: 1" = 200'

NOTES

- 1) C.S. BCIP refers to a 2-1/2" brass cap set on a 1" iron pipe by the Douglas County Surveyor's Office.
- 2) All bearings to corner accessories were taken with a hand compass. Mean magnetic variation = 19°45'E.
- 3) Distances to bearing trees are measured to the side and center of the tree, one foot above the root crown.

SURVEY NARRATIVE

This survey was conducted to post property lines for Champion International Corporation in the SW 1/4 SW 1/4 of Sec. 6, T21S, R5W, W.M. Basis of bearing was obtained from a 1962 B.L.M. dependent resurvey between the S.W. section corner and the S1/16 corner S1/S6 (N00°46'W).

The west boundary of T21S, R5W was originally surveyed by Gordon and Gardner, in 1855. Sec. 6 was subdivided by William Wright in 1884. Wilford Haines renewed the S.W. section corner in 1957, based on original evidence found. In 1959, Byron reset a Douglas County BCIP at the S.W. section corner, which had been incorrectly set the previous year. The W1/4 corner of Sec. 6 was renewed by Douglas County, in 1958, based on original evidence found. In 1962, the B.L.M. surveyed the West boundary of Sec. 6 and established the S1/16 corner S1/S6. Wilford Haines subdivided section 6, in 1962 (see M24-30 at the Douglas County Surveyor's Office).

Lines were run between found corners. The W1/4 corner was tied to verify the position of the S1/16 corner. All traverses were closed loops with a minimum error of closure of one part in 17,000. The survey was run with a Topcon GTS-2. Property lines were blazed, flagged and posted with 5' steel fence posts with attached "Champion" tags. A wire fence was found to be within property line. Ties were made to the fence, and are listed on this map.

Ronald G. Geisler, Oregon PLS 1988
 Champion International Corporation
 P.O. Box 1328
 Roseburg, Oregon 97470

② S1/16 CORNER S1/S6
 Found a 1962 B.L.M. 3-1/2" brass cap set on a 2-1/2" iron pipe, and the following accessories:
 13" fir bears S27°E, 7.3'. Closed face. (1962)
 20" fir bears S26°W, 24.4'. Closed face. (1962)
 Also found a 1" water pipe lying horizontally on a decaying log, N50°W, 15' from the corner.

③ SW 1/16 CORNER S6
 Found a 1962 1" x 1" "T" iron, and the following accessories:
 13" fir bears S29°E, 9.9'. Closed face. (1962)
 9" fir snag bears N64°W, 22.5'. Closed face. (1962)
 Set: 10" hemlock bears N25°W, 10.3'
 Scribed: SW 1/16 S6 BT

④ SECTION CORNER S1/S6/S7/S12
 Found a 1958 C.S. BCIP, reset by Byron in 1959, and stamped "U.S. B.L.M. 1962". Also found the following accessories:
 30" fir stump bears S86-1/2°E, 9.9' (rec. = 10.4')
 Scribing partially visible (1959)
 24" fir stump bears S47-3/4°E, 14.5' (rec. = 15.2')
 Closed face (1959)
 16" rotted fir stump bears S17°W, 20.5' (rec. = 21.5')
 Scribing partially visible (1959)
 48" fir stump bears S14°E, 52.1'. Closed face (1962)
 62" fir stump bears S45°W, 49.5' (rec. = 47.5')
 Closed face (1962)
 14" fir bears N18°W, 30.0' (rec. = 31.0')
 Closed face (1962)
 Also found a "T" iron with a 1" cap marked, "Wilford N. Haines, 239, Drain, Or." that bears N50°W, 0.51', and was set in 1957.

**SURVEY OF SW 1/4 SW 1/4
 SEC. 6, T21 S, R5W, W.M.
 DOUGLAS COUNTY, OREGON
 BY
 CHAMPION INTERNATIONAL CORPORATION
 MAY 1987
 R.G.G.**

COUNTY SURVEYORS FILE DATA
 DO NOT REMOVE FROM OFFICE!

FILED
 MAY 22 1987
 COUNTY SURVEYOR
 DOUGLAS COUNTY, ORE.
 TF

MAP FILE M104-14