

PROPERTY SURVEY IN THE N.W. 1/4, SECTION 15, T.29S., R.6W., W.M.
DOUGLAS COUNTY, OREGON

COUNTY SURVEYORS FILE DATA
DO NOT REMOVE FROM OFFICE

FILED

JUN 11 1987 TF

COUNTY SURVEYOR
DOUGLAS COUNTY, ORE. TF


FOR MICKEY BEACH

BY ROBERT L. DOLAN
RT. 1 BOX 1820
SUTHERLIN, OR. 97479

DATE JUNE 1987

SCALE 1" = 100'

- Legend
- FD. 5/8" IRON ROD OR AS NOTED
 - SET 5/8" x 30" IRON ROD W/CAP LS 1076
 - △ COMPUTED POINTS FROM RECORD BEARING AND DISTANCES

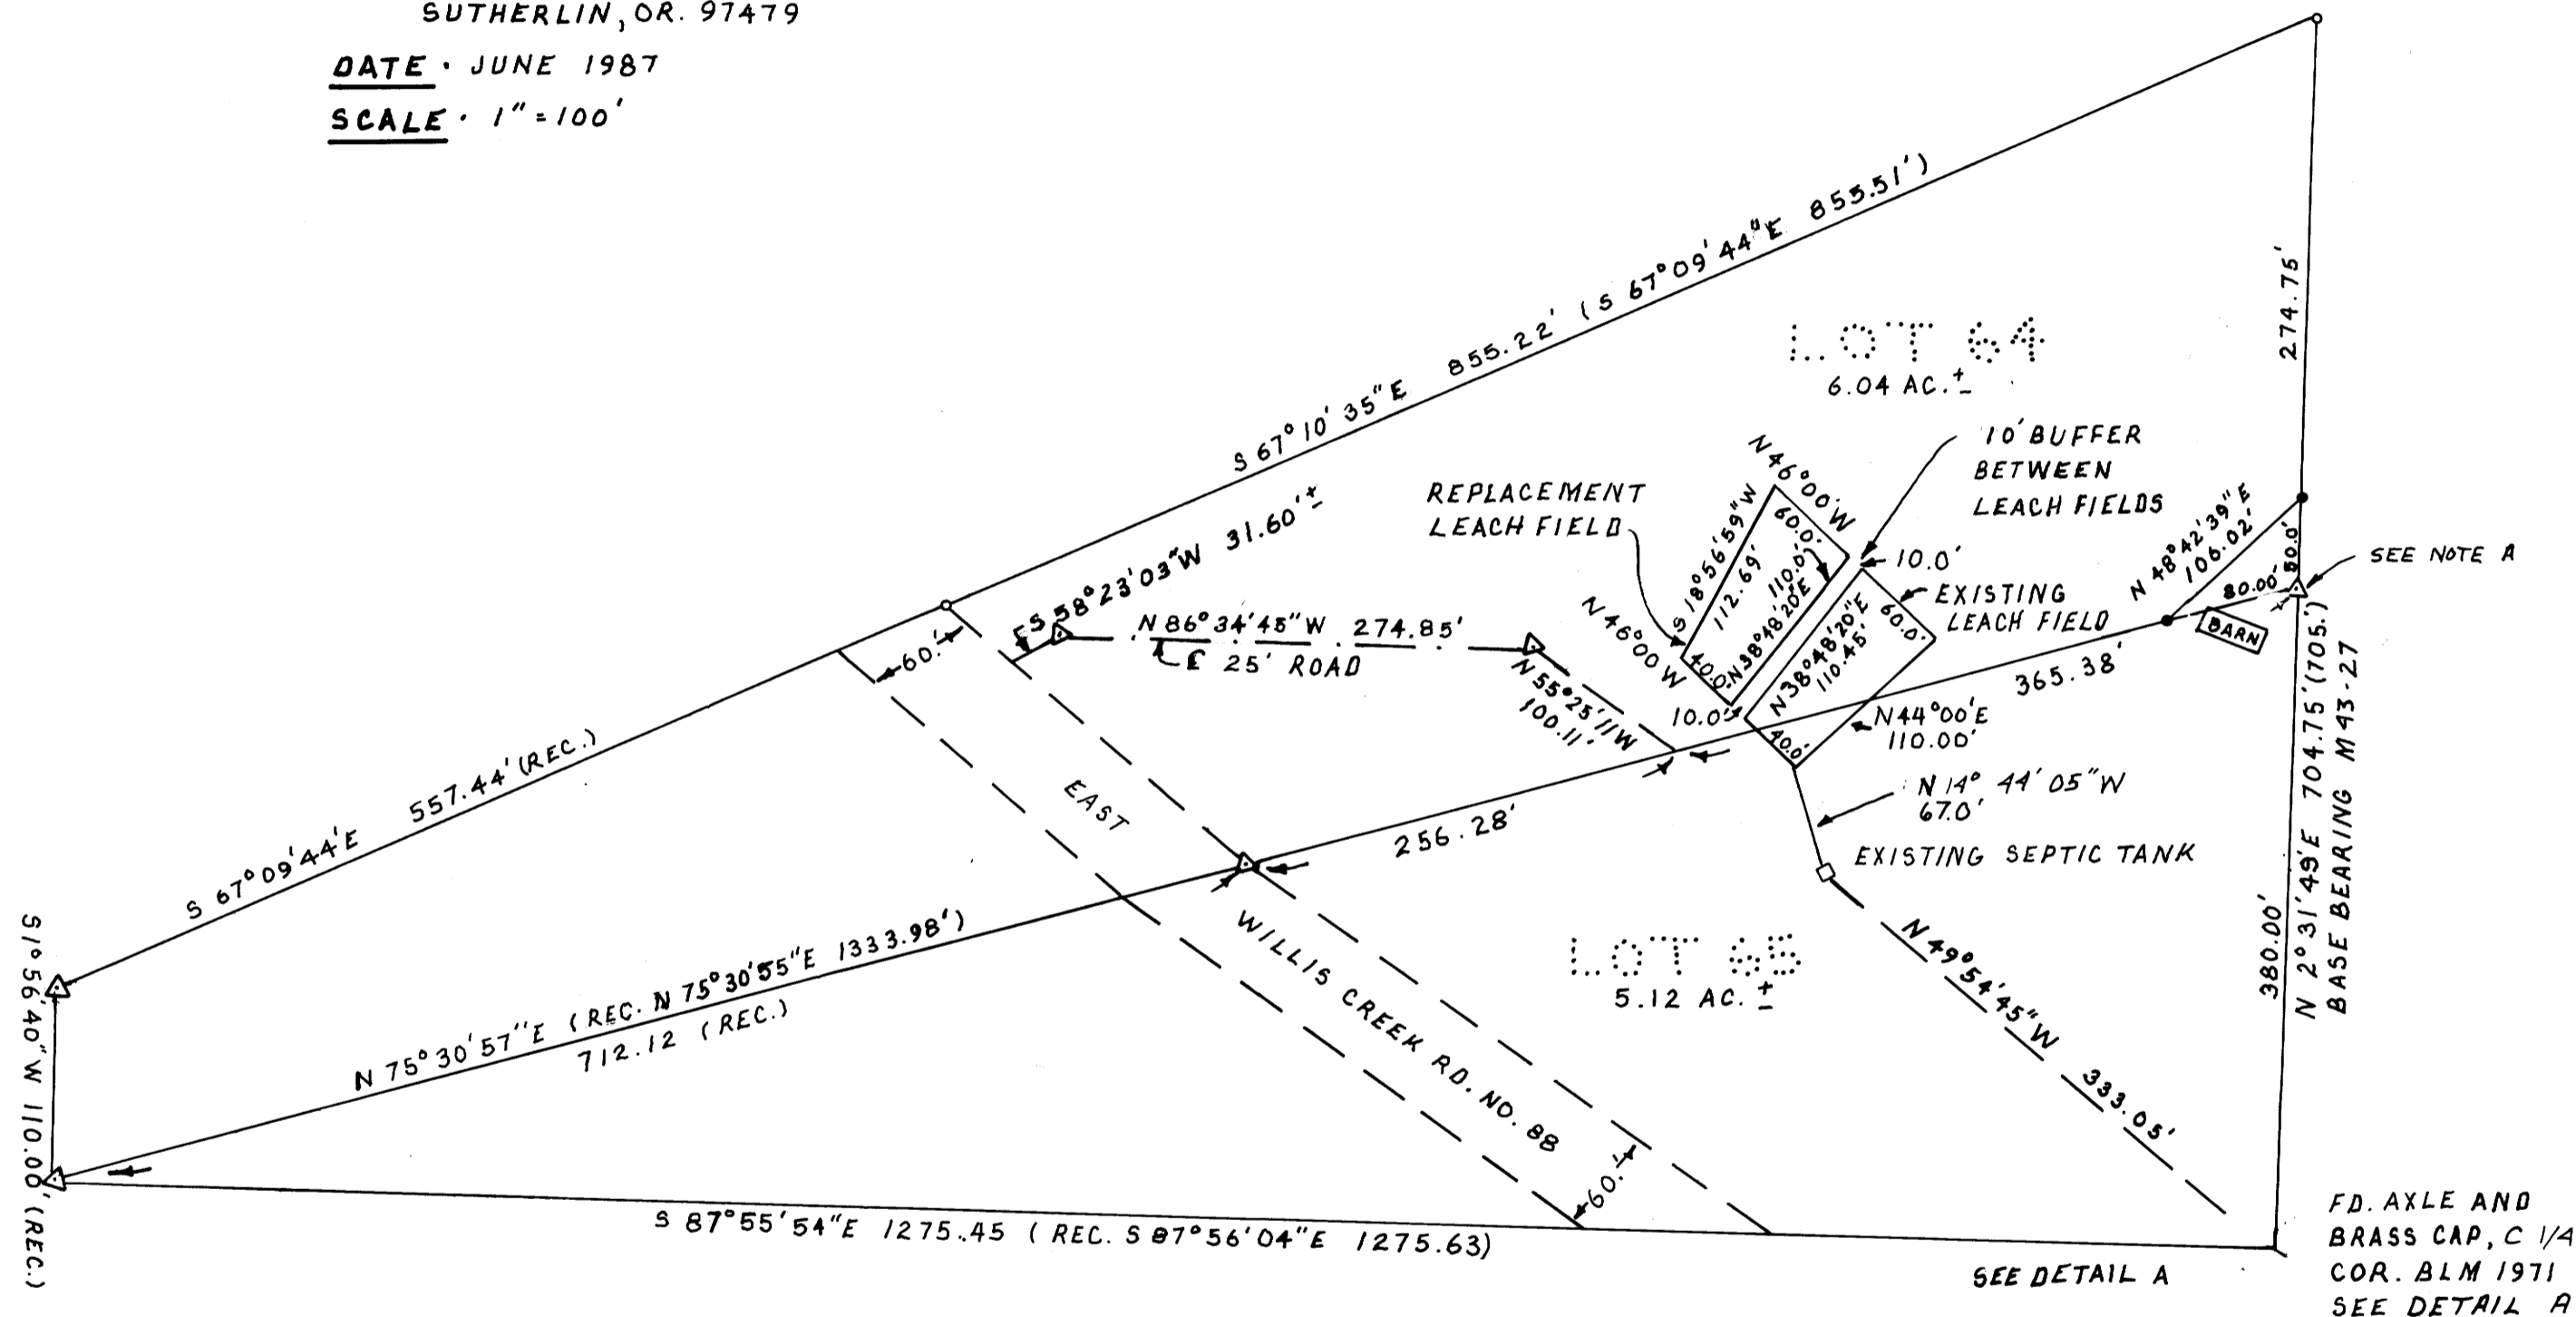


NARRATIVE

SURVEY TO MONUMENT PROPERTY CORNERS FOR LINE CHANGE AND FOR SEWER EFFLUENT LEACH-FIELD EASEMENT AND 25' ROAD EASEMENT DESCRIPTIONS

NOTE - ACREAGE DOES NOT INCLUDE COUNTY ROAD.

INSTRUMENTS - THEODOLITE DISTANCE - METER

NOTE A - FD. 5/8" IRON ROD - BEARS S 3° 45' W, 5.15 FT. FROM COMPUTED POINT

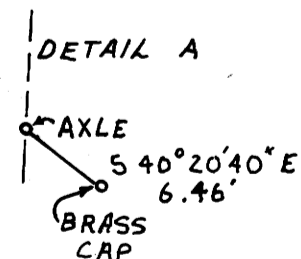

REGISTERED
PROFESSIONAL
LAND SURVEYOR
Robert P. Dolan
1979
ROBERT L. DOLAN
1979

MAP FILE M104-22

MAP FILE M104-22