

PRELIMINARY ADMINISTRATIVE SURVEY

FOR FOREST MANAGEMENT PURPOSES OF THE

MEDFORD DISTRICT

BUREAU OF LAND MANAGEMENT

T. 32 S., R. 8 W., SEC. 29, W. M.

DOUGLAS COUNTY


SURVEYED BY: Gordon L. Caster DATE: Sep. 1979

FILED

OCT 1 1987

COUNTY SURVEYOR
DOUGLAS COUNTY, ORE.

COUNTY SURVEYORS FILE DATA
DO NOT REMOVE FROM OFFICE

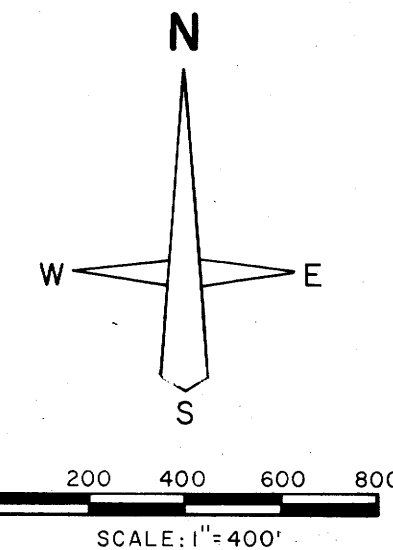

PVT.

Sec. Cor. Fd.
7/8" Steel Rod
& 4 BT's
Ref.#3

19 20
30 29

2484.0'

(Rec. S89°43'W 2635.4' Ref.#1)

2484.0'

(Rec. S89°43'W 2635.4' Ref.#1)

20 21
29 28

Sec. Cor. Fd.
1959 BC
& 4 BT's
Ref.#2

Set. 1/4 cor.
Mkd. ref. trees
Madrone 10" Brs. N34 1/4°E, 15.2'
D. Fir 6" Dia. Brs. S89°W, 25.9'

Bearings of reference trees are to the head of a spike driven into the bottom of a blaze near the base of the tree.
Distances are to side-center of the tree.
Lines between U.S. and Pvt. were blazed and yellow metal boundary tags were posted.
Bearings are based on Solar observations.

LEGEND

- ⊙ Monument found.
- Monument set, (5/8" x 24" rebar).
- Line surveyed.
- True line blazed and posted.

REFERENCE

- Ref.#1
U.S. Gov't. survey, Richmond Dickerson 1883.
- Ref.#2
Douglas County, Surveyor, 1968
- Ref.#3
R. A. Brandt, RS 841, 1969

Form 1542-4
April 1976
UNITED STATES
DEPARTMENT OF THE INTERIOR
BUREAU OF LAND MANAGEMENT
ROUTING AND TRANSMITTAL SLIP

CODE	TO NAME	ORGANIZATION	ACTION	ROOM NO.
	Virginia			

- Indicate Action by number:
1. Necessary action
 2. Approval
 3. Signature
 4. Prepare reply
 5. Your comment and return
 6. Note and surname
 7. Note and return
 8. Your information
 9. See me
 - 10.

From Terry N.	Date 9/25/87	Room No.
Office CADASTRAL SURVEYS	Phone	

Remarks
This is NOT a CADASTRAL SURVEY, was not done under the direction of a cadestral SURVEY or ~~the~~ Registered LAND SURVEYOR. It was surveyed using Theodolite & EDM with a closure, but the BLM cannot stand behind it. Terry N.

U.S.

COUNTY SURVEYORS FILE DATA
DO NOT REMOVE FROM OFFICE

(COPY ONLY FILED, AT OUR REQUEST)
FOR INFORMATION FOR SURVEY BY G. RILEY
FOR GIUSTINA BROS. (C.S. 63/61)

MAP FILE M102-20

MAP FILE M102-20