

(D) Section Corner - S7,S8,S17,S18
 FND: 2-1/2" Brass Cap (LS 1988 - 1982) with the following accessories,
 25" Fir Stump bears S 85-1/2° W 40.8 ft - open face
 46" Fir Stump bears N 27-3/4° W 29.9 ft - healed face/original BT
 45" Fir bears N 46° E, 25.3 ft healed face - original BT
 16" Fir Stump bears S 41° E 49.2 ft - open face

LEGEND

- Corner Monument Found
- Corner Set This Survey
- Aluminum Property Line Post
- ==== Blazed Property Line

NARRATIVE

The purpose of this survey was to locate and monument property corners and lines that define lands owned by International Paper Company.

The Basis of Bearing for this survey was the bearing of the line between the South East Section Corner and the East 1/4 Corner of Section 18. The bearing of this line was established by Ron Geisler (LS1988) in his 1982 survey. Refer to CS No. M 93-34.


Property lines are blazed and monumented with a 6 ft aluminum property line post, at the locations specified on this plat. Magnetic markers are buried at the base of each set aluminum post. Posts set to within ± 1 foot of true line.

Corners monumented during this survey were set per standard subdivision procedures outlined in the BLM Manual of Surveying Instruction, 1973 Edition.

This survey was performed using a NIKON NTD-2 semi total station.

Bearings and distances to bearing trees were measured with a semi total station and taken to the center of the tree at the top of the root crown. Points of measure on bearing trees are marked with a large nail.

Caps set are marked per BLM Manual of Surveying Instructions 1973 edition and stamped with LS 1091.

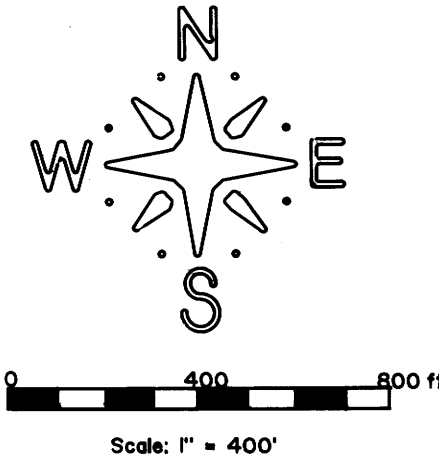

RECORD OF SURVEY
 for INTERNATIONAL PAPER COMPANY
 by WARD NORTHWEST INC.
 in Section 18, T.21S., R.11W., W.M.
 Douglas County, Oregon - 1/06/88

REGISTERED
 PROFESSIONAL
 LAND SURVEYOR
Robert B. Ward, Jr.
 OREGON
 ROBERT B. WARD, JR.
 JULY 30, 1976
 1091

WARD NORTHWEST INC.
 P.O. Box 105
 Florence, Oregon 97439

COUNTY SURVEYORS FILE DATA
DO NOT REMOVE FROM OFFICE