

COUNTY SURVEYORS FILE DATA
DO NOT REMOVE FROM OFFICE
PROPERTY LINE SURVEY

FOR
ALDEN PAKROS

IN THE S.E. 1/4 COR. OF SEC. 16, T24S, R4W, W.M.
DOUGLAS COUNTY, OREGON
JUNE 1988

FILED TF

JUL 9 1988

COUNTY SURVEYOR
DOUGLAS COUNTY, ORE.

1/4 COR.

S16 ○ S15

Fd. BLM 3 1/4" CAP MARKED:
US CADASTRAL SURVEY
1/4 COR. 16^{1/2}
T24S R4W
1963

BEARING TREES

-Fd. 32" Fir bears S 26° E 17.2'

-Fd. 36" Fir bears S 78° W 9.9'

N 00° 05' 08" E
431.87'

(SOUTH - 914.20')

This point set to mark line.

N 00° 05' 08" E
481.46'


N 00° 01' 13" E
417.95'

(SOUTH - 827.14')

N 00° 01' 13" E
408.83'

●

N 26° 34' 00" E
158.04'
(158.08)
BASIS OF BEARINGS
PER M91-2

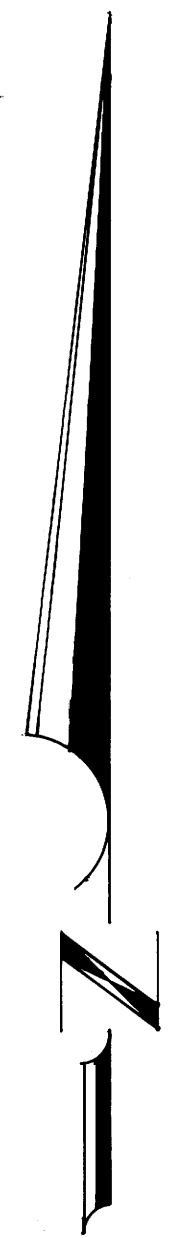

SCALE: 1"=100'

LEGEND

- SET 5/8" x 30" I.R. W/PLASTIC CAP MARKED: A A SURVEYING INC.
- FOUND 5/8" IRON ROD
- () RECORD PER M91-2

PREPARED BY:

A.A. SURVEYING SERVICE, INC.
2566 N. E. STEPHENS ST.
ROSEBURG, OREGON 97470
PH: (503) 672-2096

REGISTERED
PROFESSIONAL
LAND SURVEYOR

Mark A. Heimbürger

OREGON
JULY 16, 1987
MARK A. HEIMBURGER
2287