


COUNTY SURVEYORS FILE DATA
DO NOT REMOVE FROM OFFICE

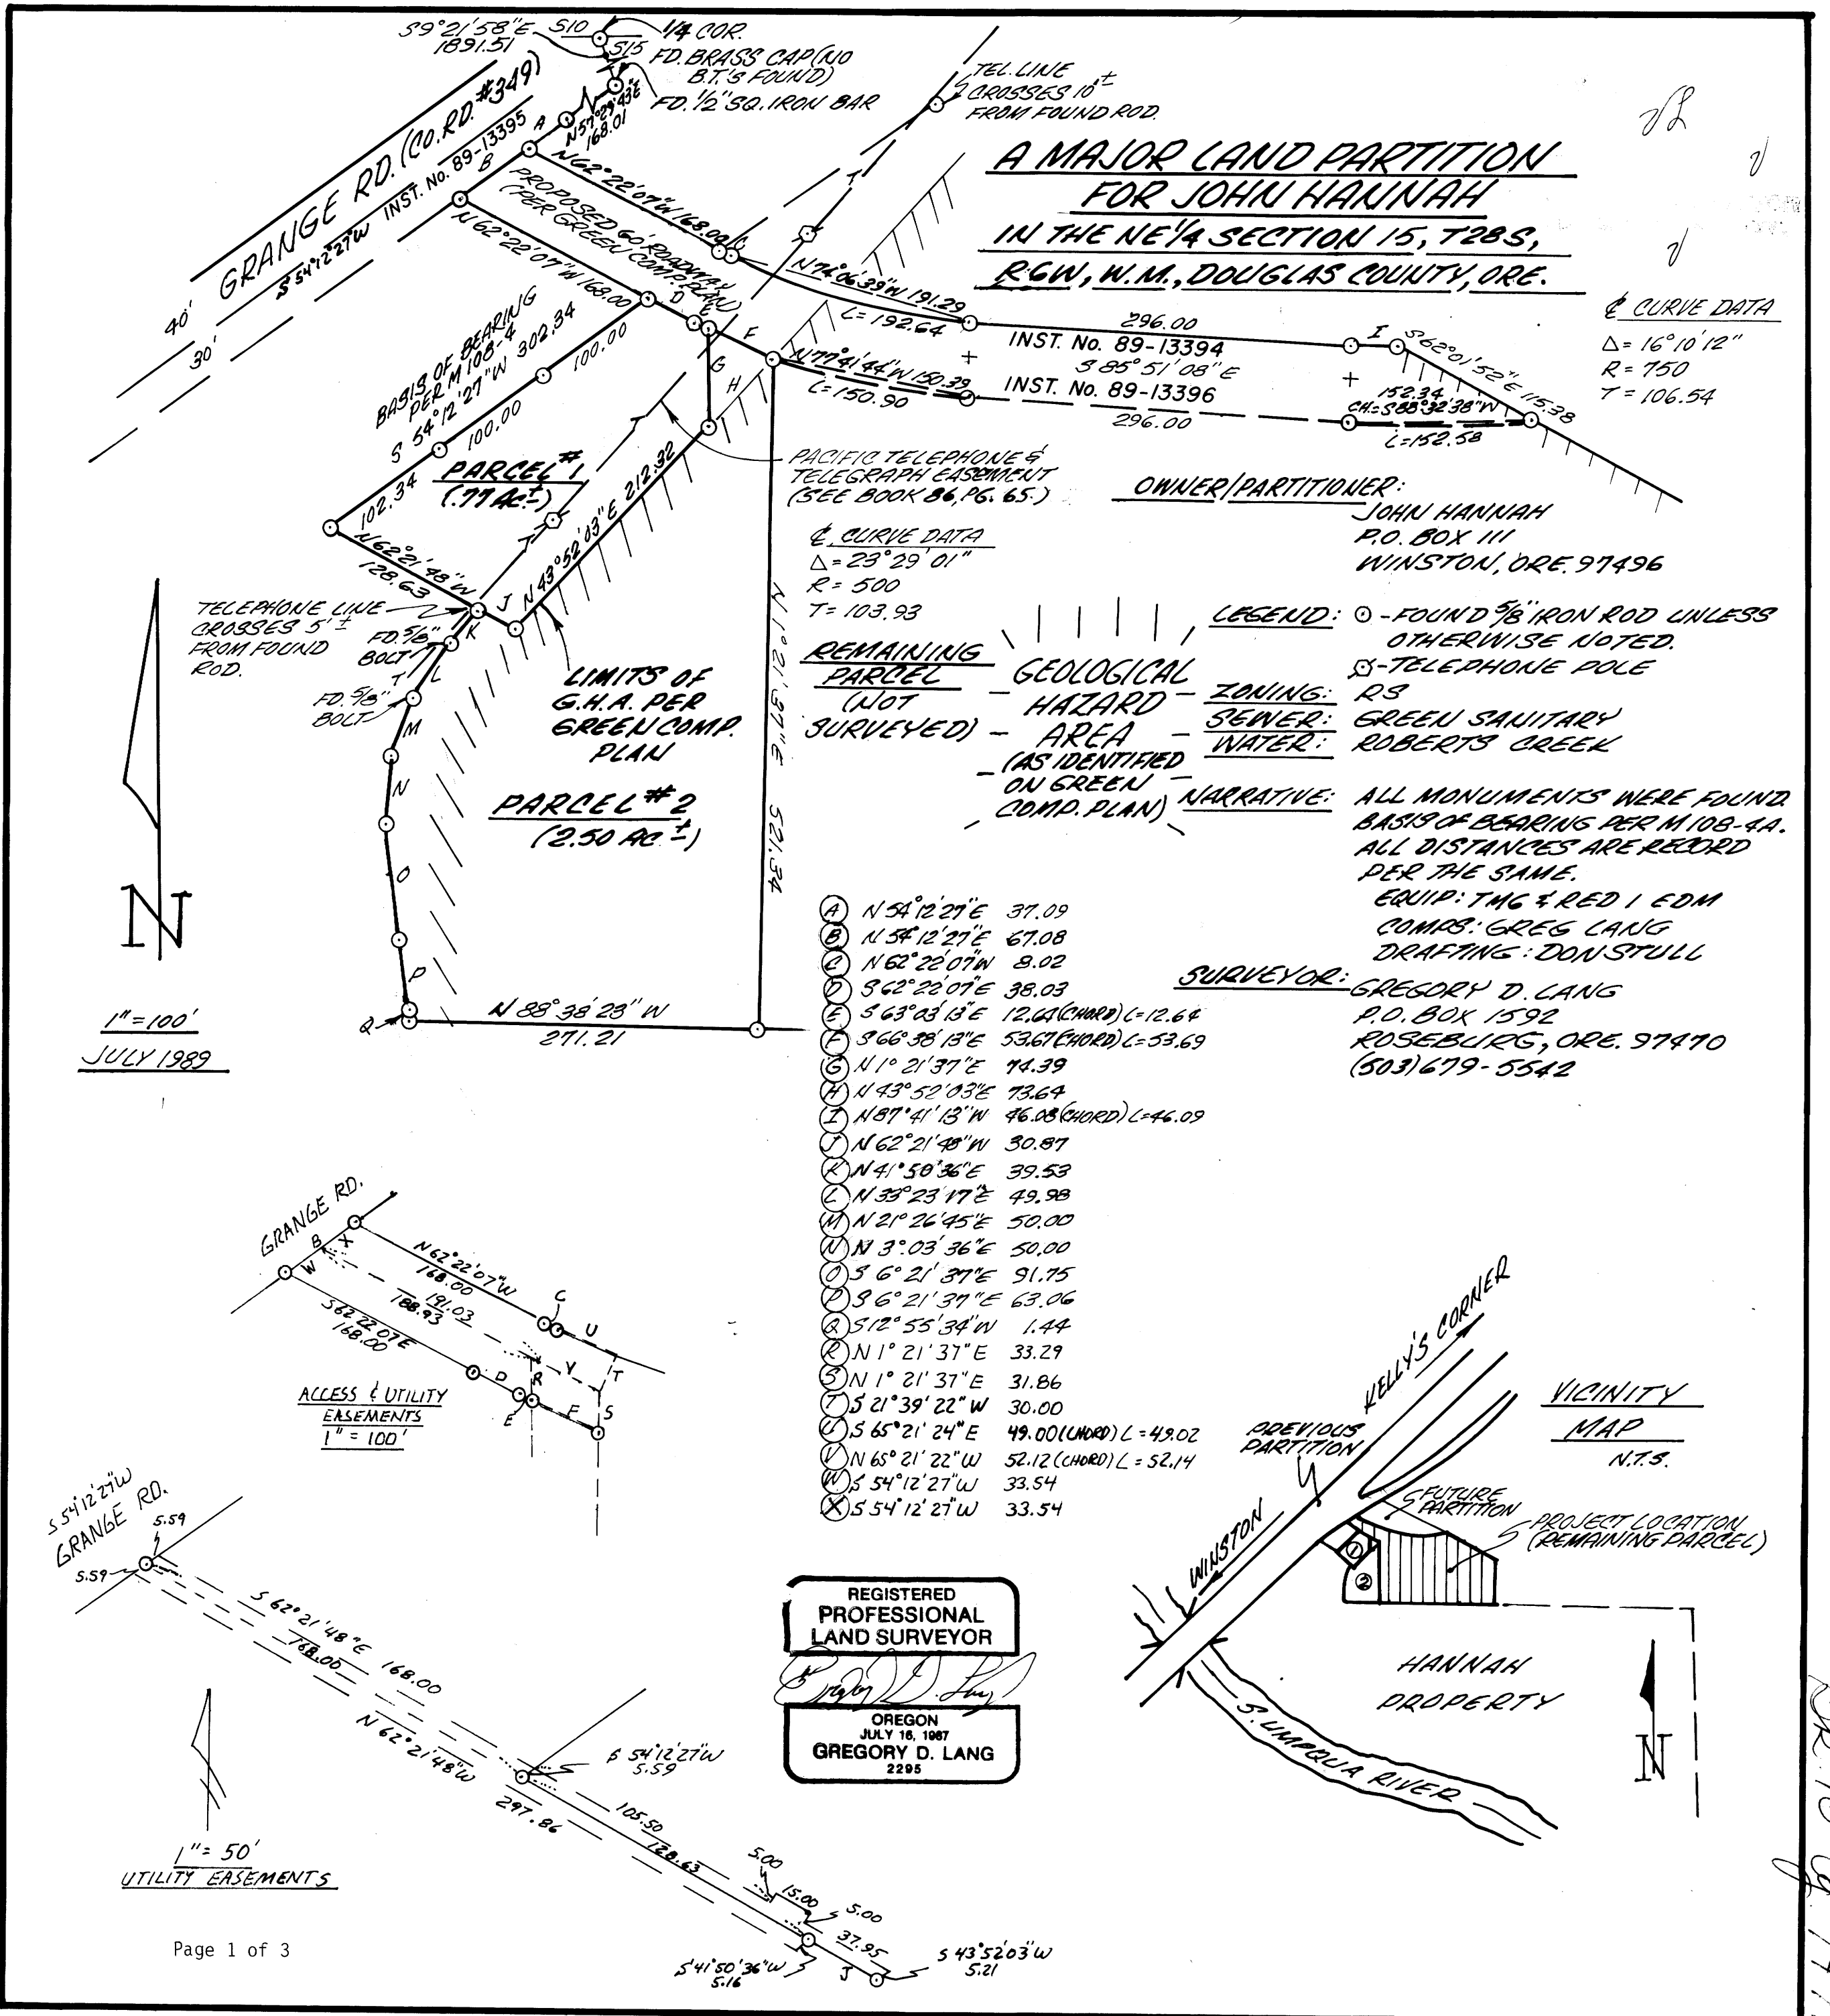

106-10-8-1477