

RESURVEY OF LINES BETWEEN SECTIONS 21, 22 & 28 T30S R6W W. M.
FOR ROSEBURG FOREST PRODUCTS


SEPTEMBER 26, 1989

FILED TF
OCT 25 1989 TF
COUNTY SURVEYOR
DOUGLAS COUNTY, ORE TF

SCALE: 1" = 200'

LEGEND

- Monument found as noted
- Set IR & alum cap marked R R Co, LS 498
- Section or property line
- - Subdivision or calculated line
- +— Line referenced to aluminum tags
- () Record data

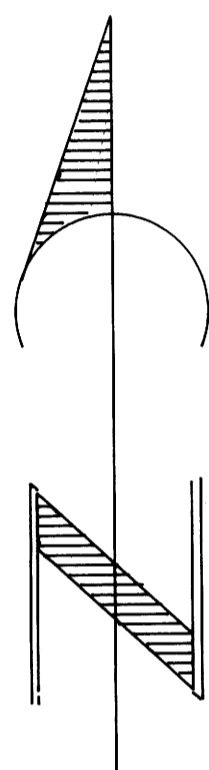

BEARING BASED ON ORIGINAL SURVEY OF
S 1/2 OF LINE BETWEEN SECTIONS 21 & 22

I ran a closed traverse in Section 28 using a Nikon NTD 4 total station. I achieved a precision of 1:134669 and adjusted the traverse by the Compass method. I set the corners by standard subdivision procedure based on the location of the existing monuments.

HOWARD W. JOHNSTONE P. O. BOX 1088 ROSEBURG, OREGON

REGISTERED
PROFESSIONAL
LAND SURVEYOR

Howard W. Johnstone

OREGON
MAY 13, 1990
HOWARD W. JOHNSTONE
498


1/4 CORNER
Fd 1963 COUNTY BCIP
BTs:
14" FIR S20°E 26.0' SNAG
8" FIR S26°W 11.2' DOWN
SCRIBED:
12" MADRONE EAST 29.0'
12" CEDAR N45°E 49.8'

S 1/16 CORNER
SET 5/8" X 48" IR & ALUM CAP
MARKED "S 1/16 21/22"
SCRIBED:
10" CEDAR N80°E 28.0'
12" FIR S64°W 21.0'

SECTION CORNER
Fd 1963 COUNTY BCIP
BTs:
44" OAK N43°W 37.1 SCRIBE VISIBLE
12" CEDAR N43°W 51.8 SCRIBE VISIBLE
16" OAK N39°E 12.5 HEALED
6" MADRONE S16°E 23.7 SCRIBE VISIBLE
11" OAK S59°W 27.5 HEALED

1/4 CORNER
Fd NO MONUMENT IN CAT TRAIL
BTs:
12" MADRONE N35°E 13.5' DEAD, SCRIBE VISIBLE
16" MADRONE S43°W 17.2' HEALED
SCRIBED:
19" MADRONE S80°E 66.0'

E 1/16 CORNER
SET 5/8" X 30" IR & ALUM CAP
MARKED "E 1/16 21/28"
SCRIBED:
8" CEDAR S2°W 21.2'
6" MADRONE N5°E 12.2'

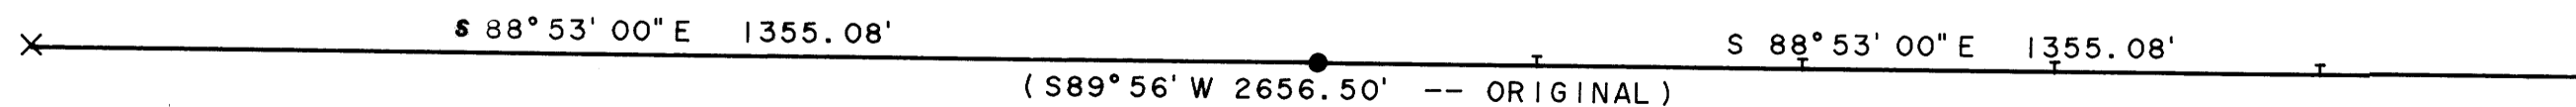

SEC 21
U S

SEC 28
ROSEBURG FOREST PRODUCTS

SEC 22
ROSEBURG FOREST PRODUCTS