

COUNTY SURVEYORS FILE DATA
DO NOT REMOVE FROM OFFICE

FILED

MAR 7 1991

COUNTY SURVEYOR
DOUGLAS COUNTY, ORE.

MAP FILE M111-57


**SURVEY TO LOCATE AGREEMENT PROPERTY LINE
ALONG PERRIN CREEK BETWEEN DEEDS # 83-12669
87-13575 IN SEC. 34, T. 28S., R. 7W., W.M. DOUG. CO.,
OREGON**

SCALE 1" = 50'

NOV, 1990

BARS 83-12669


DEED #
300916

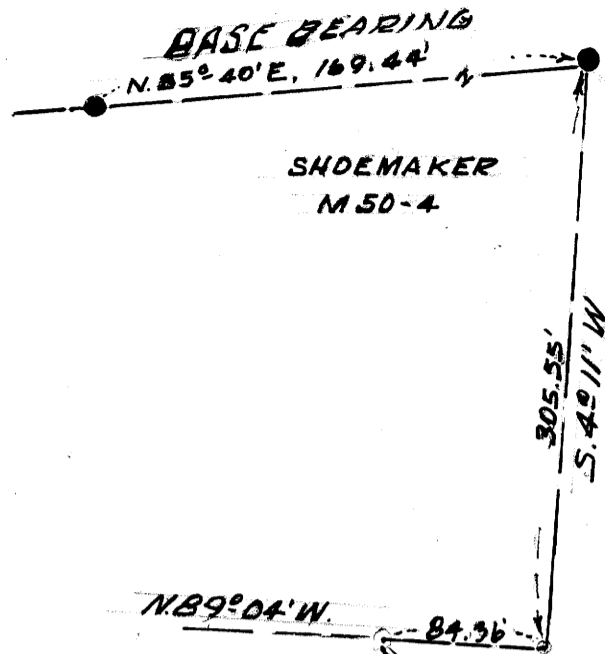

N. 89° 04' W. 84.96'

305.55'
5.4911' W

SHDEMAKER
M50-4

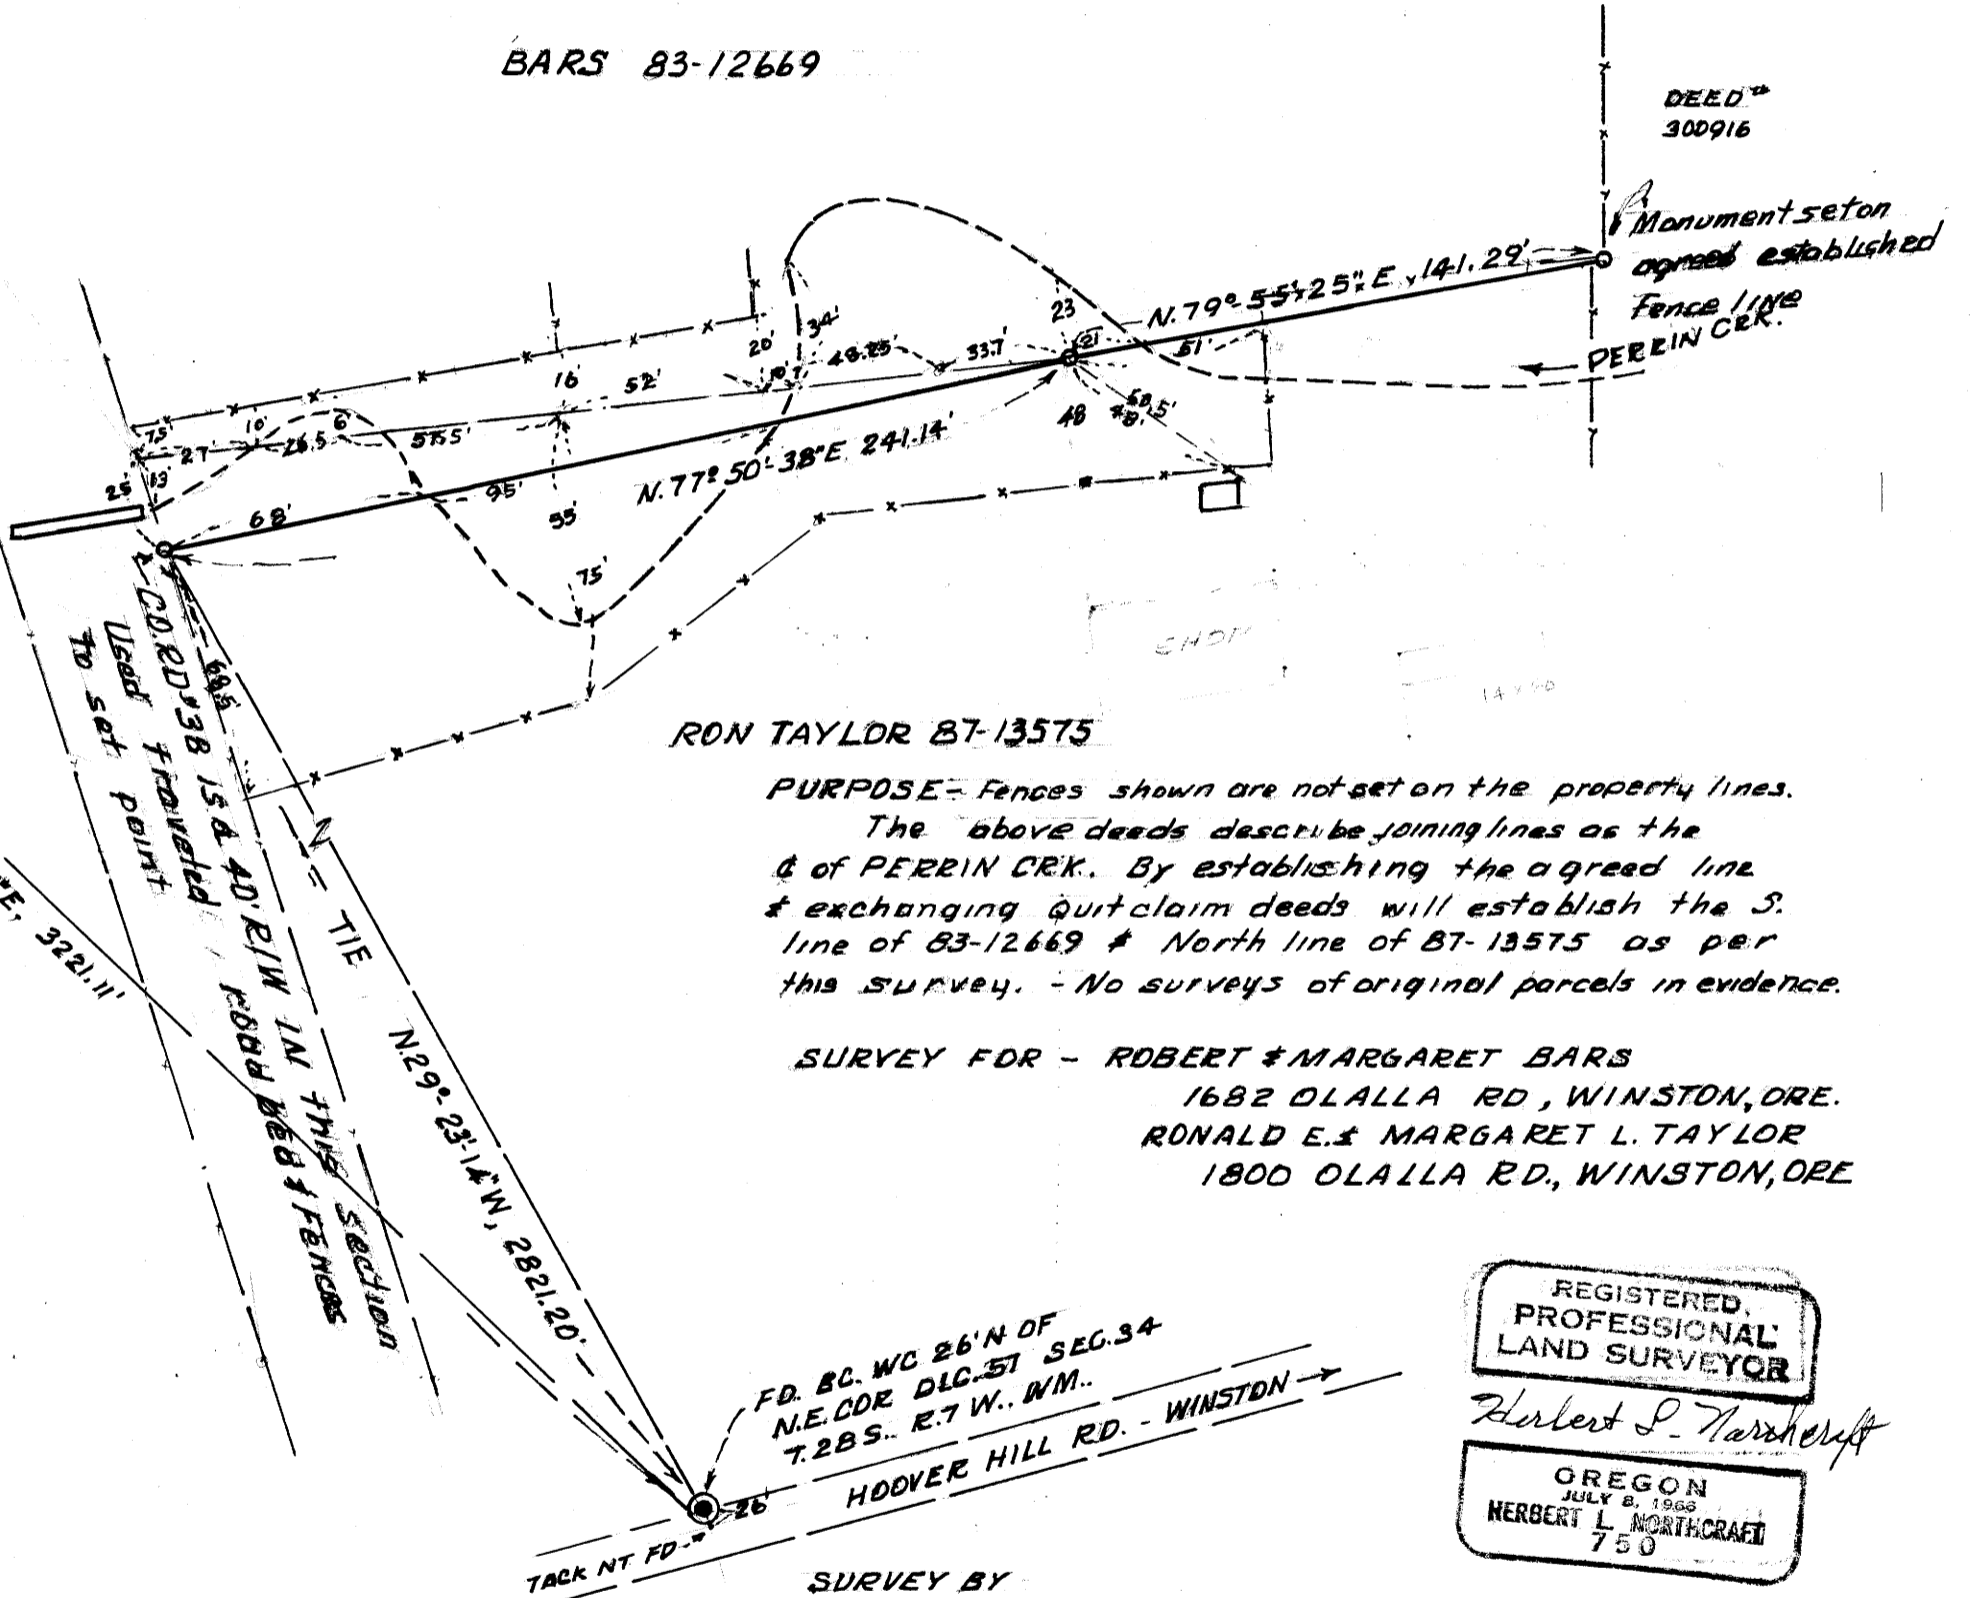

RON TAYLOR 87-13575

PURPOSE: Fences shown are not set on the property lines.
The above deeds describe joining lines as the
of PERRIN CRK. By establishing the agreed line
& exchanging quitclaim deeds will establish the S.
line of 83-12669 & North line of 87-13575 as per
this survey. - No surveys of original parcels in evidence.

SURVEY FOR - ROBERT & MARGARET BARS
1682 OLALLA RD, WINSTON, ORE.
RONALD E. & MARGARET L. TAYLOR
1800 OLALLA RD, WINSTON, ORE

FD. BC. WC 26' N OF
N.E. COR. D1C. 57 SEC. 34
T. 28S. R. 7W. W.M.

HOOPER HILL RD. - WINSTON

REGISTERED
PROFESSIONAL
LAND SURVEYOR

Herbert L. Northcraft

OREGON
JULY 8, 1968
HERBERT L. NORTHCRAFT
750

SURVEY BY

HERBERT L. NORTHCRAFT
3520 OLALLA RD.
WINSTON, ORE 97496
PH 679-8692

- BASE - M50-4, N 85° 40' E
- FD. 5/8" I.R.
 - SET 5/8" x 30" I.R. MKD L.S. 7.50
 - ⊙ FD. WIT. COR. - BC.

MAP FILE M111-57