


ISSAQUAH

TWIN ACRES

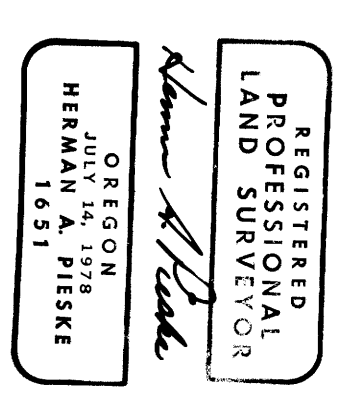

**RECORD OF SURVEY**  
for  
**CITY OF ROSEBURG**  
In the NE 1/4 of Section 14, T27S, R6W, WM  
STATION 21+00 to 32+50

Map Prepared By:  
AA Surveying, Inc.  
2366 N. Stephens  
Roseburg, Oregon 97470  
Tel. (503) 672-2096

Date: December, 1990  
Drawn By: dlc  
Page: 2 of 2

COUNTY SURVEYORS FILE DATA  
DO NOT REMOVE FROM OFFICE