


67-211W

COUNTY SURVEYORS FILE DATA  
DO NOT REMOVE FROM OFFICE

LEGEND

- Section corner found (as noted)
- 1/4 section corner set (as noted)
- Property line marked with blazes and red paint

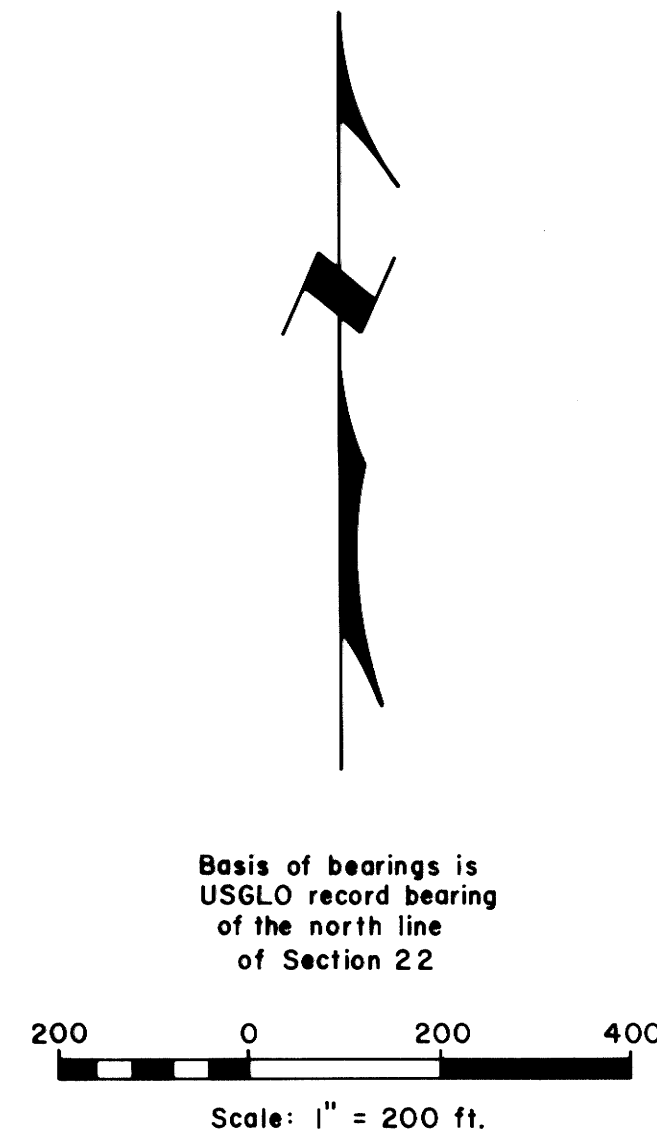

16 | 15  
21 | 22

Fd. a 3 1/4" alum. cap on a 2 1/2" alum. pipe marked "T 31 S, R 5 W, S 15, S 16, S 21, S 22 1982 USBLM"  
From which a:

Orig. basalt corner stone 14" x 10" x 8" sets alongside alum. cap, both in a mound of stone.

30" cedar BT  
Snag, no face visible  
Bears N61°E, 21.1 ft.

10" madrone BT  
Scribes visible  
Bears N33°E, 26.7 ft.

10" madrone BT  
Healed face  
Bears S53°E, 8.2 ft.

10" madrone BT  
Healed face  
Bears S84°W, 35.6 ft.

8" live oak BT  
Scribes visible  
Bears N73°W, 16.2 ft.

Spur road

2,738.93

S89°27'00"W, 5,477.85 (USGLO record), S89°27'00"W, 5,311.68, basis of bearings)

Natural gas pipeline road  
PP&L powerline road

1/4 S  
15

22

1/4 S  
15

22

1/4 S  
15