


PROPERTY LINE ADJUSTMENT  
SURVEY IN SE 1/4  
SECTION 33 T29S R5W WM

for  
Dale Greenly  
and  
Les Bovee

FILED  
OCT 16 1991  
COUNTY SURVEYOR  
MYRTLE CREEK, OR

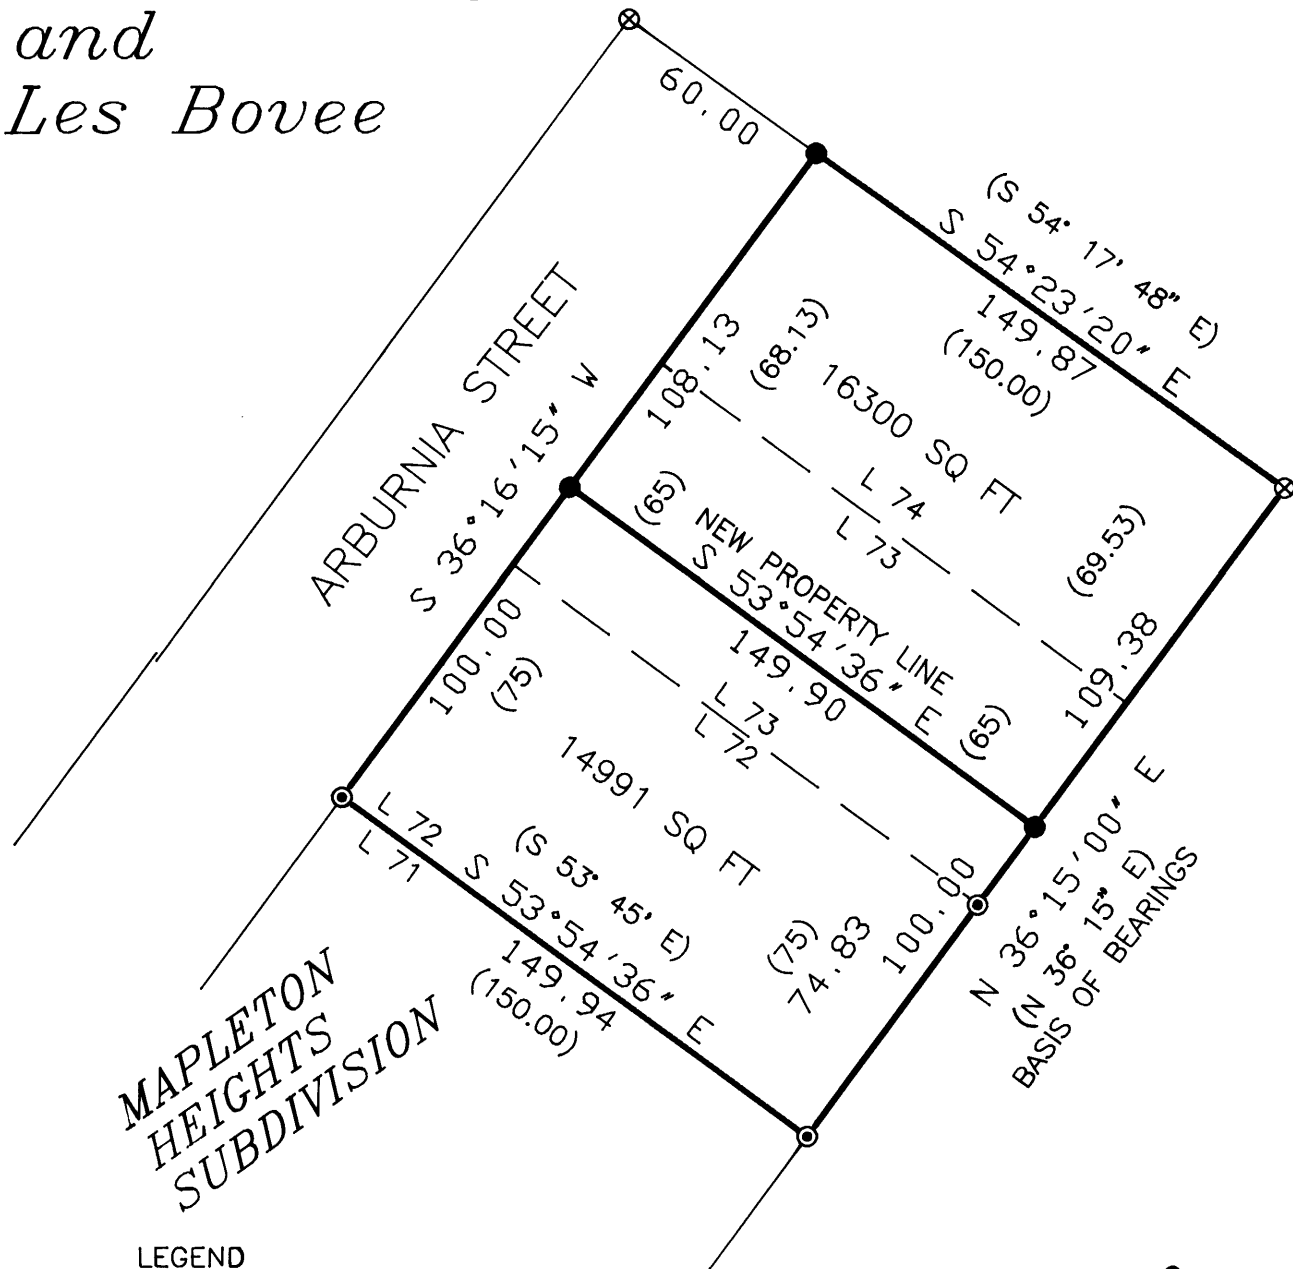


SCALE 1" = 50'

- LEGEND
- ⊗ FOUND 5/8" IRON ROD
  - ⊙ FOUND 1/2" IRON ROD
  - SET 5/8" X 30" IRON ROD WITH 3/4" BRASS WASHER MARKED LS 866
  - ( ) RECORD

SURVEY NARRATIVE: SURVEY IS BASED ENTIRELY ON MAPLETON HEIGHTS SUBDIVISION.  
EQUIPMENT: LIETZ T60D THEODOLITE, MAC II EDM AND 100 FOOT STEEL TAPE.

*Keith L. Cubie* 10/16/91  
PLANNING DIRECTOR DATE

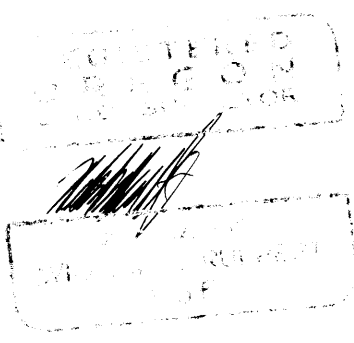

SURVEYED BY:  
WILLIAM J. RUPPERT  
P.O. BOX 1564  
MYRTLE CREEK, OR 97457  
OCTOBER 1991