


REGISTERED OREGON LAND SURVEYOR

Donald A. Bentz

JULY 12, 1958
DONALD A. BENTZ
839

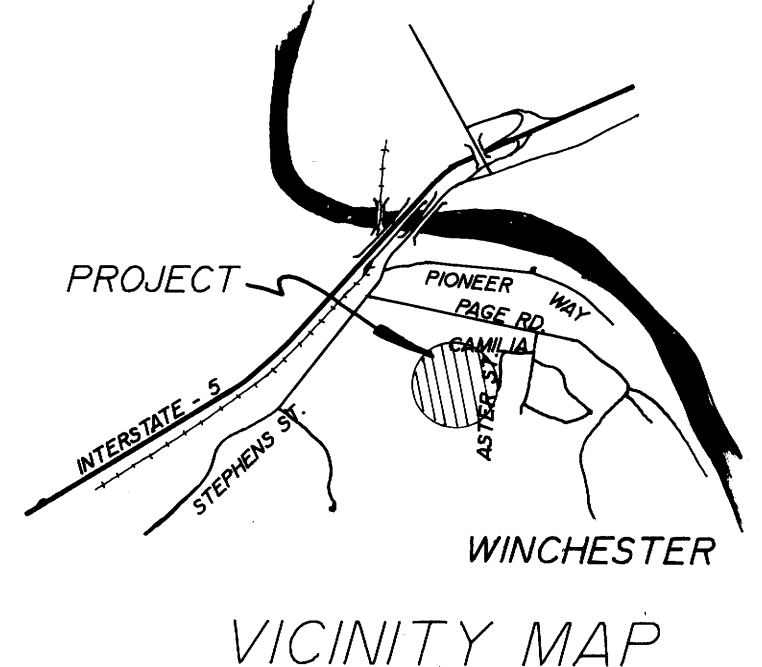

NARRATIVE:

LOT LINE ADJUSTMENT TO MAKE PARCEL 1 MORE PROPORTIONATE. USED EXISTING MONUMENTS TO SET MOST NORTHERLY AND USED EXISTING MONUMENTS TO EXTEND THE WESTERLY LINE ALONG MARTHA DRIVE

FIELD CREW: M. HOLT, T. GRAHAM
 OFFICE: A. TEITZEL
 DRAFTING: M. RADCLIFFE
 REF. MAPS: SADDLE BUTTE ESTATES 3rd. ADDITION VOL. 17, PG. 41

- LEGEND:
- FD. 5/8" I.R. UNLESS OTHERWISE NOTED
 - SET 5/8"x30" I.R. W/CAP MARKED "i.e. ENGINEERING"

COMP. PLAN: LOW DENSITY RESIDENTIAL ZONE: R-1

APPROVALS:

Keith L. Cubic 12/11/91
 DO. CO. PLANNING DIRECTOR DATE

		LOT LINE ADJUSTMENT IN THE SW 1/4 OF THE NW 1/4 AND THE NW 1/4 OF THE SW 1/4 OF SEC. 30, T26S, R5W, W.M., DOUGLAS COUNTY, OREGON.	
		SURVEYED FOR: LEIKEN CONSTRUCTION CO. 859 W LOOKINGGLASS RD. ROSEBURG, OR. 97470	SURVEYED BY: i.e. ENGINEERING 1205 SE COURT ROSEBURG, OR. 97470 (503) 673-0166
SCALE: 1" = 50'	DATE: NOV. 1991	PAGE: 1 OF 1	

COUNTY SURVEYORS FILE DATA
 NOT REMOVE FROM OFFICE